


ASPECT CHARTS

						Designed By: BPC	TTCI TTCI ASPECT CHARTS COVER SHEET	Scale: NTS	
						Drawn By: BPC		CADD File Name: TTCI000.DWG	
						Checked By: BDW		Submitted Date: 02/09/15	
						Approved By: AEB			
								Sheet No. 000	
1	07/22/16	AS-IN SERVICE							
REV	DATE	DESCRIPTION							

NOTES:
1. IN CAB TEST MODE SIGNALS 212 AND 101 WILL DISPLAY R/R REGARDLESS OF THE CODES BEING RECEIVED ON THE ADJACENT TRACKS.

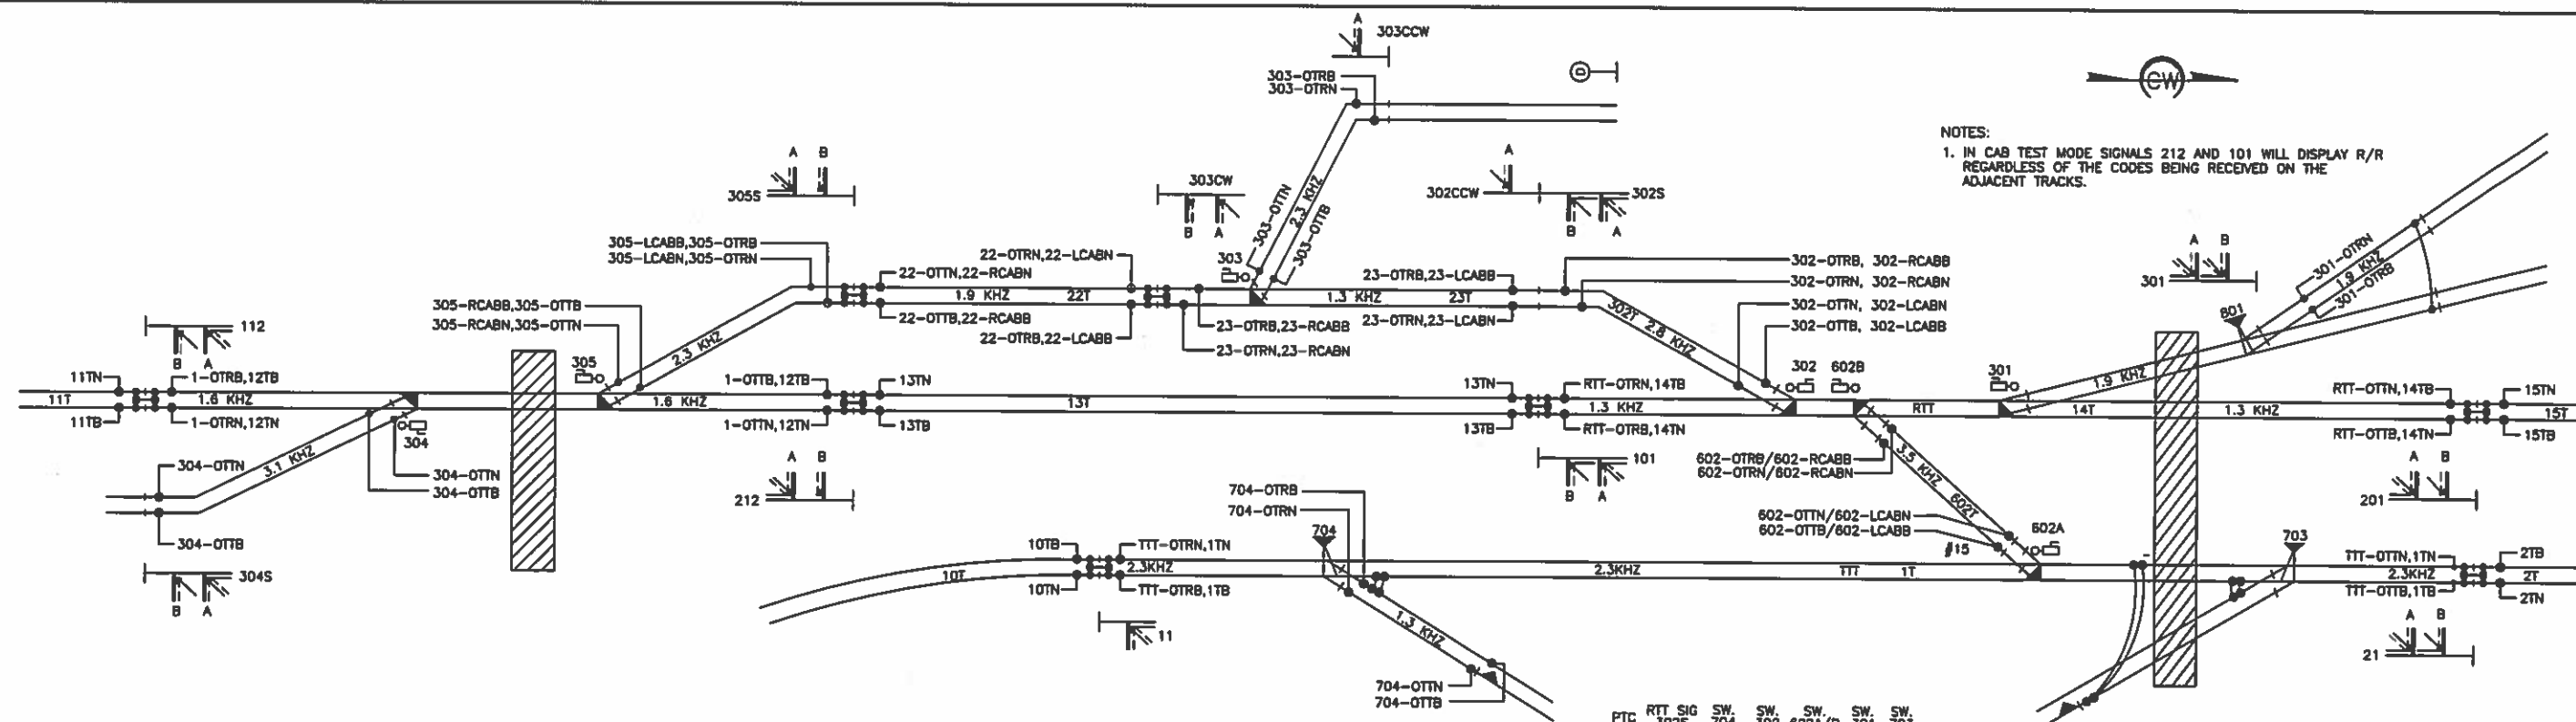

PTC	SIGNAL	SW.	SW.
112	304	305	
(A) 8	15	R/R	N
(AM?) 9	13	R/R	N
(AM?) 2	12	R/Y	N
(CS80) 3	8	Y/R	N
(CS80) 3	10	Y/Y	N
(CS80) 3	7	Y/Y	N
(CS80) 4	6	FY/R	N
(C125) 7	6	FY/R	N
(C150) 7	3	G/R	N

PTC	SIGNAL	SW.	SW.
304S	304	305	
15	R/R	R	R
13	R/R	R	R
12	R/Y	R	R
8	Y/R	R	N
10	Y/Y	R	N
7	Y/Y	R	N
6	FY/R	R	N
6	FY/R	R	N
3	G/R	R	N

RTT CAB RATE TABLE		
	DESIGNATOR	RATE
CLEAR (150)	C150	180/180
CLEAR (125)	C125	180/-
CAB SPEED (80)	CS80	120/120
CAB SPEED (60)	CS60	270/-
APPROACH MEDIUM (?)	AM?	75/75
APPROACH LIMITED (?)	AL?	120/-
APPROACH	A	75/-

TTT CAB RATE TABLE		
	DESIGNATOR	RATE
CLEAR (80)	C	180
CAB SPEED	CS	270
APPROACH LIMITED (?)	AL?	120
APPROACH	A	75
RESTRICTING	R	NO CAB

PTC	RTT	SIG	SW.	SW.	SW.	SW.	SW.
			704	302	602A/B	301	703
(A) 2	15	R/R	R	R	N	N	N
(A) 2	15	R/R	R	R	N	N	N
(AL?) 8	12	R/Y	R	R	N	N	N
(AL?) 8	11	R/FY	R	R	N	N	N
(AL?) 8	9	R/G	R	R	N	N	N
(A) 8	13	R/FR	R	R	N	N	N
(AL?) 8	7	Y/R	R	R	N	N	N
(AL?) 8	6	FY/R	R	R	N	N	N
(AL?) 8	3	G/R	R	R	N	N	N
(AL?) 8	3	G/R	R	R	N	N	N

PTC	RTT	SIG	SW.	SW.	SW.	SW.	SW.
			704	302	602A/B	301	703
(A) 8	15	R/R	N	R	N	N	N
(A) 8	15	R/R	N	R	N	N	N
(AL?) 2	9	R/G	N	R	N	N	N
(AL?) 2	11	R/FY	N	R	N	N	N
(AL?) 2	12	R/Y	N	R	N	N	N
(AM?) 9	13	R/FR	N	R	N	N	N
(CS80) 3	7	Y/R	N	R	N	N	N
(CS80) 4	6	FY/R	N	R	N	N	N
(C125) 7	6	FY/R	N	R	N	N	N
(C150) 7	3	G/R	N	R	N	N	N
(C150) 7	3	G/R	N	R	N	N	N

TTT	SIG	SW.	SW.	SW.	SW.	SW.
		704	302	602A/B	301	703
(A) 8	R	N	N	N	N	N
(A) 8	R	N	N	N	N	N
(A) 8	R	N	N	N	N	N
(R) 2	R	N	N	N	N	N
(A) 8	FR	N	N	N	N	N
(CS) 4	Y	N	N	N	N	N
(C) 7	FY	N	N	N	N	N
(C) 7	G	N	N	N	N	N

OS CAB ON CROSSOVER MOVES		
	(A)	(A)
(A) 8	8	8
(AL?) 4	(CS)	4
(AL?) 7	(C)	7


FROM RTT LOCATION T-2		
	(A)	(A)
(A) 8	8	8
(CS80) 3	(CS)	3
(CS80) 4	(CS)	4
(C125) 9	(C)	9
(C150) 7	(C)	7

FROM TTT LOCATION T-2		
	(R)	(A)
(R) 2	2	2
(A) 8	8	8
(CS) 4	(CS)	4
(C) 7	(C)	7


CAB RATE TABLE		
	DESIGNATOR	RATE
CLEAR (150)	C150	180/180
CLEAR (125)	C125	180/-
CAB SPEED (80)	CS80	120/120
CAB SPEED (60)	CS60	270/-
APPROACH LIMITED (?)	AL?	120/-
APPROACH MEDIUM (?)	AM?	75/75
APPROACH	A	75/-



NOTES:
1. IN CAB SIGNALING MODE, SIGNALS AT IC2 THROUGH IC11 WILL BE DARK.

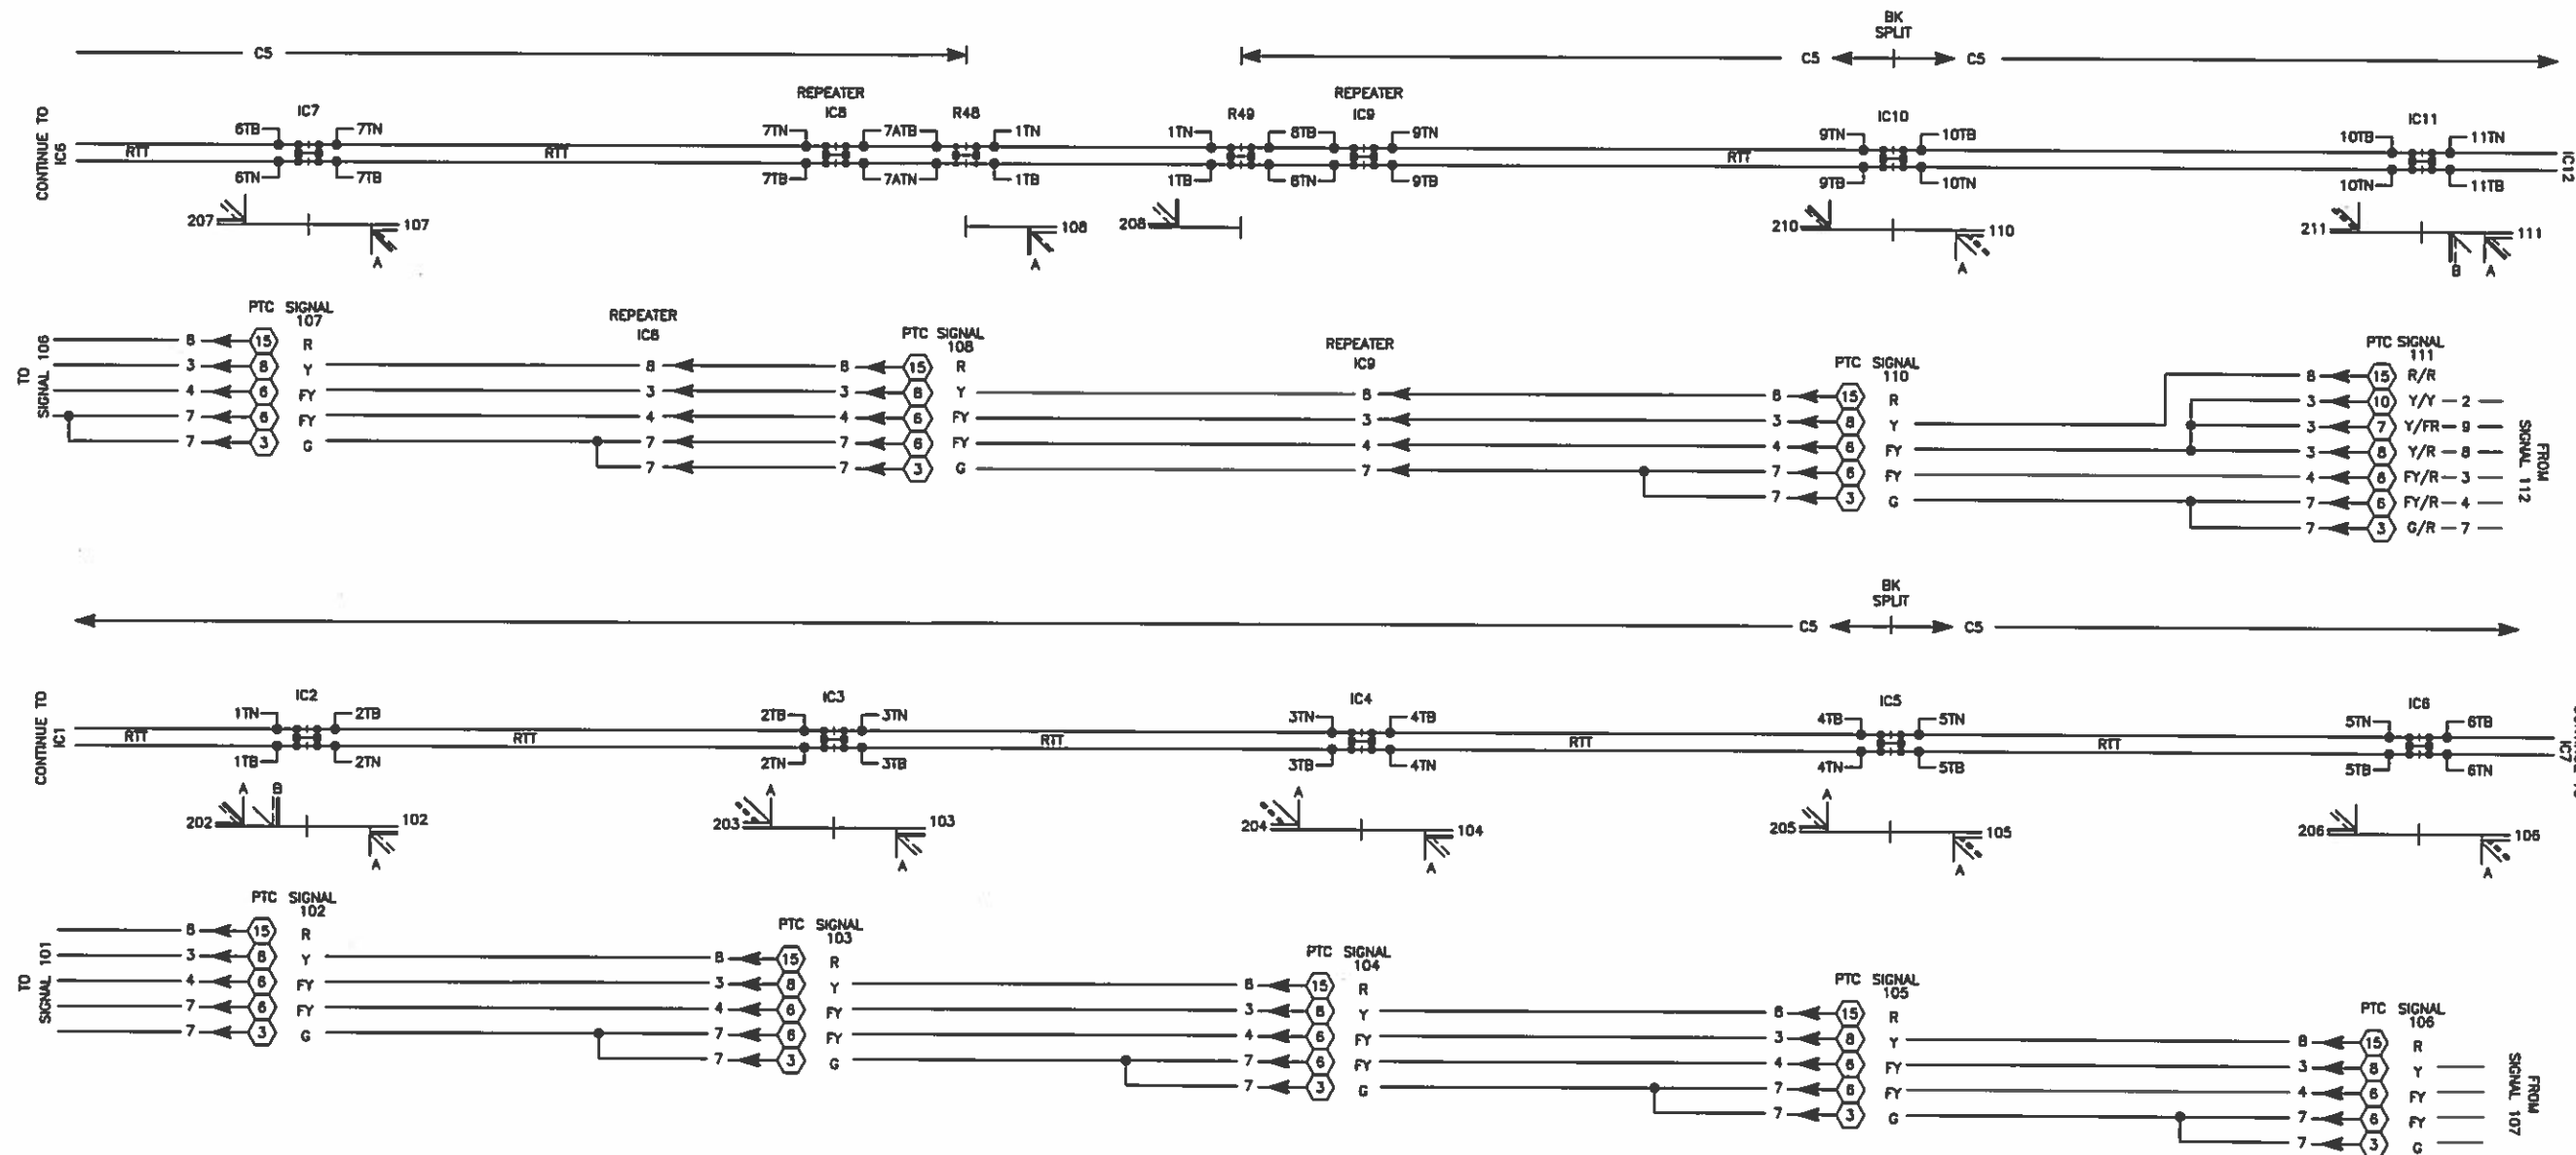

			 ALSTOM TRANSPORT INFORMATION SOLUTIONS		Designed By:	TTCI CLOCKWISE ASPECTS AT RTT INTERMEDIATE & HOLDOUT SIGNALS (SIGNAL MODE)	Scale:	NTS
					Drawn By:		CADD File Name:	TTCI003.DWG
					Checked By:		Submitted Date:	11/26/2014
					Approved By:			
1	07/22/16	AS-IN SERVICE						
REV	DATE	DESCRIPTION						

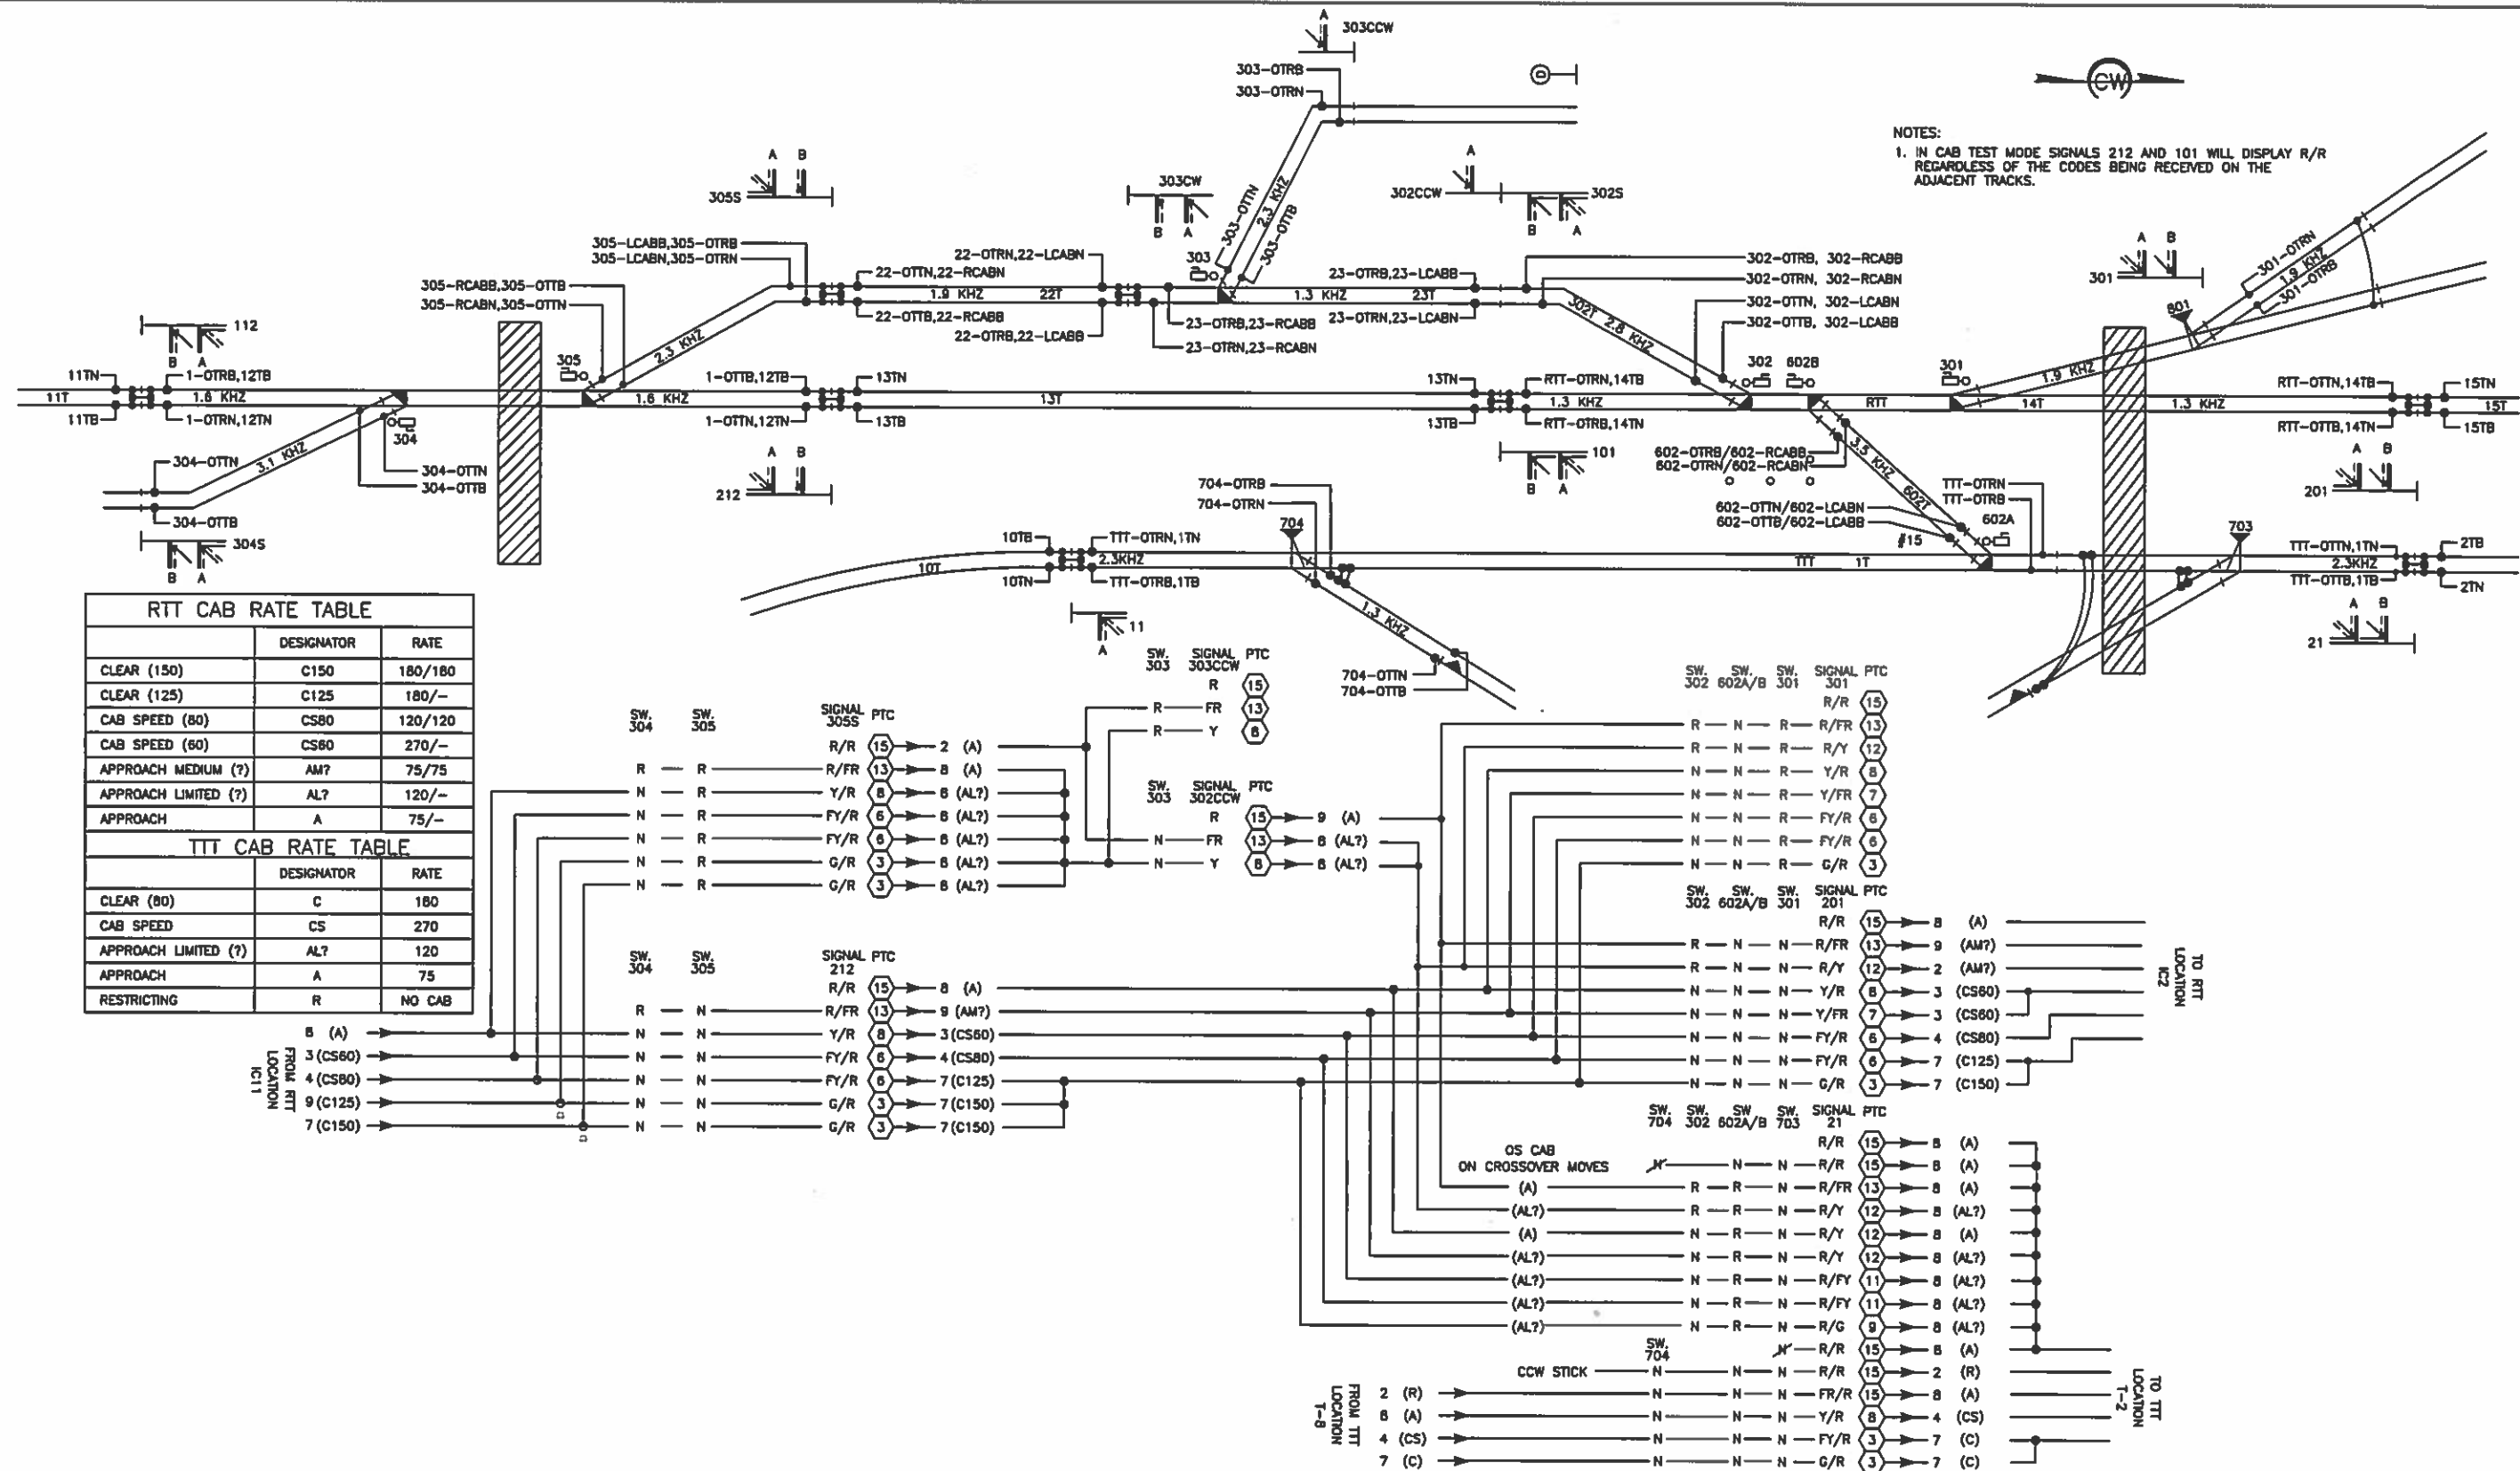

NOTES:
1. IN CAB TEST MODE SIGNALS 212 AND 101 WILL DISPLAY R/R REGARDLESS OF THE CODES BEING RECEIVED ON THE ADJACENT TRACKS.

RTT CAB RATE TABLE		
	DESIGNATOR	RATE
CLEAR (150)	C150	180/180
CLEAR (125)	C125	180/-
CAB SPEED (80)	CS80	120/120
CAB SPEED (60)	CS60	270/-
APPROACH MEDIUM (?)	AM7	75/75
APPROACH LIMITED (?)	AL7	120/-
APPROACH	A	75/-
TTT CAB RATE TABLE		
	DESIGNATOR	RATE
CLEAR (80)	C	180
CAB SPEED	CS	270
APPROACH LIMITED (?)	AL7	120
APPROACH	A	75
RESTRICTING	R	NO CAB

FROM RTT LOCATION IC11

FROM TTT LOCATION 1-8

TO RTT LOCATION IC2

TO TTT LOCATION 1-2

1

07/22/16

AS-IN SERVICE

REV

DATE

DESCRIPTION

ALSTOM

ALSTOM TRANSPORT

INFORMATION SOLUTIONS

Designed By:

BPC

Drawn By:

SAT

Checked By:

BDV

Approved By:

AEB

TTCI

COUNTER CLOCKWISE ASPECTS

AT RTT/TTT SIGNALS

201, 212, 301, 302CCW, 303CCW,

305S & 602

Scale:

NTS

CADD File Name:

TTCI005.DWG

Submitted Date:


11/26/14

Sheet No.

005



NOTES:
1. IN CAB SIGNALING MODE, SIGNALS AT IC2 THROUGH
IC11 WILL BE DARK.

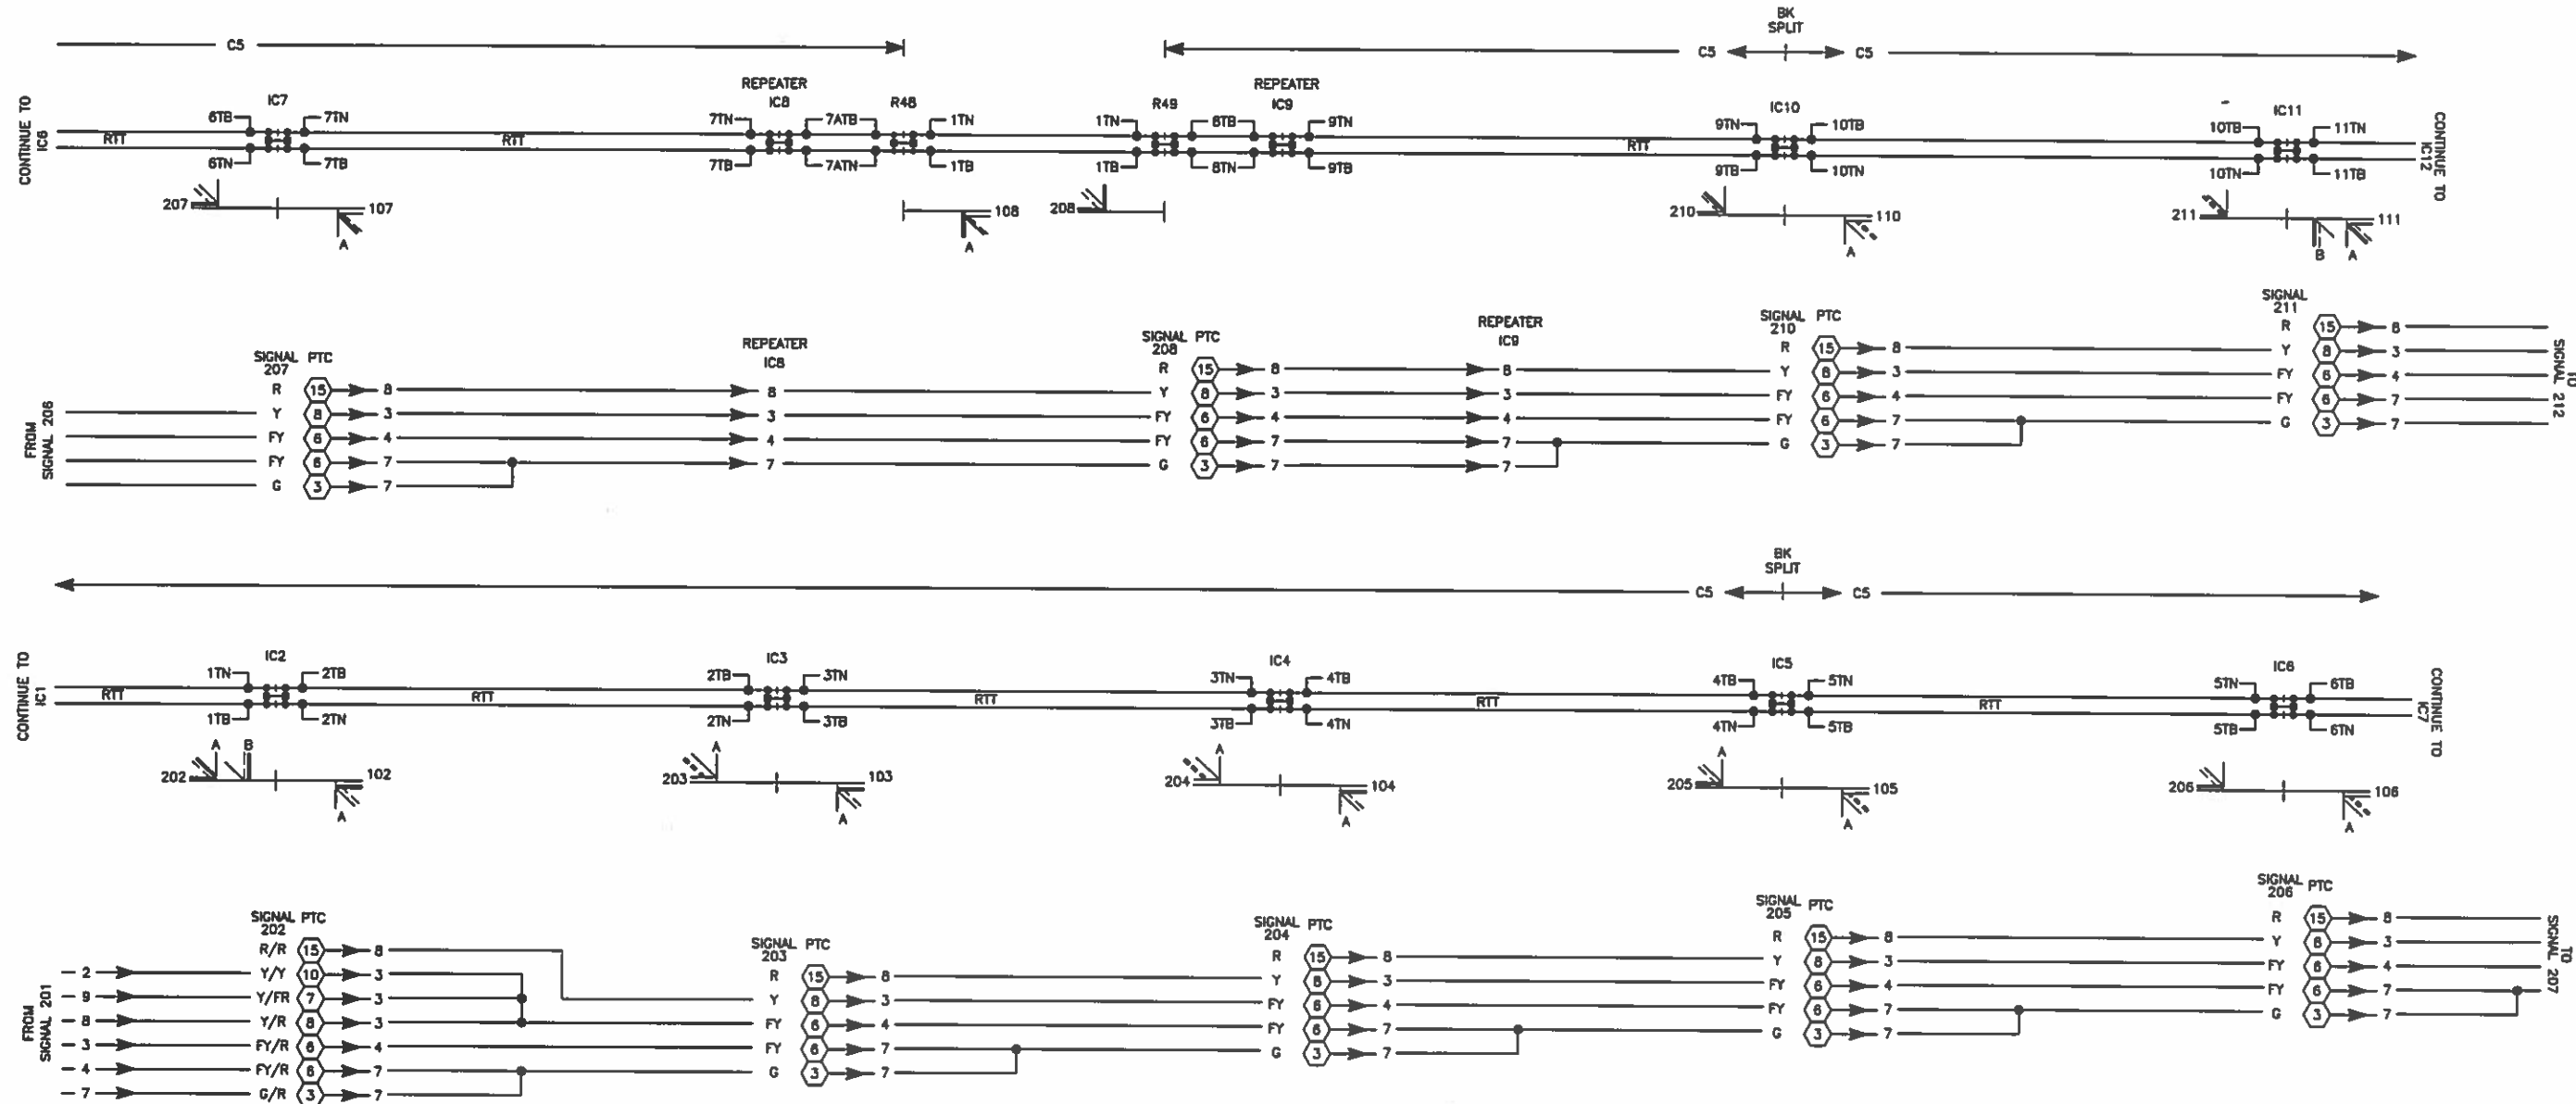


					Designed By:	BPC	TTCI	Scale:	NTS
					Drawn By:	SAT		CADD File Name:	TTCI006.DWG
					Checked By:	BDV		Submitted Date:	11/26/14
					Approved By:	AEB			
1	07/22/16	AS-IN SERVICE			COUNTER CLOCKWISE ASPECTS AT RTT INTERMEDIATE & HOLDOUT SIGNALS (SIGNAL MODE)				
REV	DATE	DESCRIPTION						Sheet No.	006

CAB RATE TABLE		
	DESIGNATOR	RATE
CLEAR (150)	C150	180/180
CLEAR (125)	C125	180/-
CAB SPEED (80)	CS80	120/120
CAB SPEED (60)	CS60	270/-
APPROACH LIMITED (?)	AL?	120/-
APPROACH MEDIUM (?)	AM?	75/75
APPROACH	A	75/-



NOTES:
1. IN CAB SIGNALING MODE, SIGNALS AT IC2 THROUGH IC11 WILL BE DARK.

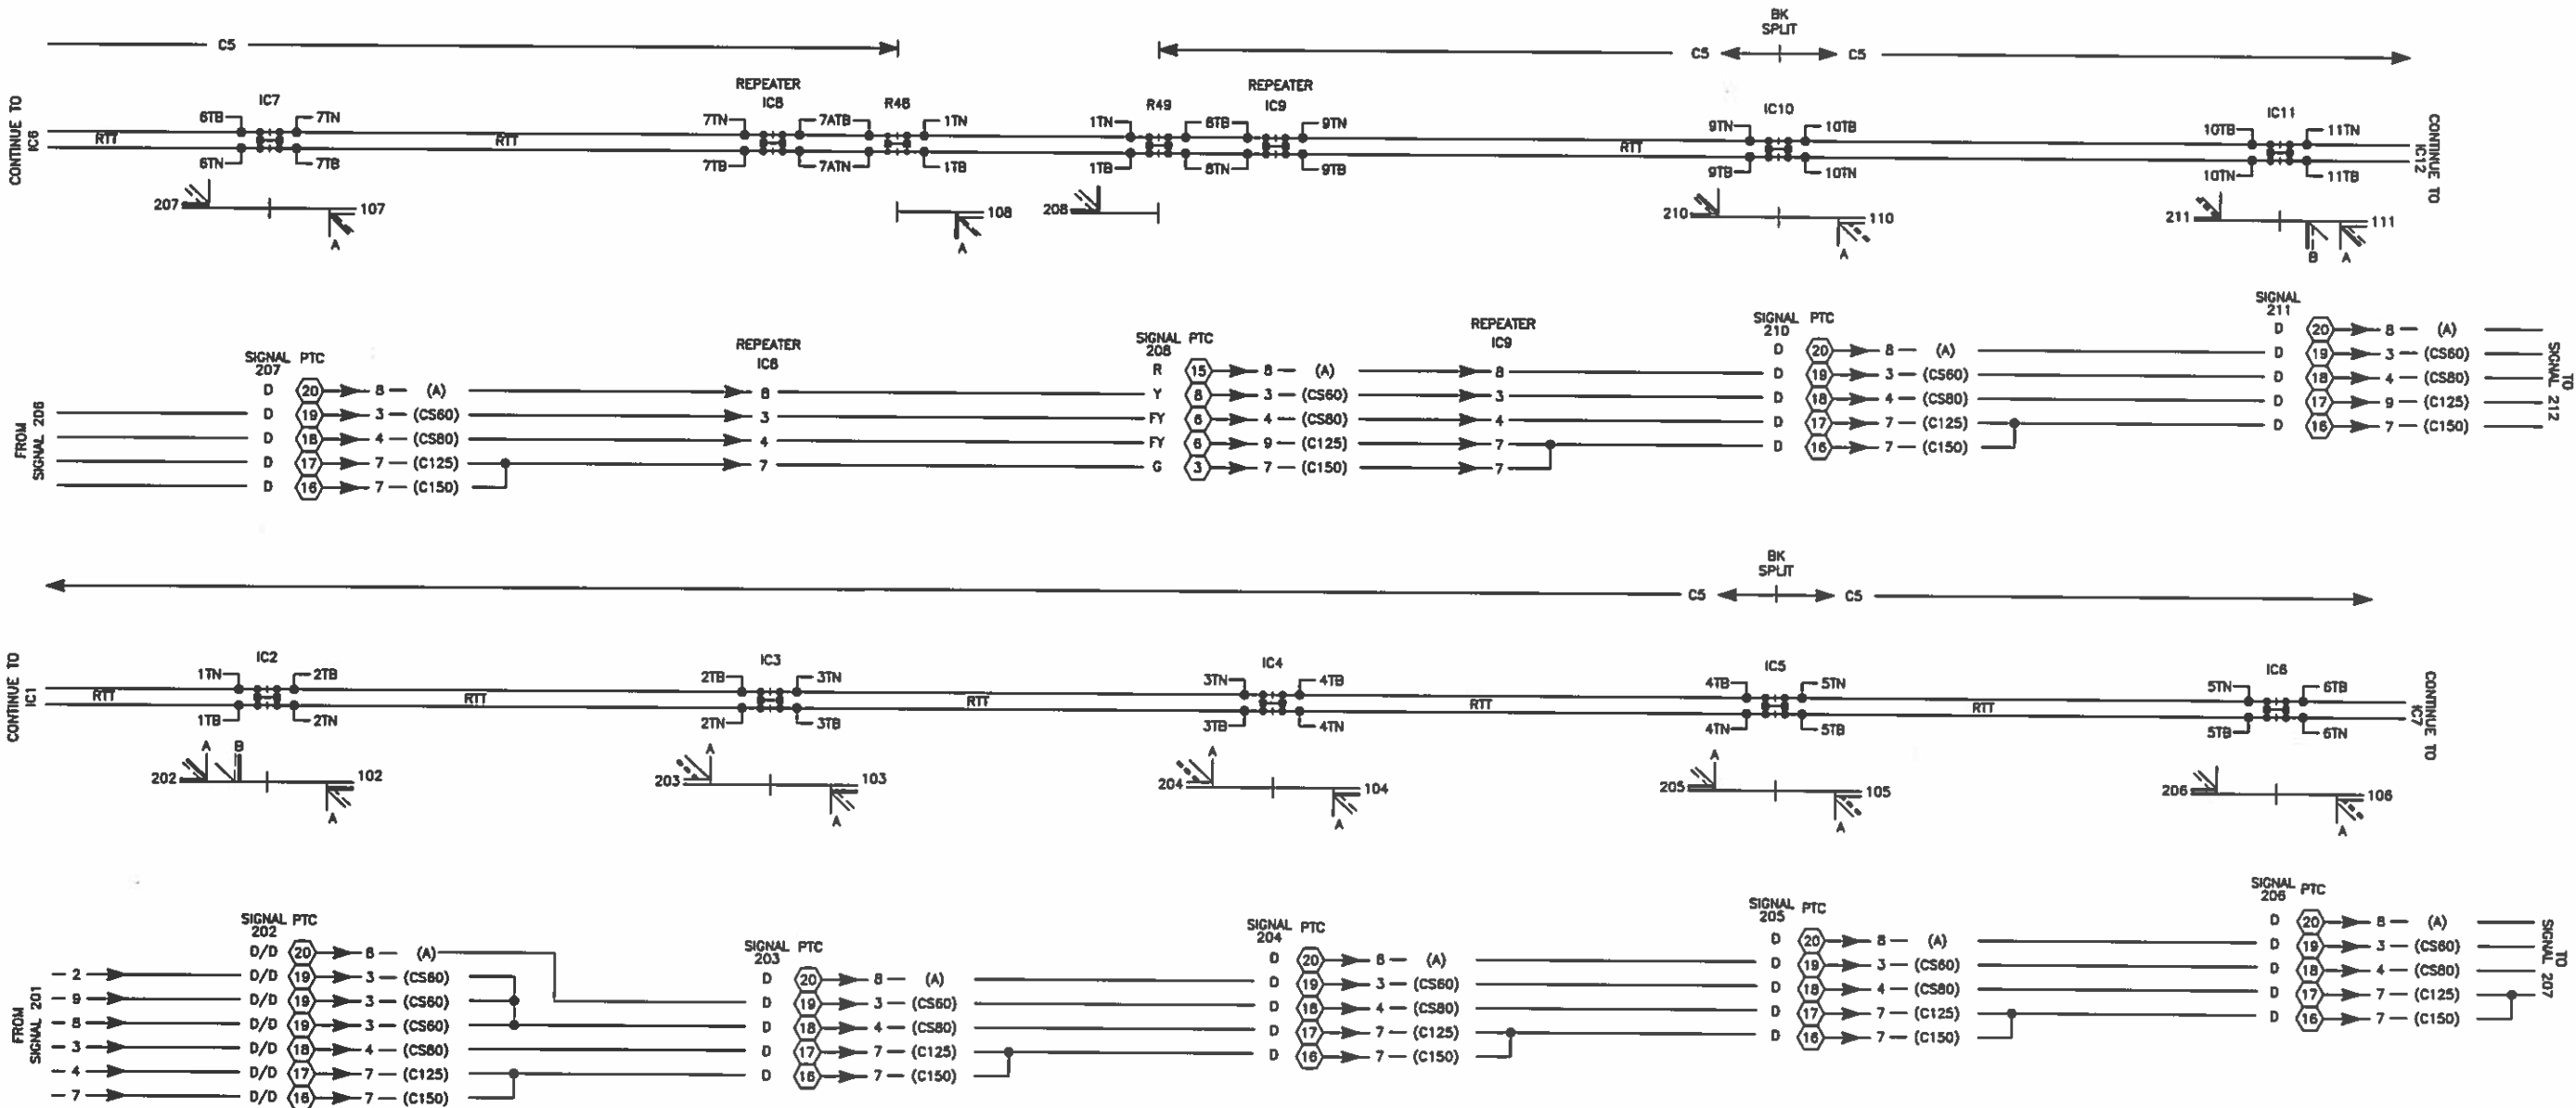

1 07/22/16 AS-IN SERVICE REV DATE DESCRIPTION			ALSTOM ALSTOM TRANSPORT INFORMATION SOLUTIONS		Designed By: BPC Drawn By: SAT Checked By: BDV Approved By: AEB		TTCI COUNTER CLOCKWISE ASPECTS AT RTT INTERMEDIATE & HOLDOUT SIGNALS (CAB MODE)		Scale: NTS CADD File Name: TTCI007.DWG Submitted Date: 11/26/14 Sheet No. 007	
--	--	--	--	--	--	--	--	--	--	--


HOUSE 602

					Designed By:	BDV	TTCI	Scale:	NTS
					Drawn By:	SAT		CADD File Name:	602000.DWG
					Checked By:	RWL	HOUSE 602	Submitted Date:	04/05/13
					Approved By:	AEB	COVER SHEET		Sheet No.
3	03/30/15	UPDATES AFTER TTCI SITE SURVEY/DESIGN REVIEW							000
2	03/17/15	UPDATED FOR TTT PROJECT							
1	11/26/14	AS-IN SERVICE							
REV	DATE	DESCRIPTION							






INDEX OF DRAWINGS			
SHT. NO.	DWG. NO.	REV.	DESCRIPTION
000	602000.DWG	3	COVER SHEET
001	602001.DWG	3	INDEX
002	602002.DWG	3	TRACK & SIGNAL PLAN
003	602003.DWG	2	TRACK CIRCUITS
004	602004.DWG	1	SWITCH MACHINE CIRCUITS SW 302
005	602005.DWG	1	SWITCH MACHINE CIRCUITS SW 602A & 602B
006	602006.DWG	1	SWITCH MACHINE CIRCUITS SW 301
007	602007.DWG	1	COMMUNICATIONS
008	602008.DWG	1	POWER DISTRIBUTION CIRCUITS
009	602009.DWG	1	VHLC-VGPI0-SLOT 4
010	602010.DWG	1	VHLC-VGPI0-SLOT 5
010a	602010a.DWG	2	VHLC-CCI-SLOT 6
011	602011.DWG	1	VHLC CONFIGURATION
012	602012.DWG	3	RACK 1 LAYOUT
012a	602012a.DWG	1	CAB-X LAYOUT
013	602013.DWG	1	WAGO LAYOUT RACK 1, ROW A & B
013a	602013a.DWG	1	WAGO LAYOUT RACK 1, ROW AA & BB
014	602014.DWG	1	RELAY LAYOUT RACK 1, ROW J & K
015	602015.DWG	2	LOCAL CONTROL PANEL
016	602016.DWG	2	CONTROLS & INDICATIONS
017	602017.DWG	2	VITAL REMOTE NETWORKS

					Designed By:	TTCI HOUSE 602 INDEX	Scale:	NTS
					BDV		CADD File Name:	602001.DWG
					Drawn By:		Submitted Date:	04/05/13
					SAT			
					Checked By:	RWL		
					Approved By:	AEB		Sheet No.
								001
3	03/30/15	UPDATES AFTER TTCI SITE SURVEY/DESIGN REVIEW						
2	03/17/15	UPDATED FOR TTT PROJECT						
1	11/26/14	AS-IN SERVICE						
REV	DATE	DESCRIPTION						

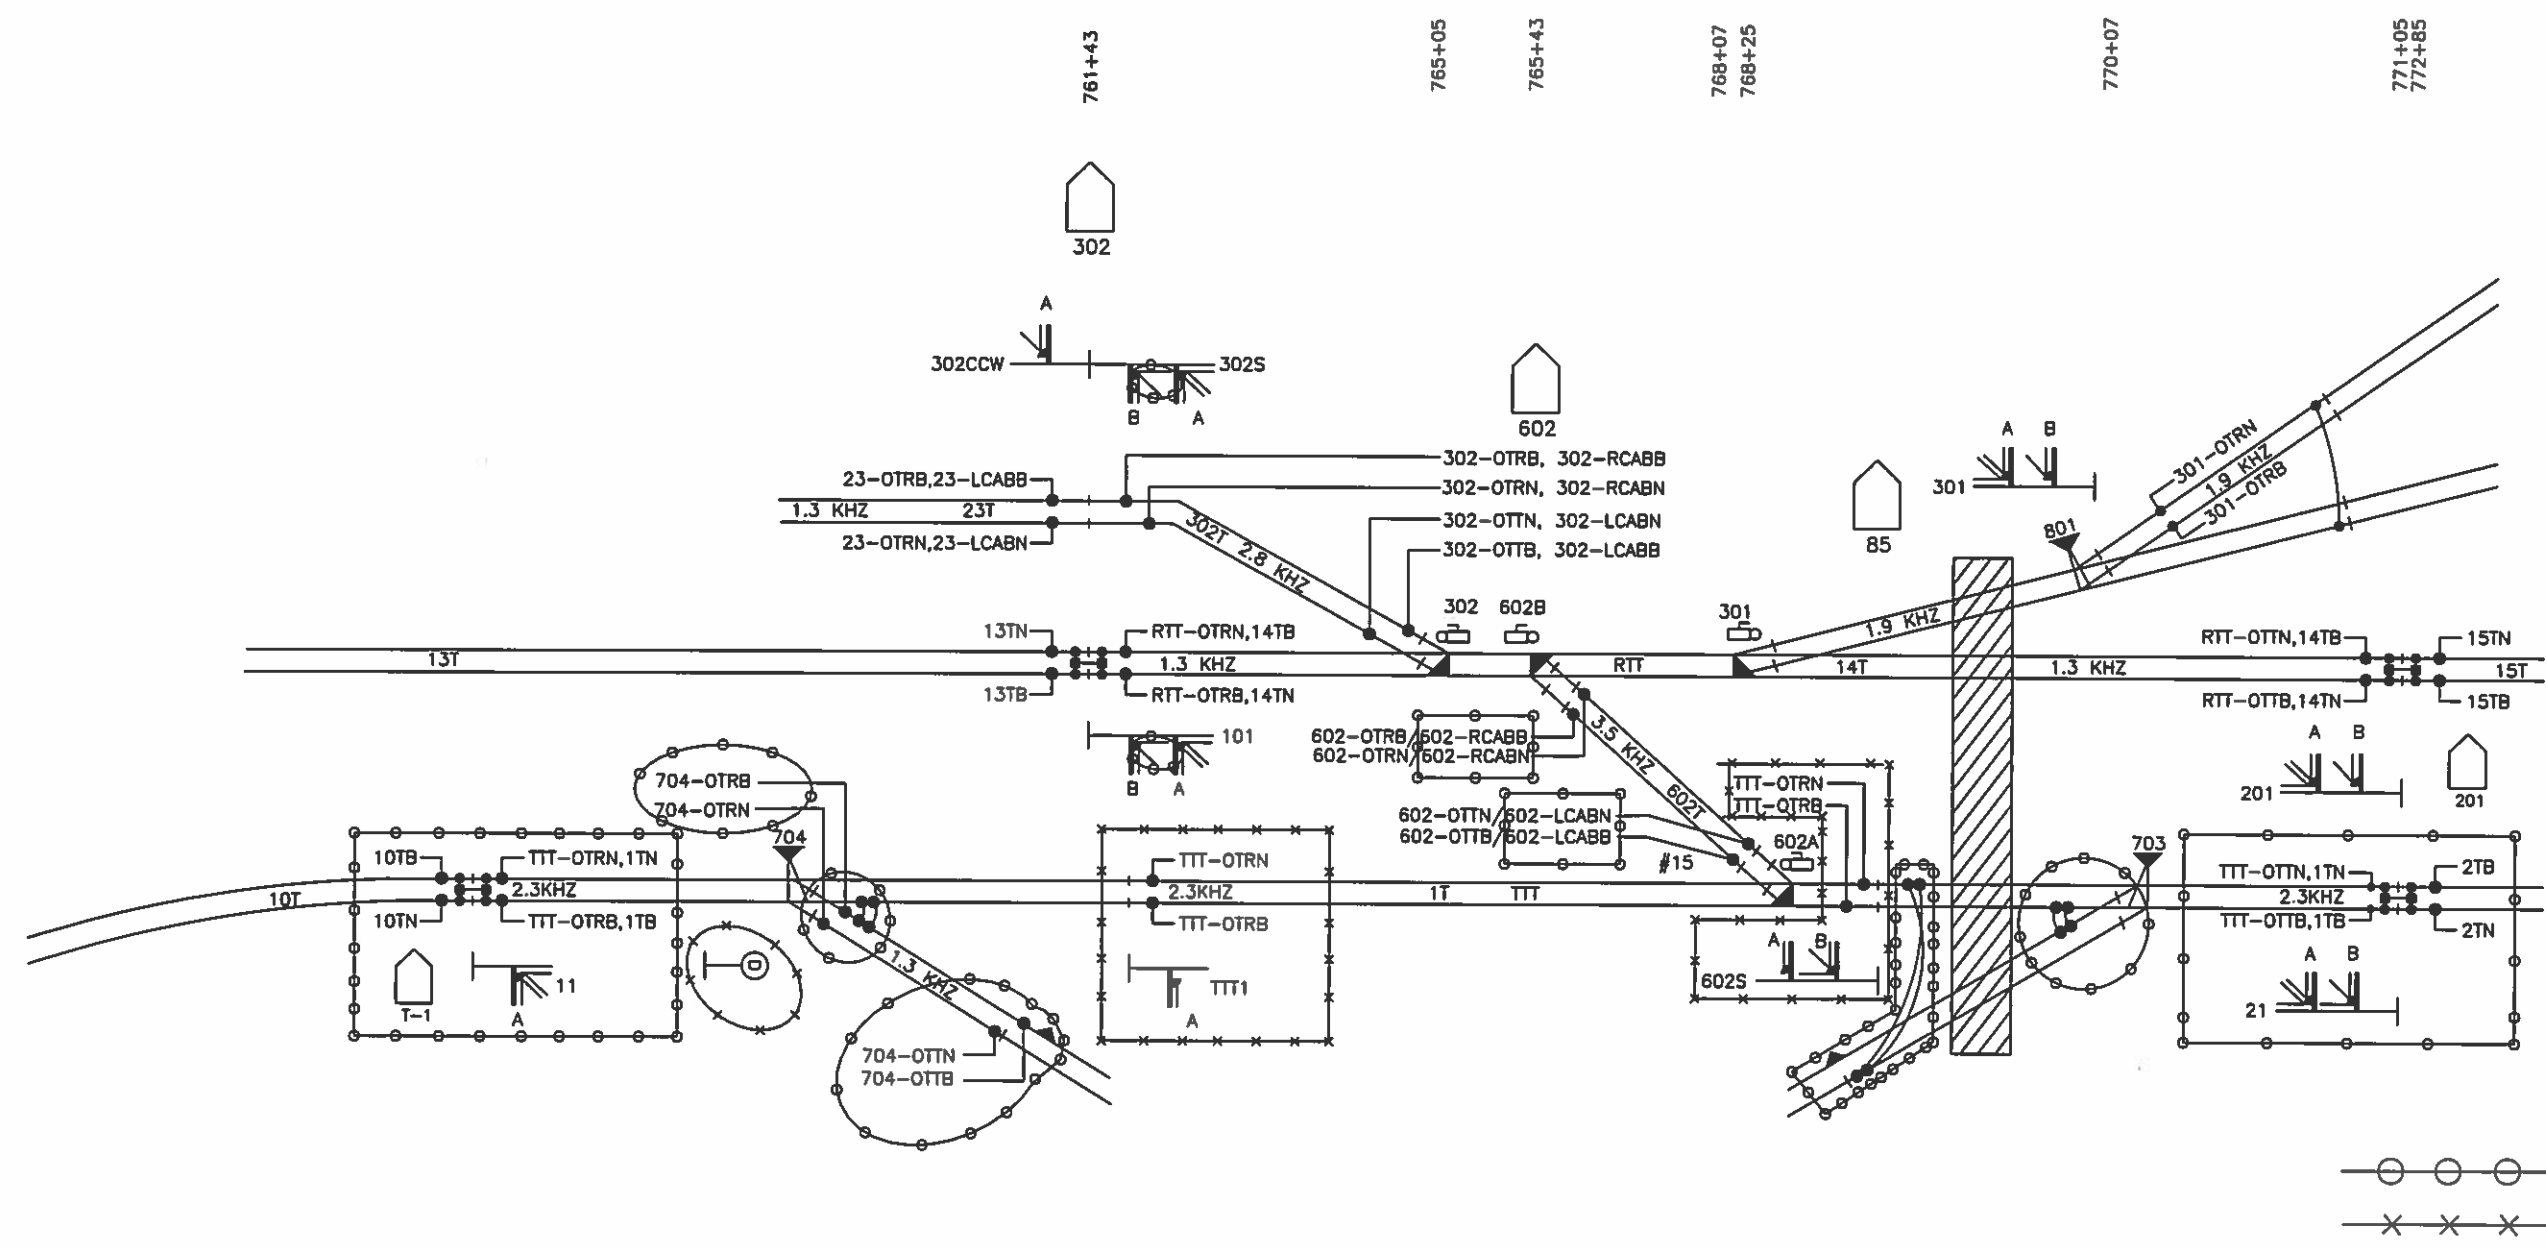

				Designed By: BDV Drawn By: SAT Checked By: RWL Approved By: AEB	TTCI HOUSE 602 TRACK & SIGNAL PLAN	Scale: NTS	
						CADD File Name: 602002.DWG	
						Submitted Date: 04/05/13	
						Sheet No. 002	
3	03/30/15	CHANGED 703 & 704 CIRCUITS					
2	03/17/15	UPDATED FOR TTT SIGNALING PROJECT					
1	11/26/14	AS-IN SERVICE					
REV	DATE	DESCRIPTION					

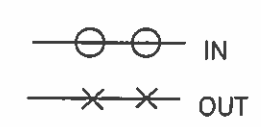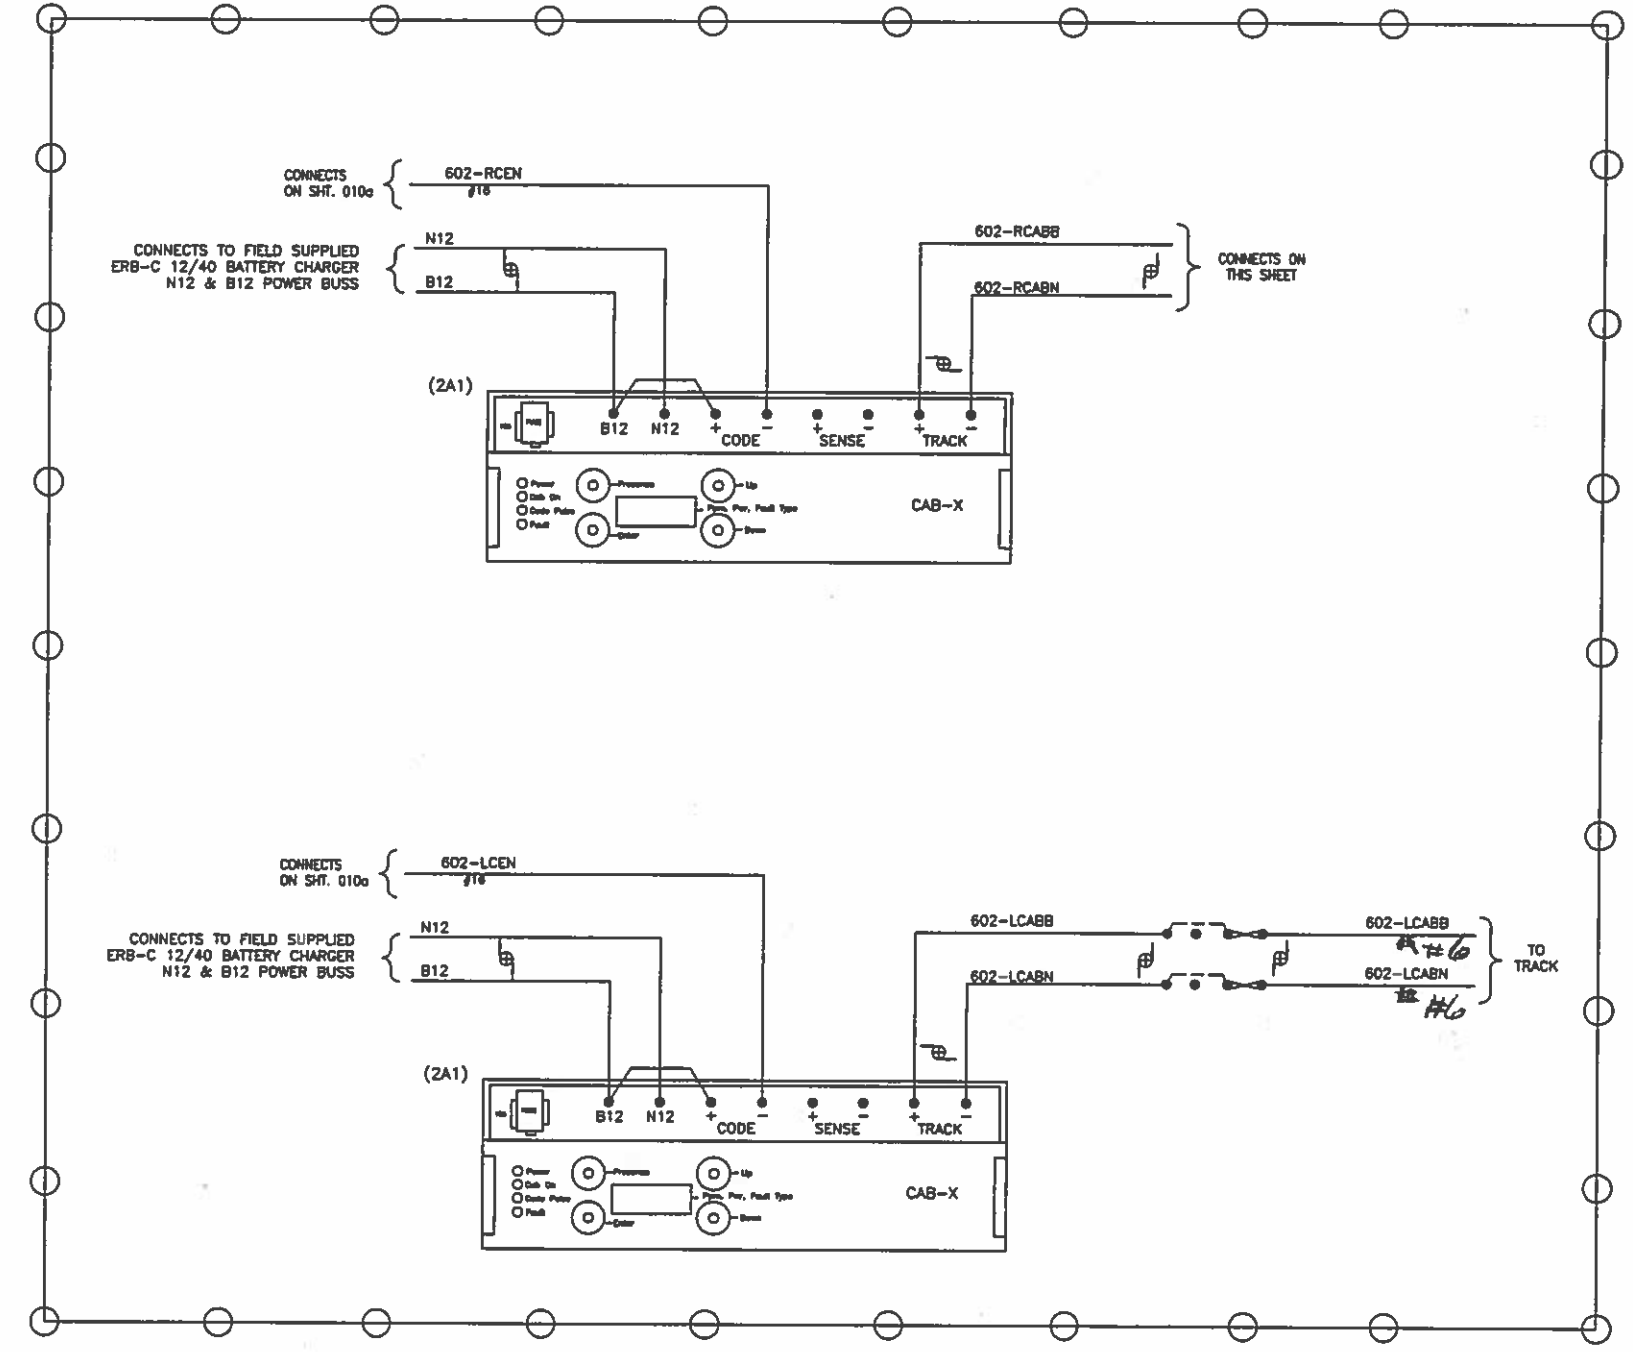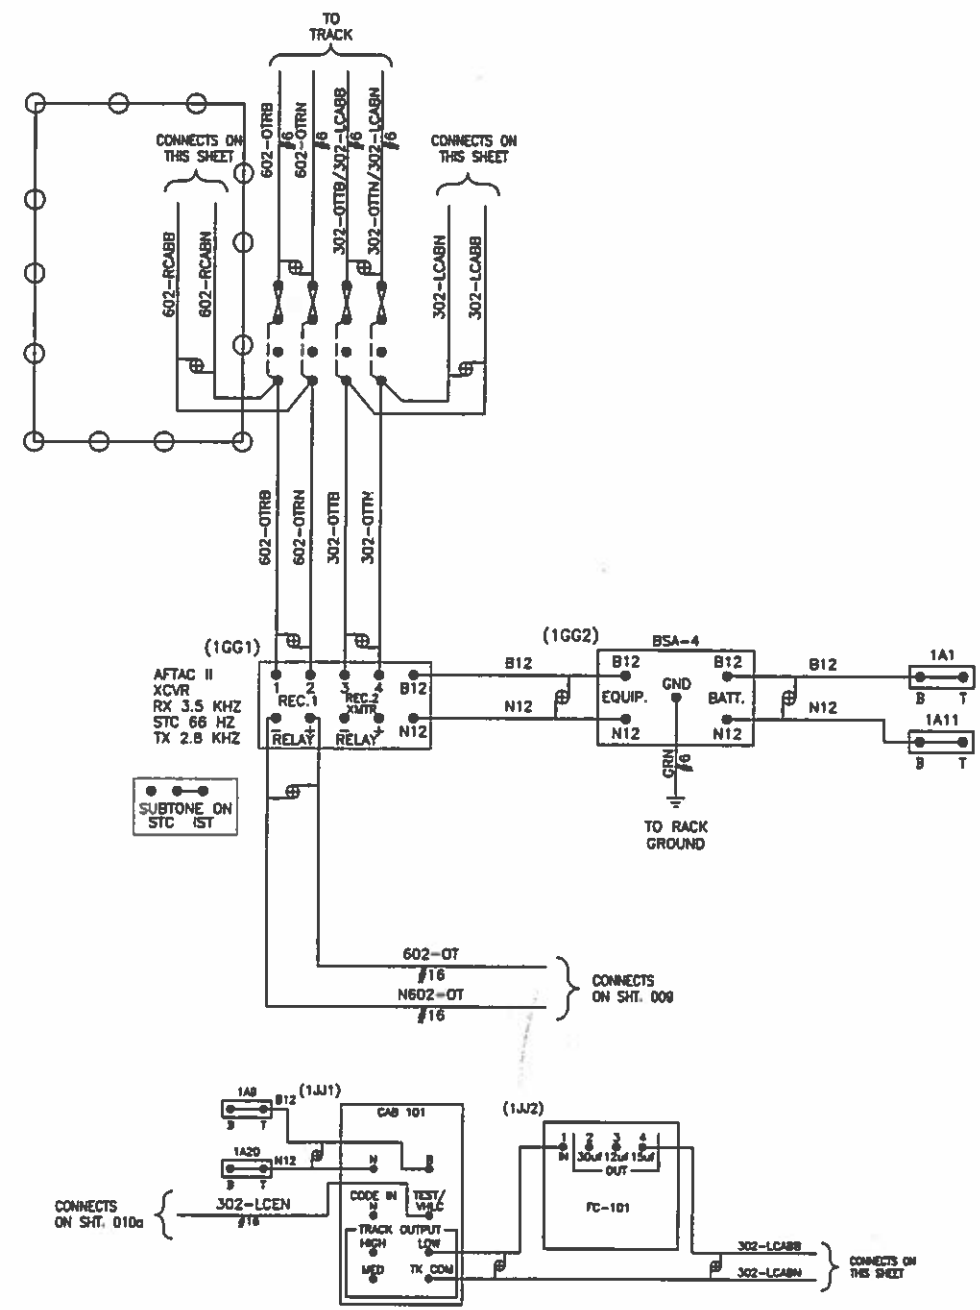

- NOTES:
- 1) ALL WIRING ON THIS SHEET TO BE #10 AWG UNLESS OTHERWISE NOTED.
 - 2) $\overline{\text{TW}}$ = TWISTED PAIR 2 TURNS PER FOOT.
 - 3) --- = INTERNAL CONNECTION
 - 4) CAB-X EQUIPMENT SHOULD BE WALL OR SHELF MOUNTED.

REV	DATE	DESCRIPTION
2	03/17/15	ADDED CAB-X GENERATORS FOR 602-LCAB & 602-RCAB
1	11/26/14	AS-IN SERVICE



Designed By: BDV

Drawn By: SAT

Checked By: RWL



Approved By: AEB

TTCI

HOUSE 602

TRACK CIRCUITS

Scale:	NTS
CADD File Name:	602003.DWG
Submitted Date:	04/05/13
Sheet No.	003

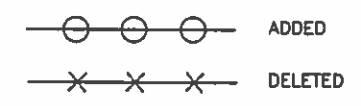
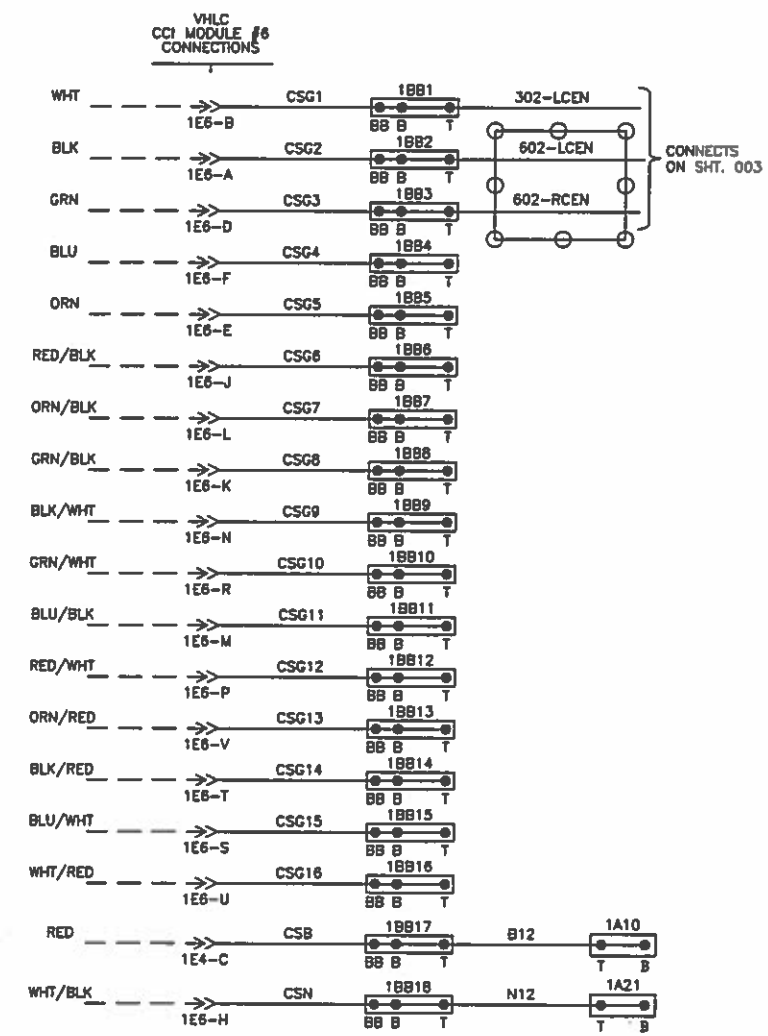


NOTES:

1) ALL WIRING ON THIS SHEET TO BE #16 AWG UNLESS OTHERWISE NOTED.

2) # = LOWER CASE LETTER.

--	--	
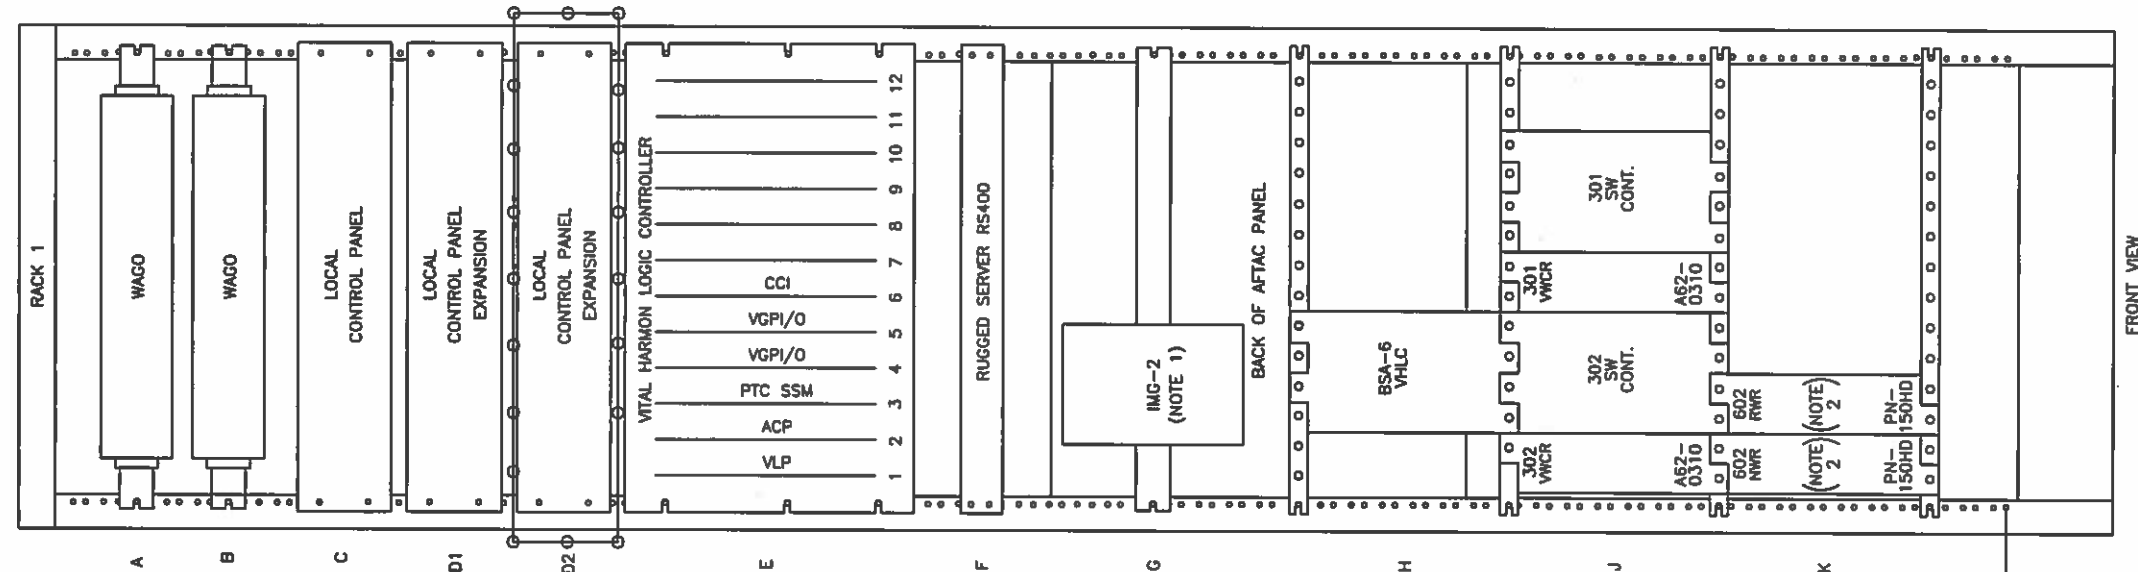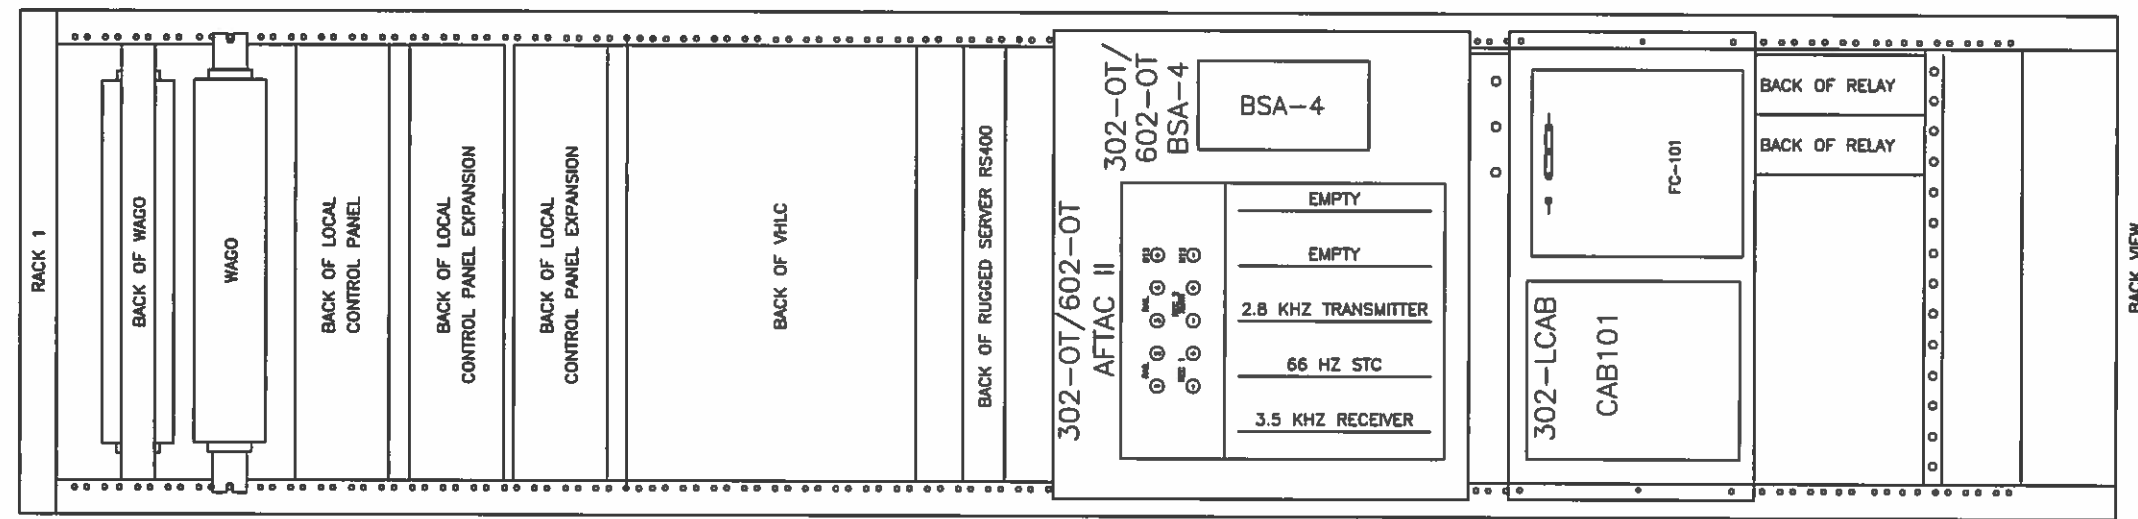

INCHES

○ ○ ○ ADDED



✕ ✕ ✕ DELETED

NOTES:

1) FIELD SUPPLIED

2) US&S RELAYS TO BE MOUNTED ON SAFTRAN RELAY MOUNTING BARS. SOME MODIFICATIONS MAY BE NECESSARY FOR FIELD INSTALLATION.

--	--	
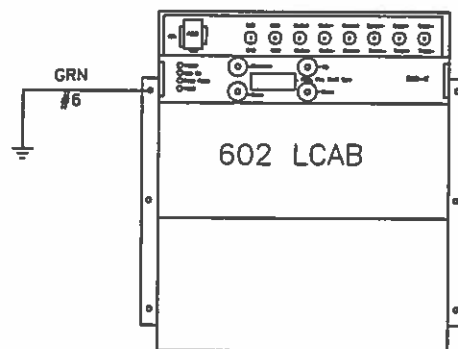
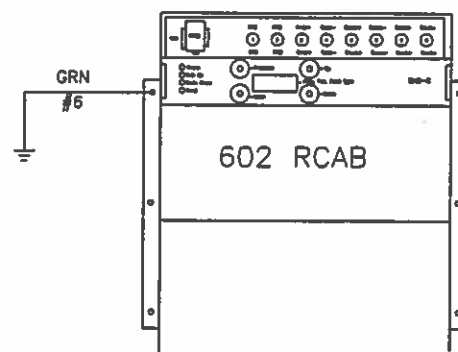


NEW SHEET


NOTES:
1) EQUIPMENT MAY BE WALL OR SHELF MOUNTED.

1 03/17/15 AS-DESIGNED FOR TTT PROJECT	REV DATE DESCRIPTION	 GETS Global Signaling	Designed By: BPC Drawn By: BPC Checked By: BDW Approved By: AEB	TTCI HOUSE 602 CAB-X LAYOUT	Scale: NTS CADD File Name: 602012a.DWG Submitted Date: 03/17/15 Sheet No. 012a


LCP DIP SWITCH SETTINGS

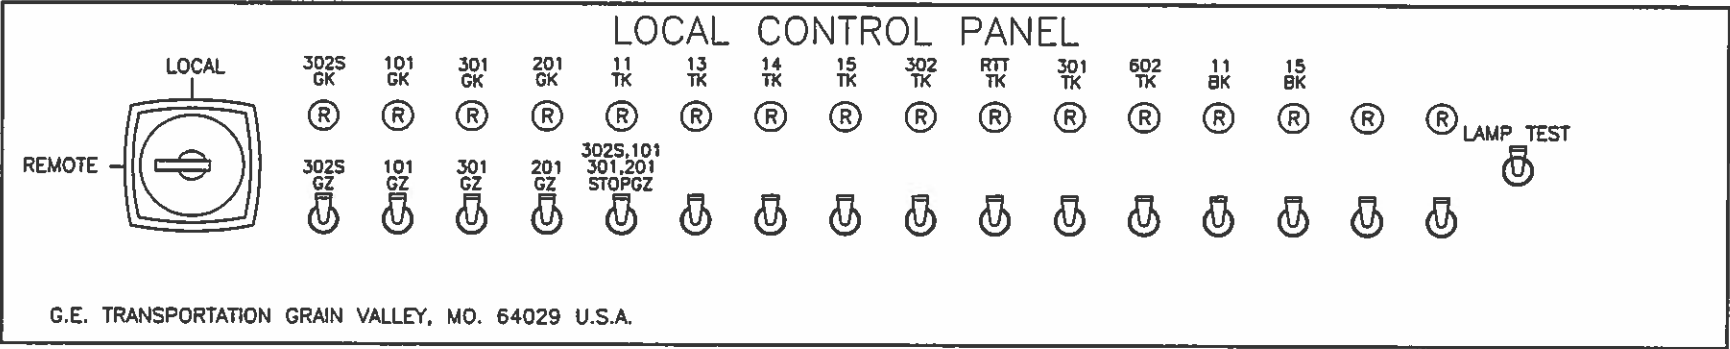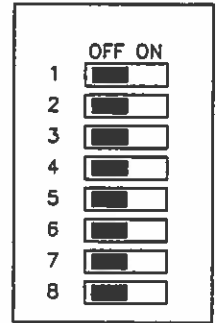

ROW C

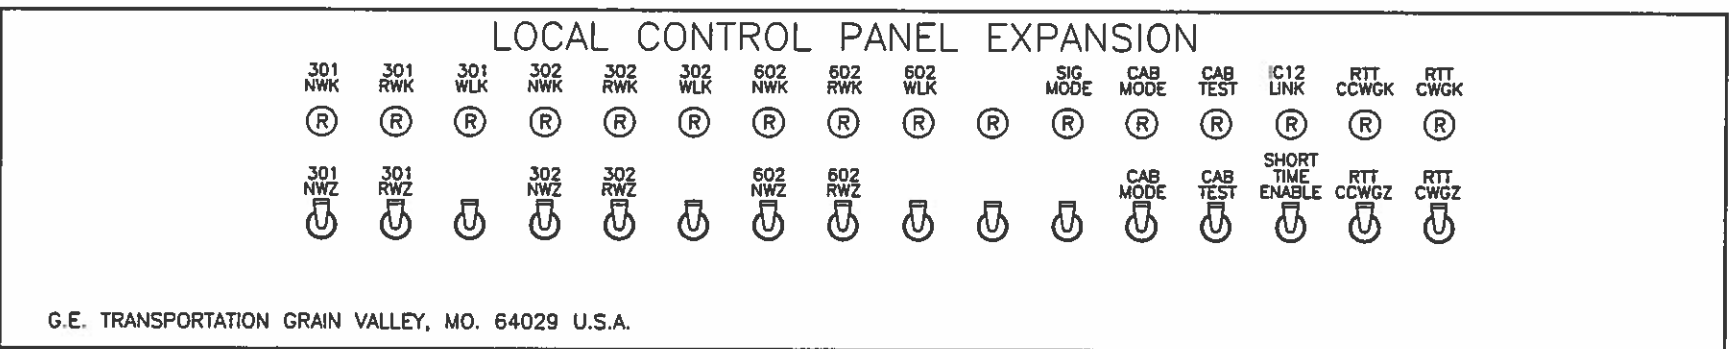


ROW D1

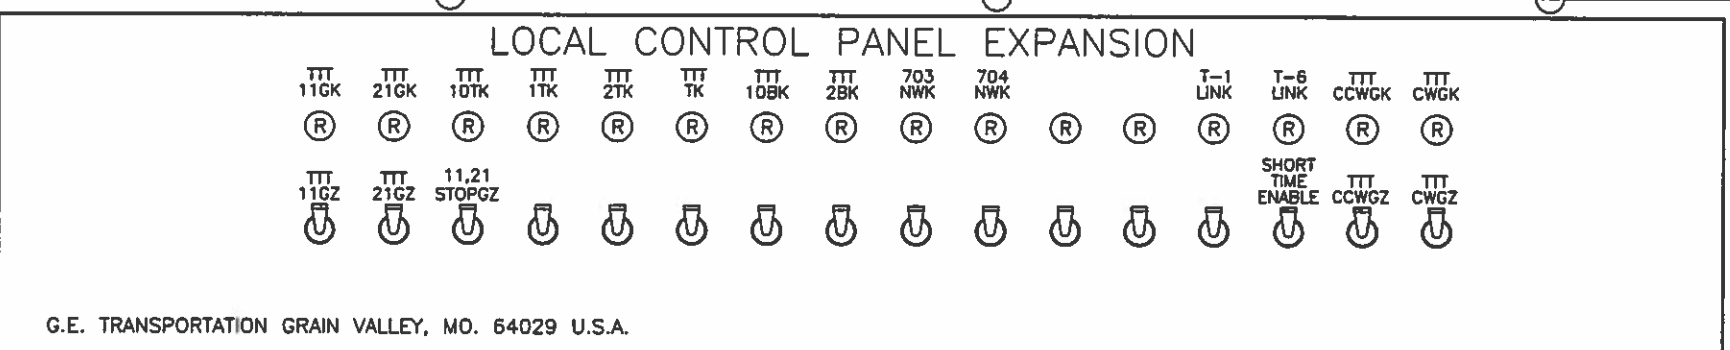

ROW D2

SWITCHES AND INDICATIONS ASSIGNMENTS HAVE BEEN MODIFIED ON ALL LCP PANELS

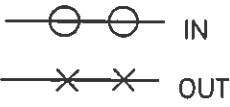

REV	DATE	DESCRIPTION
2	3/17/15	ADDED PANEL D2 & MODIFIED ASSIGNMENTS ON ALL PANELS
1	11/26/14	AS-IN SERVICE



Designed By:	BDV
Drawn By:	SAT
Checked By:	RWL
Approved By:	AEB



TTCI
HOUSE 602
LOCAL CONTROL PANEL

Scale:	NTS
CADD File Name:	602015.DWG
Submitted Date:	04/05/13
Sheet No.	015

CODE ASSIGNMENTS								
CONTROLS								
	BIT 1	BIT 2	BYTE 3	BYTE 4	BYTE 5	BYTE 6	BYTE 7	BYTE 8
BYTE 1	H302NWZ	H302RWZ	H602NWZ	H602RWZ	H301NWZ	H301RWZ	H1ENGZ	H1WSGZ
BYTE 2	H2ENGZ	H2WSGZ	HCCWGZ	HCWGZ	HCABTZ	HCABMZ	HCABSTOP	*H2CCWGZ
BYTE 3	*H2CWGZ	*H11GZ	*H21GZ	*HTTTSTOP				
INDICATIONS								
	BIT 1	BIT 2	BIT 3	BIT 4	BIT 5	BIT 6	BIT 7	BIT 8
BYTE 1	H302NWK	H302RWK	H602NWK	H602RWK	H301NWK	H301RWK	H1ENGK	H1ENTENK
BYTE 2	H1WSGK	H1WSTENK	H2ENGK	H2ENTENK	H2WSGK	H2WSTENK	H13TTK	H1TK
BYTE 3	H2TK	H15TTK	H15TAK	HCCWK	HCWK	H703NWK	H704NWK	HLOCAL
BYTE 4	HCABTK	HCABMODK	HSIGMODK	H12LINK	*HT1LINK	*HT6LINK	*HTTCCWK	*HTTCCWK
BYTE 4	*HT10TK	*HT2TK						

NEW CONTROLS AND INDICATIONS ADDED FOR THE TTT SIGNALING PROJECT ARE SHOWN WITH AN * IN FROM OF THE NAME.

						Designed By: BDV	TTCI HOUSE 602 LOCALS & INDICATIONS	Scale: NTS	
						Drawn By: SAT		CADD File Name: 602016.DWG	
						Checked By: RWL		Submitted Date: 09/30/13	
						Approved By: AEB			
2	03/17/15	ADDED CONTROLS & INDICATIONS FOR TTT SIGNALING PROJECT.							
1	11/26/14	AS-IN SERVICE							
REV	DATE	DESCRIPTION							

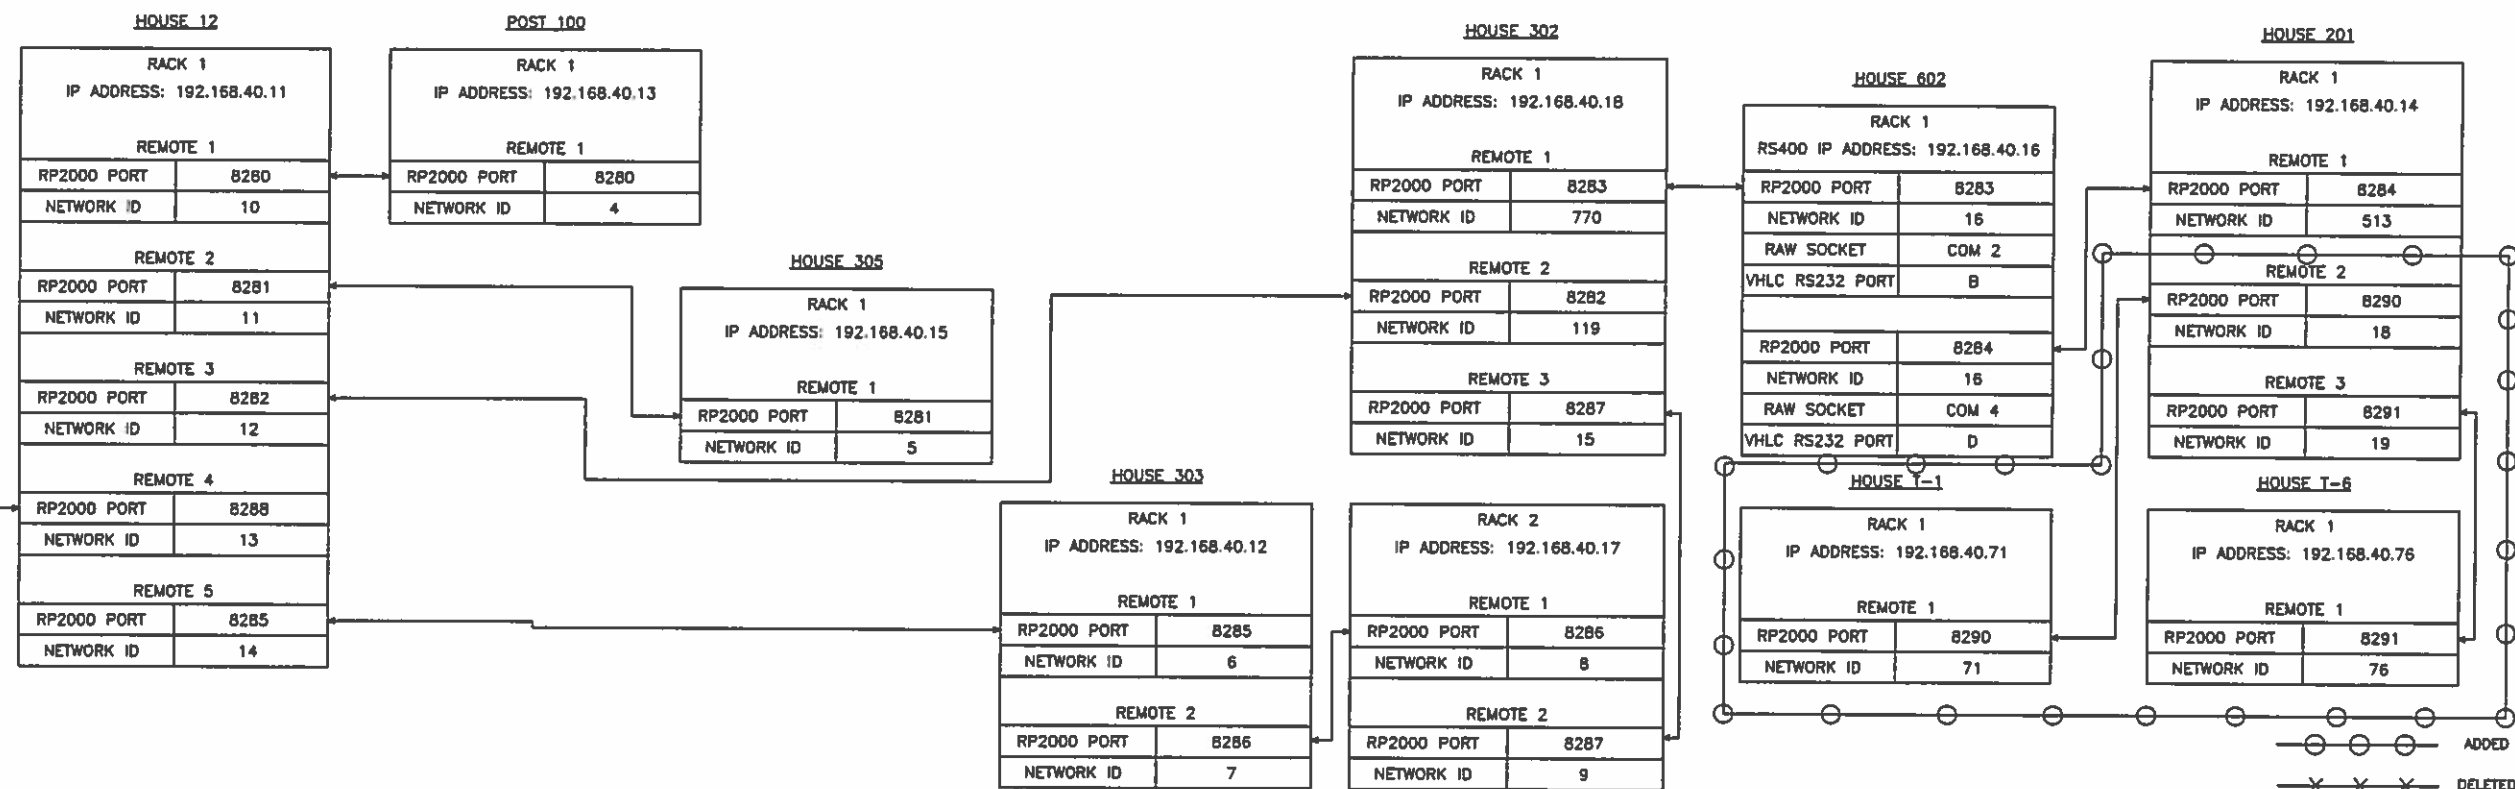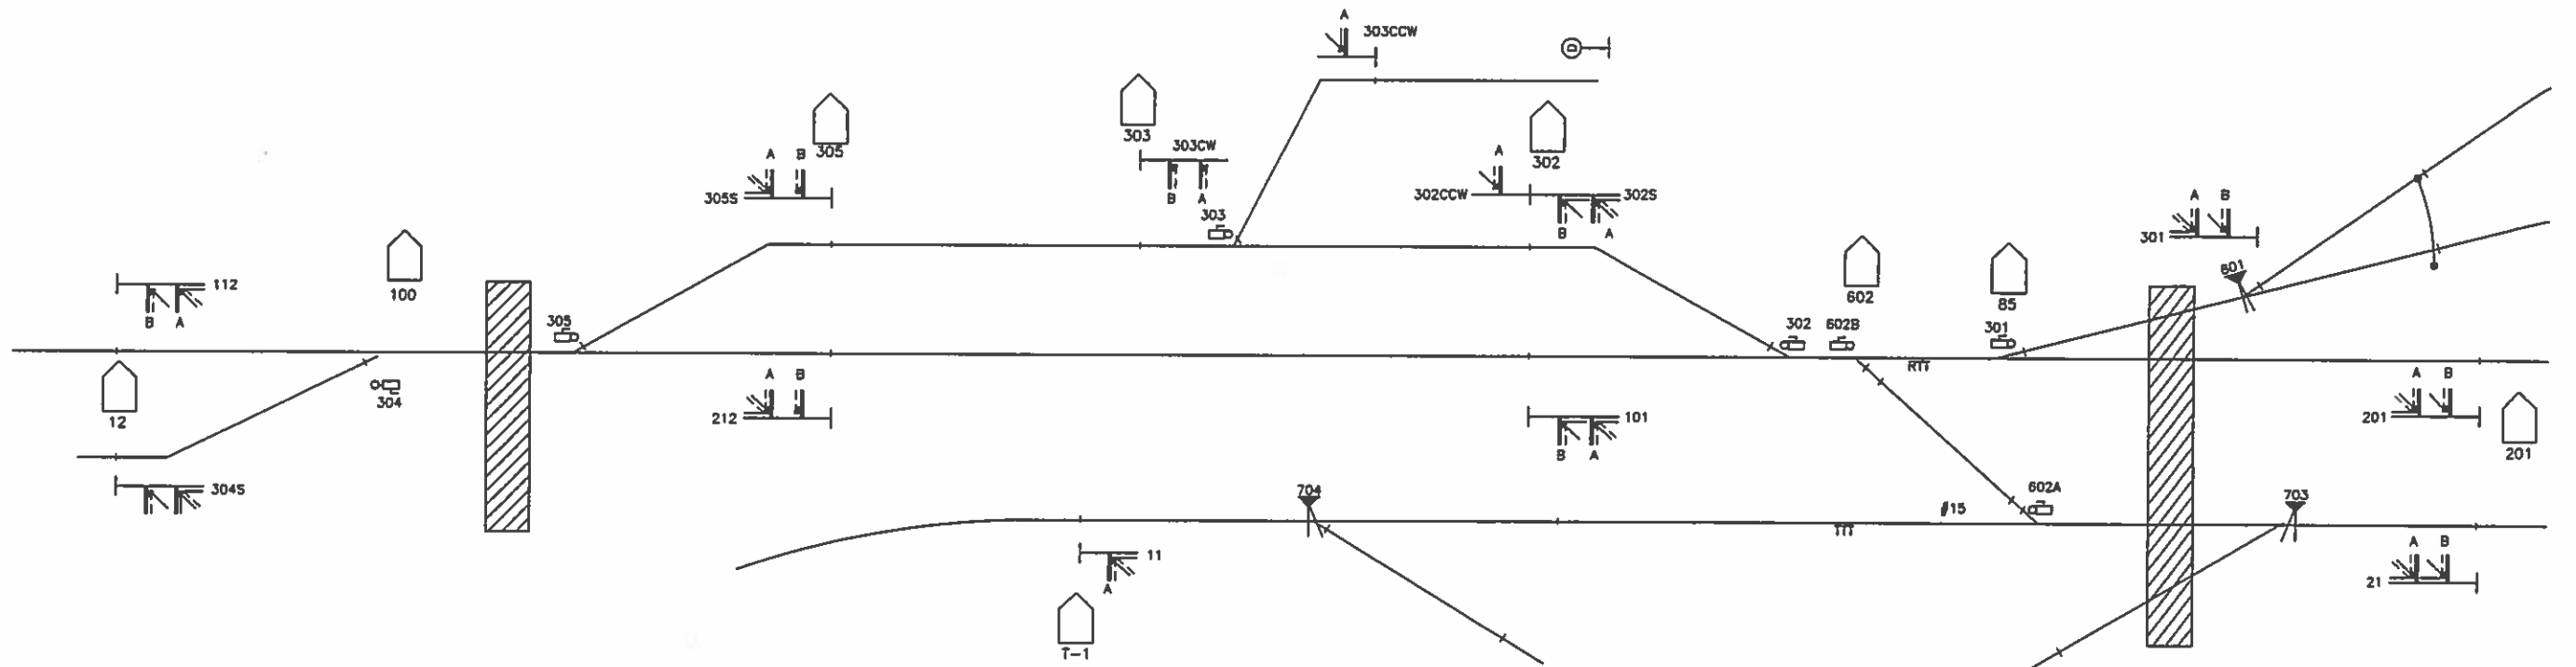

REV	DATE	DESCRIPTION
2	03/17/15	ADDED HOUSES T-1 AND T-6
1	11/26/14	AS-IN SERVICE



Designed By:	BPC
Drawn By:	SAT
Checked By:	BDV
Approved By:	AEB

TTCI
HOUSE 602
VITAL REMOTE NETWORKS

Scale:	NTS
CADD File Name:	602017.DWG
Submitted Date:	04/21/14
Sheet No.	017


HOUSE 201

					Designed By:	BDV	TTCI	Scale:	NTS
					Drawn By:	SAT		CADD File Name:	201000.DWG
					Checked By:	RWL	HOUSE 201	Submitted Date:	04/03/13
					Approved By:	AEB	COVER SHEET		Sheet No.
									000
3	03/30/15	UPDATES AFTER TTCI SITE SURVEY/DESIGN REVIEW							
2	03/19/15	UPDATED FOR TTT PROJECT							
1	11/26/14	AS-IN SERVICE							
REV	DATE	DESCRIPTION							



INDEX OF DRAWINGS			
SMT. NO.	DWG. NO.	REV.	DESCRIPTION
000	201000.DWG	3	COVER SHEET
001	201001.DWG	3	INDEX
002	201002.DWG	3	TRACK & SIGNAL PLAN
003	201003.DWG	2	CODE & ASPECT CHART
004	201004.DWG	3	RTT TRACK CIRCUITS
004a	201004a.DWG	1	TTT TRACK CIRCUITS
005	201005.DWG	2	SIGNAL LIGHTING CIRCUITS
006	201006.DWG	1	COMMUNICATIONS
007	201007.DWG	1	POWER DISTRIBUTION CIRCUITS RACK 1
007a	201007a.DWG	1	POWER DISTRIBUTION CIRCUITS RACK 2
008	201008.DWG	3	ELECTROLOGIXS 4-SLOT MODULE CONNECTOR USAGE
009	201009.DWG	2	ELECTROLOGIXS 4-SLOT HARDWARE CONFIGURATION
010	201010.DWG	2	ELECTROLOGIXS 4-SLOT CONFIGURATION SETTINGS
011	201011.DWG	2	RACK 1 LAYOUT
011a	201011a.DWG	2	RACK 2 LAYOUT
012	201012.DWG	1	WAGO & RELAY LAYOUT RACK 1, ROW A & B
012a	201012a.DWG	1	WAGO & RELAY LAYOUT RACK 2, ROW A
013	201013.DWG	2	VITAL REMOTE NETWORKS


					Designed By:	BDV	TTCI HOUSE 201 INDEX	Scale:	NTS
					Drawn By:	SAT		CADD File Name:	201001.DWG
					Checked By:	RWL		Submitted Date:	04/03/13
					Approved By:	AEB			Sheet No.
3	03/30/15	UPDATES AFTER TTCI SITE SURVEY/DESIGN REVIEW							001
2	3/19/15	UPDATED FOR TTT SIGNALING PROJECT							
1	11/26/14	AS-IN SERVICE							
REV	DATE	DESCRIPTION							

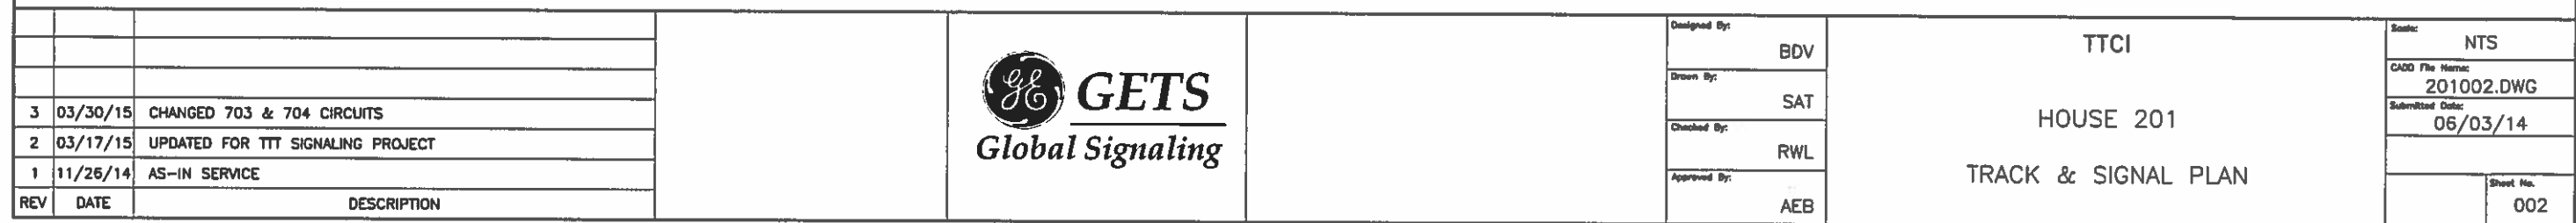

• OR SIGNAL AT STOP

• OR SIGNAL AT STOP

* OR SIGNAL AT STOP

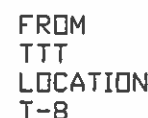* OR SIGNAL AT STOP

III. CAB RATE TABLE



N — SWITCH IN NORMAL POSITION

[R] - SWITCH IN REVERSE POSITION

REV	DATE	DESCRIPTION
-----	------	-------------



BDV

SAT

AFB

TTCI

HOUSE 201



CODE & ASPECT CHART

Source: NTS

CADD File Name:
201003.DWG

Submitted Date: 04/03/13

Sheet No.	00
-----------	----

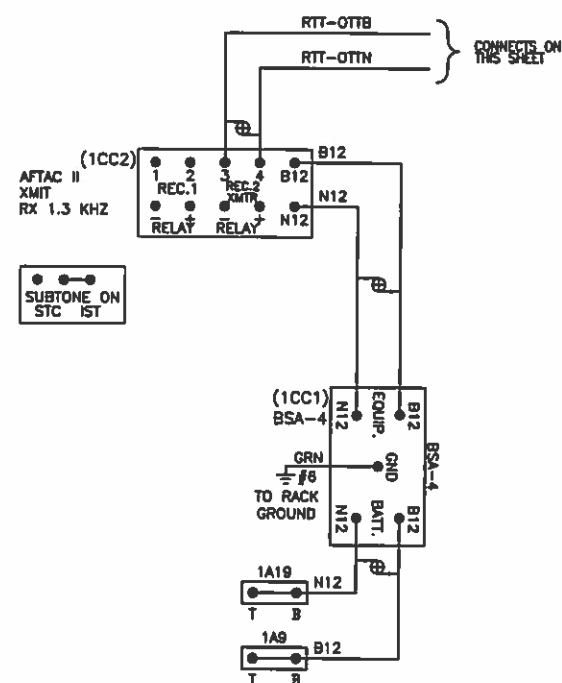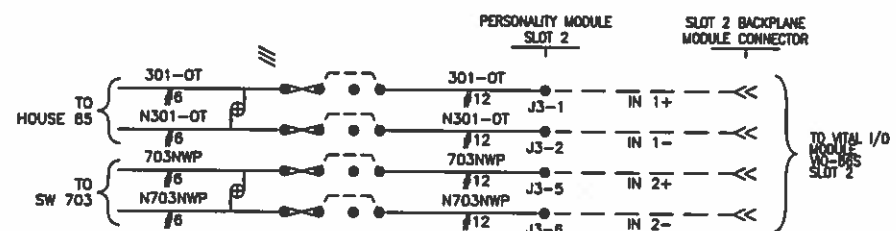

 ADDED
 DELETED

NOTES:

- 1) ALL WIRING ON THIS SHEET TO BE #10 AWG
UNLESS OTHERWISE NOTED.
2) = TWISTED PAIR 2 TURNS PER FOOT.
3) ---- = INTERNAL CONNECTION



Designed By:

BDV

Drawn By:

SAT

Checked By: _____

RWL

Approved By:

AEB

TTCI

HOUSE 201

RTT TRACK CIRCUITS



	Scoring:
--	-----------------

NTS

CADD File Name:
201004.DWG

Submitted Date: 04/03/13

Sheet No.	004
-----------	-----

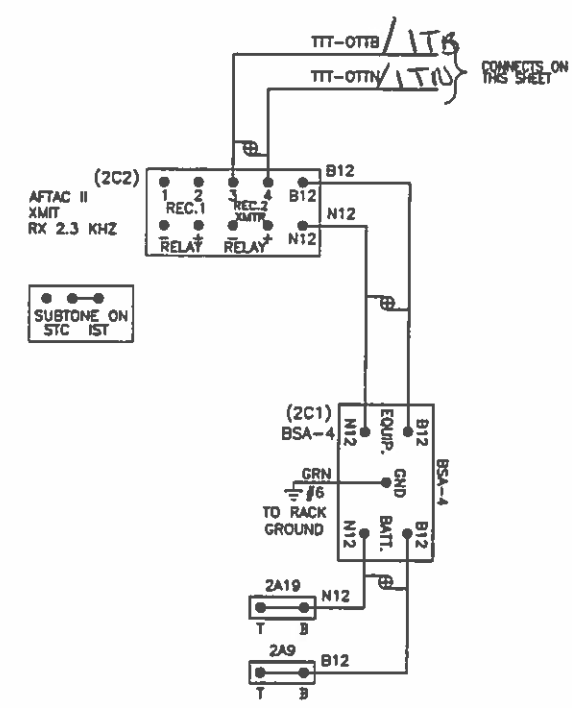
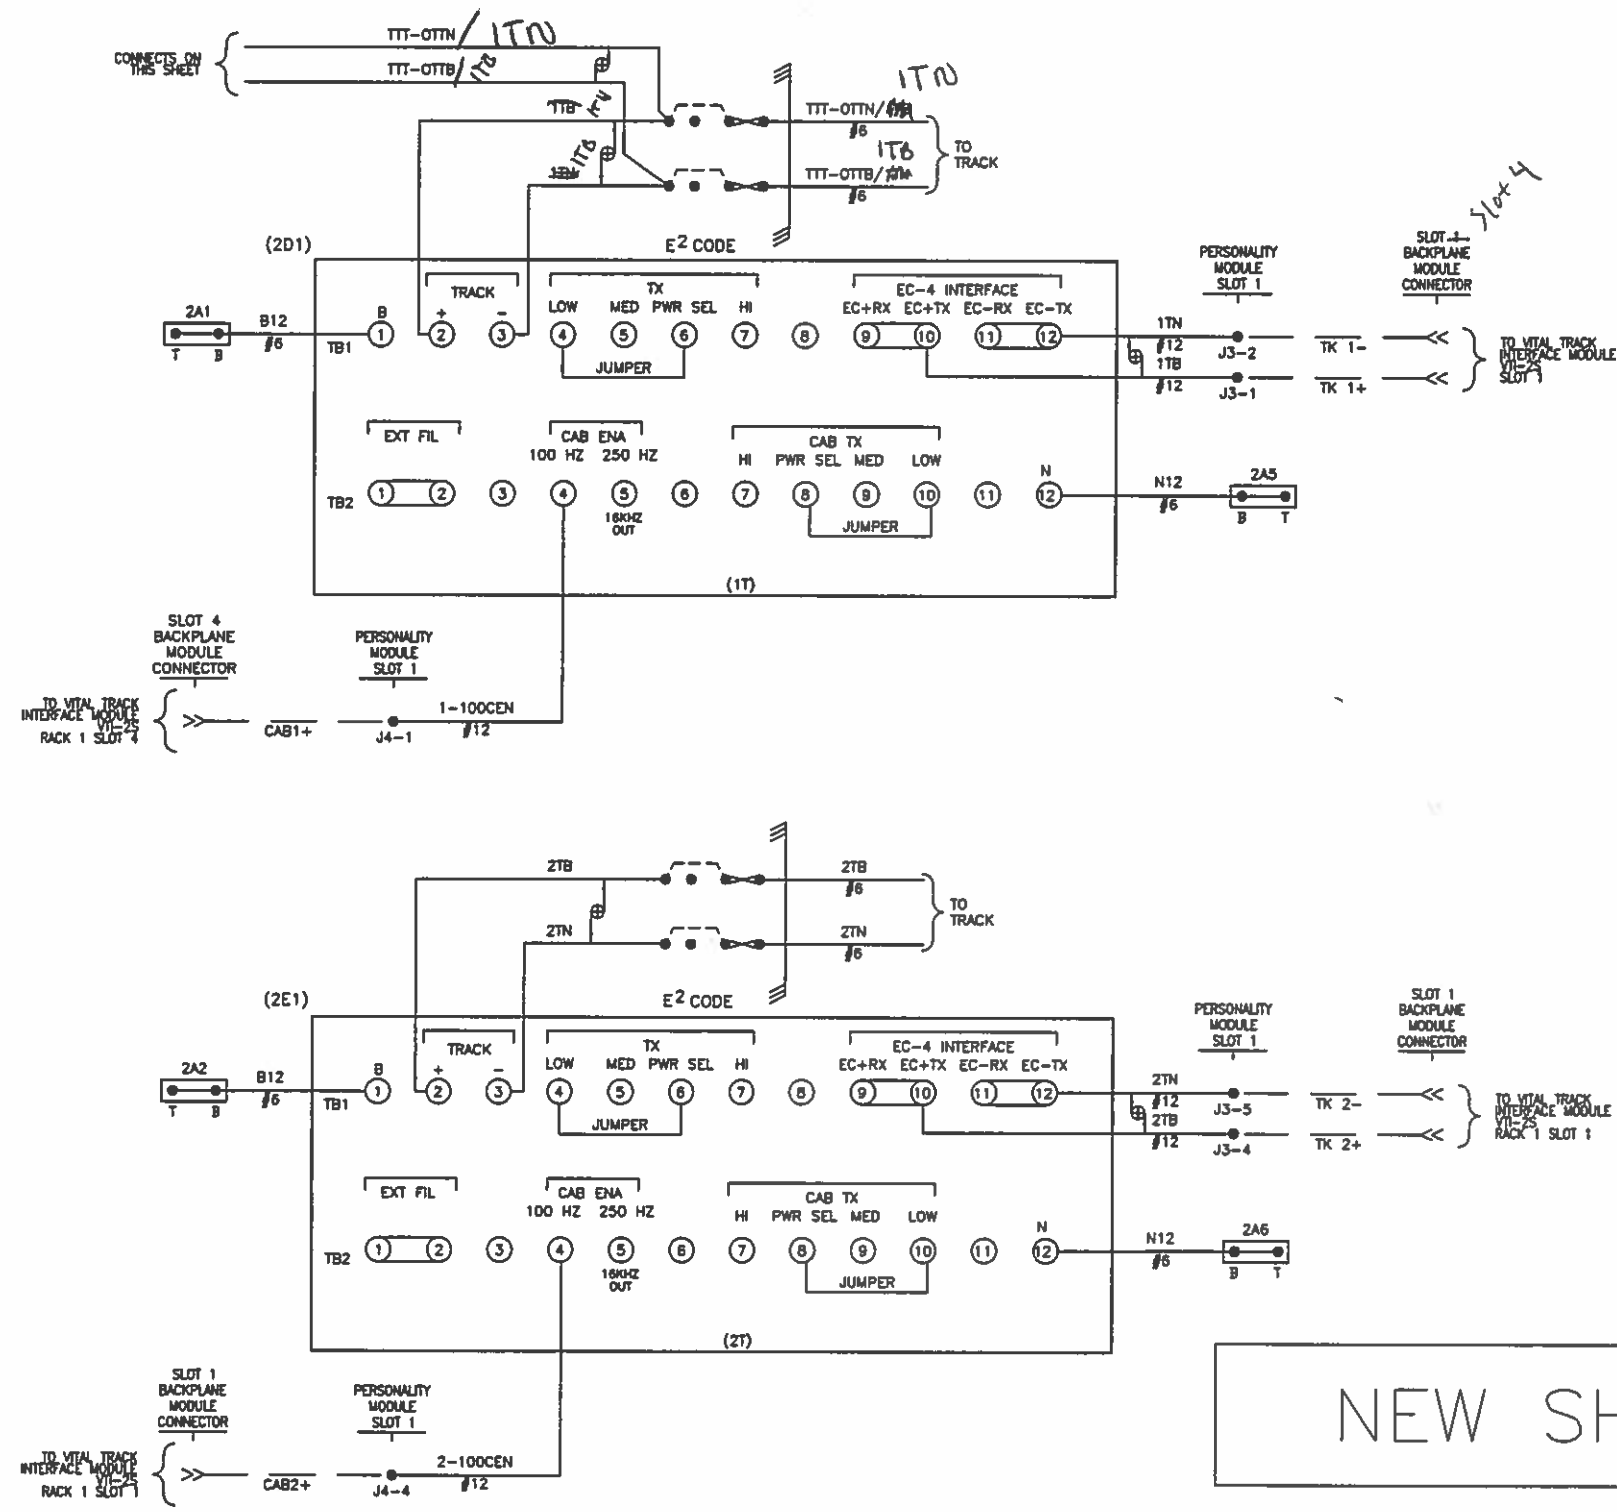


- NOTES:
- 1) ALL WIRING ON THIS SHEET TO BE #10 AWG UNLESS OTHERWISE NOTED.
 - 2) TW = TWISTED PAIR 2 TURNS PER FOOT.
 - 3) ---- = INTERNAL CONNECTION

REV	DATE	DESCRIPTION
1	03/19/15	NEW TRACK CIRCUITS FOR TTT PROJECT



Designed By:	BPC	TTCI	Scale:	NTS
Drawn By:	BPC	HOUSE 201	CADD File Name:	201004a.DWG
Checked By:	BDW	TTT TRACK CIRCUITS	Submitted Date:	03/19/15
Approved By:	AEB		Sheet No.:	004a

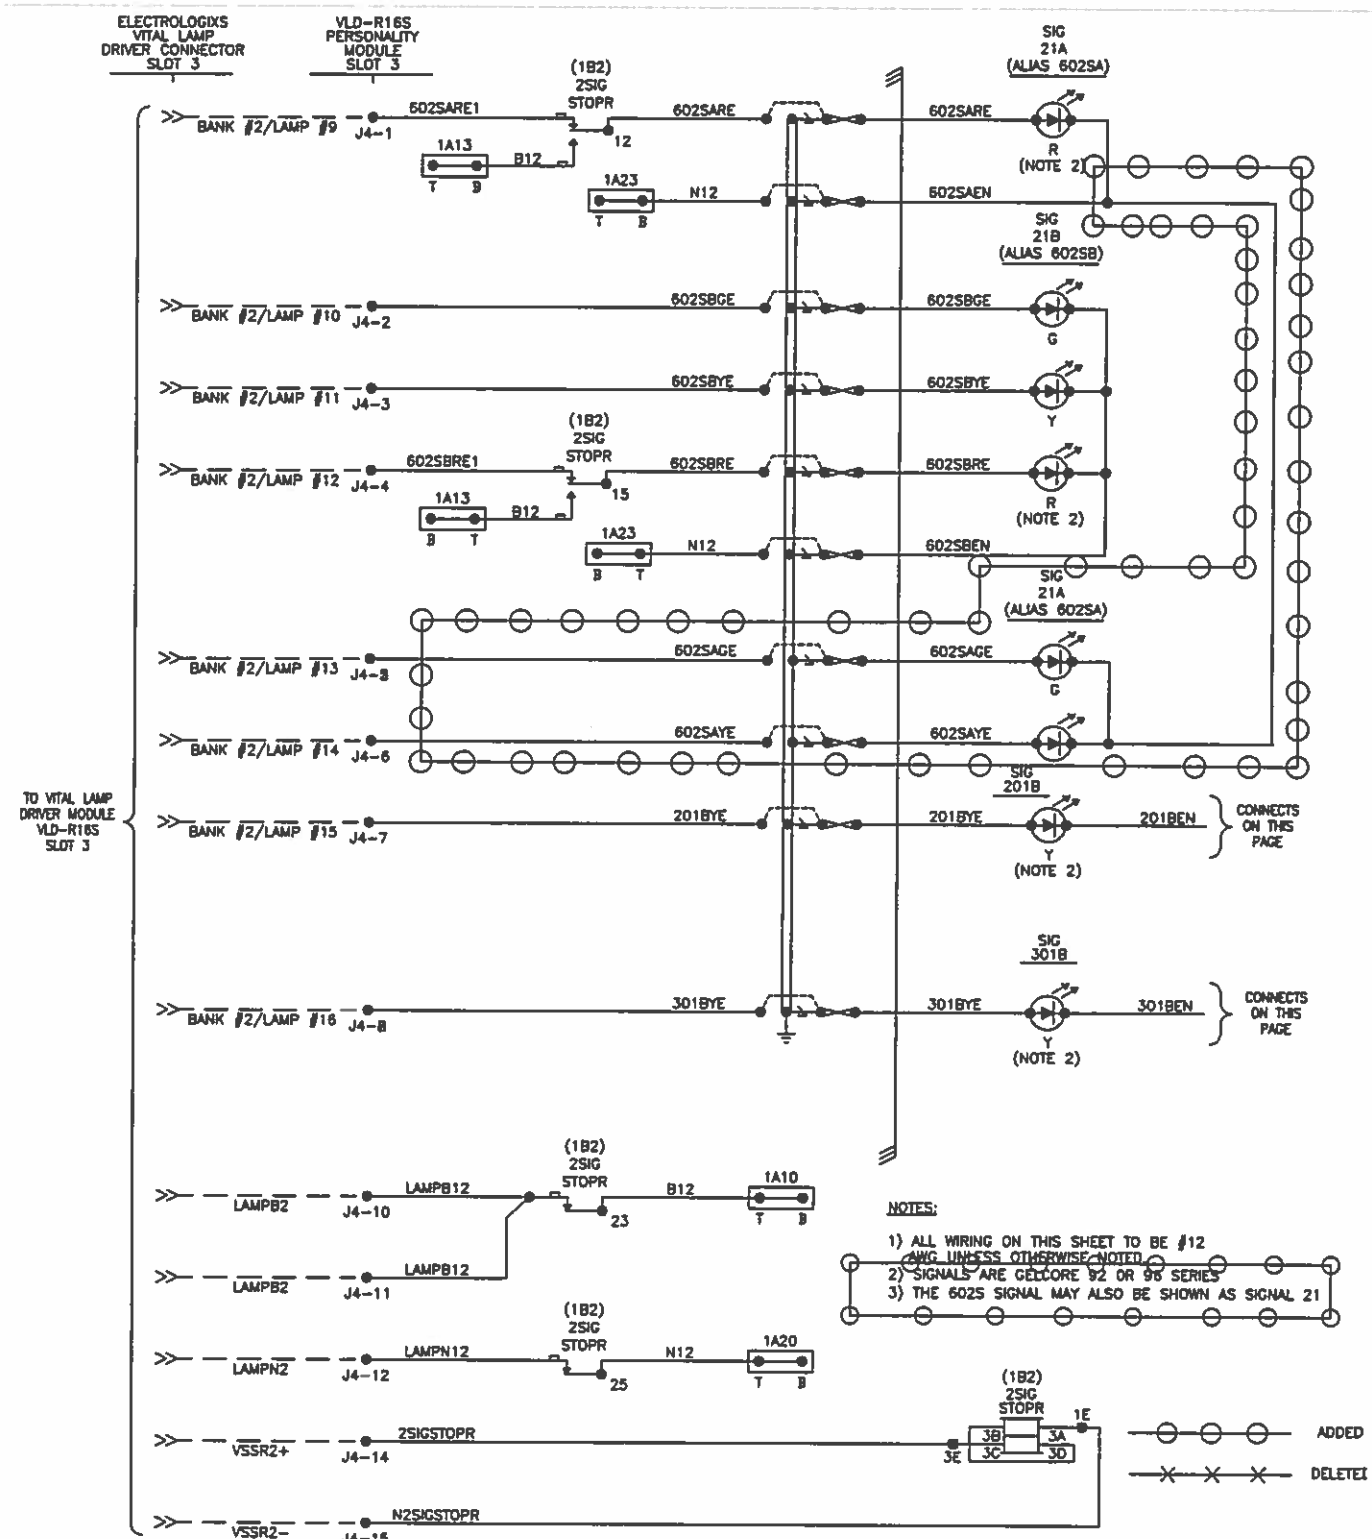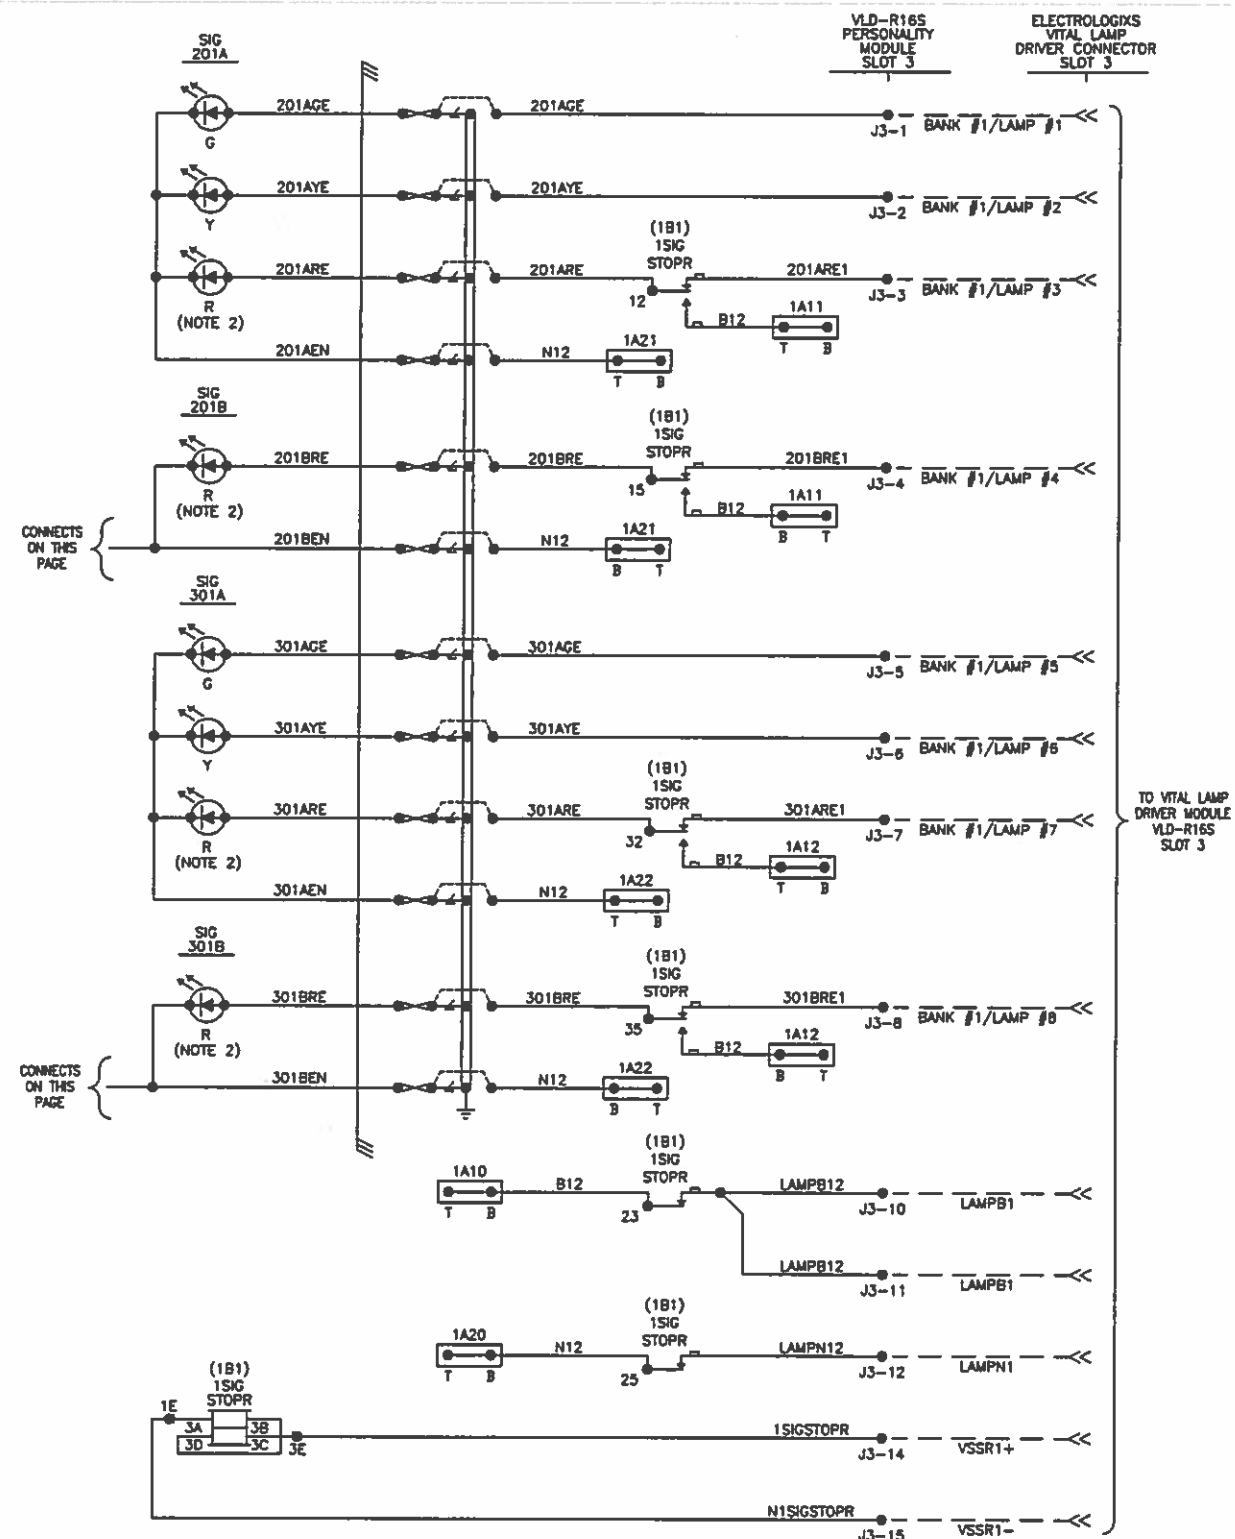

- NOTES:
- 1) ALL WIRING ON THIS SHEET TO BE #12 AWG UNLESS OTHERWISE NOTED
 - 2) SIGNALS ARE GELCORE 92 OR 96 SERIES
 - 3) THE 602S SIGNAL MAY ALSO BE SHOWN AS SIGNAL 21

ADDED
DELETED



REV	DATE	DESCRIPTION
2	03/19/15	ADDED GREEN AND YELLOW A HEAD SIGNALS TO SIG 21A
1	11/26/14	AS-IN SERVICE



Designed By: BDV
Drawn By: SAT
Checked By: RWL
Approved By: AEB

TTCI
HOUSE 201
SIGNAL LIGHTING CIRCUITS

Scale: NTS
CADD File Name: 201005.DWG
Submitted Date: 04/03/13
Sheet No: 005

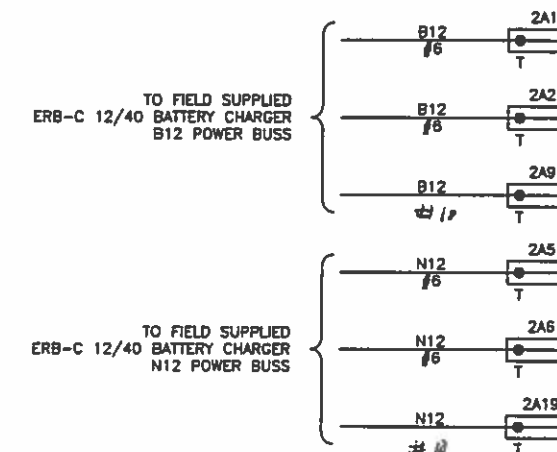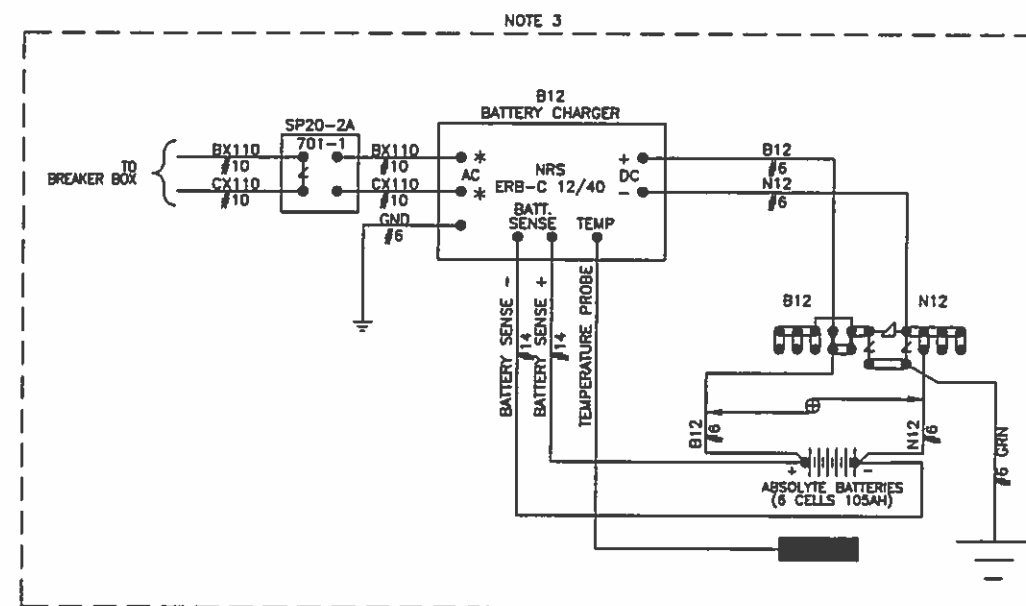

NEW SHEET

NOTES:

- 1) ALL SIGNAL WIRING ON THIS SHEET TO BE #10 AWG UNLESS OTHERWISE NOTED.
- 2)  = TWISTED PAIR 2 TURNS PER FOOT.
- 3) FIELD SUPPLIED

				Designed By:	BPC	TTCI HOUSE 201 POWER DISTRIBUTION CIRCUITS RACK 2	Scale: NTS	
				Drawn By:	BPC		CADD File Name: 201007a.DWG	
				Checked By:	BDW		Submitted Date: 03/19/15	
				Approved By:	AEB			
1	03/19/15	AS-DESIGNED FOR TTT PROJECT						Sheet No. 007a
REV	DATE	DESCRIPTION						

V71-2S
PERSONALITY
MODULE
(SLOT 1)

TK 1+	14TB	X	1
TK 1-	14TN	X	2
			3
TK 2+	15TB	X	4
TK 2-	15TN	X	5
			6
			7

J3

CAB1+	14-100CEN	X	1
CAB1-			2
			3
CAB2+	15-100CEN	X	4
CAB2-			5
			6
IN 1+			7
IN 1-			8
			9
IN 2+			10
IN 2-			11

J4

V10-86S
PERSONALITY
MODULE
(SLOT 2)

IN 1+	301-OT	X	1
IN 1-	N301-OT	X	2
IN 2+	703NWP	X	5
IN 2-	N703NWP	X	6
IN 3+			9
IN 3-			10
IN 4+			13
IN 4-			14
IN 5+			17
IN 5-			18

J3

IN 6+			1
IN 6-			2
IN 7+			5
IN 7-			6
IN 8+			9
IN 8-			10
OUT 6+			17
OUT 6-			18

J4

OUT 1+	14-250CEN	X	1
OUT 1-	N14-250CEN	X	2
OUT 2+	15-250CEN	X	5
OUT 2-	N15-250CEN	X	6
OUT 3+			9
OUT 3-			10
OUT 4+			13
OUT 4-			14
OUT 5+			17
OUT 5-			18

J5

V10-R16S
PERSONALITY
MODULE
(SLOT 3)

BANK 1

LAMP1	201AGE	X	1
LAMP2	201AYE	X	2
LAMP3	201ARE1	X	3
LAMP4	201BRE1	X	4
LAMP5	301AGE	X	5
LAMP6	301AYE	X	6
LAMP7	301ARE1	X	7
LAMP8	301BRE1	X	8
			9
LAMPB1	LAMPB12	X	10
LAMPB1	LAMPB12	X	11
LAMPN1	LAMPN12	X	12
			13
VSSR1+	1SIGSTOPR	X	14
VSSR1-	N1SIGSTOPR	X	15

J3

BANK 2

LAMP9	602SARE1	X	1
LAMP10	602SBGE	X	2
LAMP11	602SBYE	X	3
LAMP12	602SBRE1	X	4
LAMP13	602SAGE	X	5
LAMP14	602SAYE	X	6
LAMP15	201BYE	X	7
LAMP16	301BYE	X	8
			9
LAMPB2	LAMPB12	X	10
LAMPB2	LAMPB12	X	11
LAMPN2	LAMPN12	X	12
			13
VSSR2+	2SIGSTOPR	X	14
VSSR2-	N2SIGSTOPR	X	15

J4

V71-2S
PERSONALITY
MODULE
(SLOT 4)

TK 1+	1TB	X	1
TK 1-	1TN	X	2
			3
TK 2+	2TB	X	4
TK 2-	2TN	X	5
			6
			7

J3

CAB1+	1-100CEN	X	1
CAB1-			2
			3
CAB2+	2-100CEN	X	4
CAB2-			5
			6
IN 1+			7
IN 1-			8
			9
IN 2+			10
IN 2-			11

J4

PERSONALITY MODULE
LEGEND

TERMINAL LABEL → XXX XXXX [X] X → PIN NUMBER

APPLICATION DESCRIPTION WIRE PRESENT

○ ○ ○ ADDED

× × × DELETED

REV	DATE	DESCRIPTION
3	03/30/15	DELETED 703-OT CONNECTIONS TO V10-86S INPUT 3.
2	03/19/15	ADDED TTT V71-2S & TTT AFTACH TRACK V10-86S INPUT.
1	11/26/14	AS-IN SERVICE







Designed By:	BDV
Drawn By:	SAT
Checked By:	RWL
Approved By:	AEB

TTCI

HOUSE 201

ELECTROLOGIXS 4-SLOT
MODULE CONNECTOR USAGE

Scale:	NTS
CADD File Name:	201008.DWG
Submitted Date:	04/03/13
Sheet No.	008

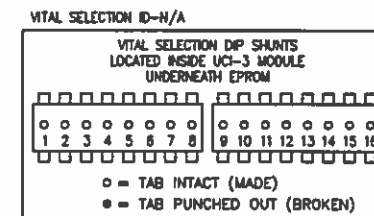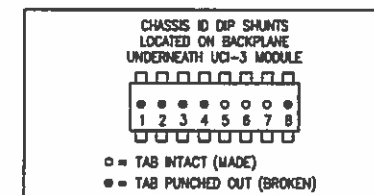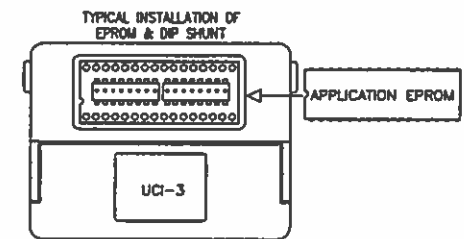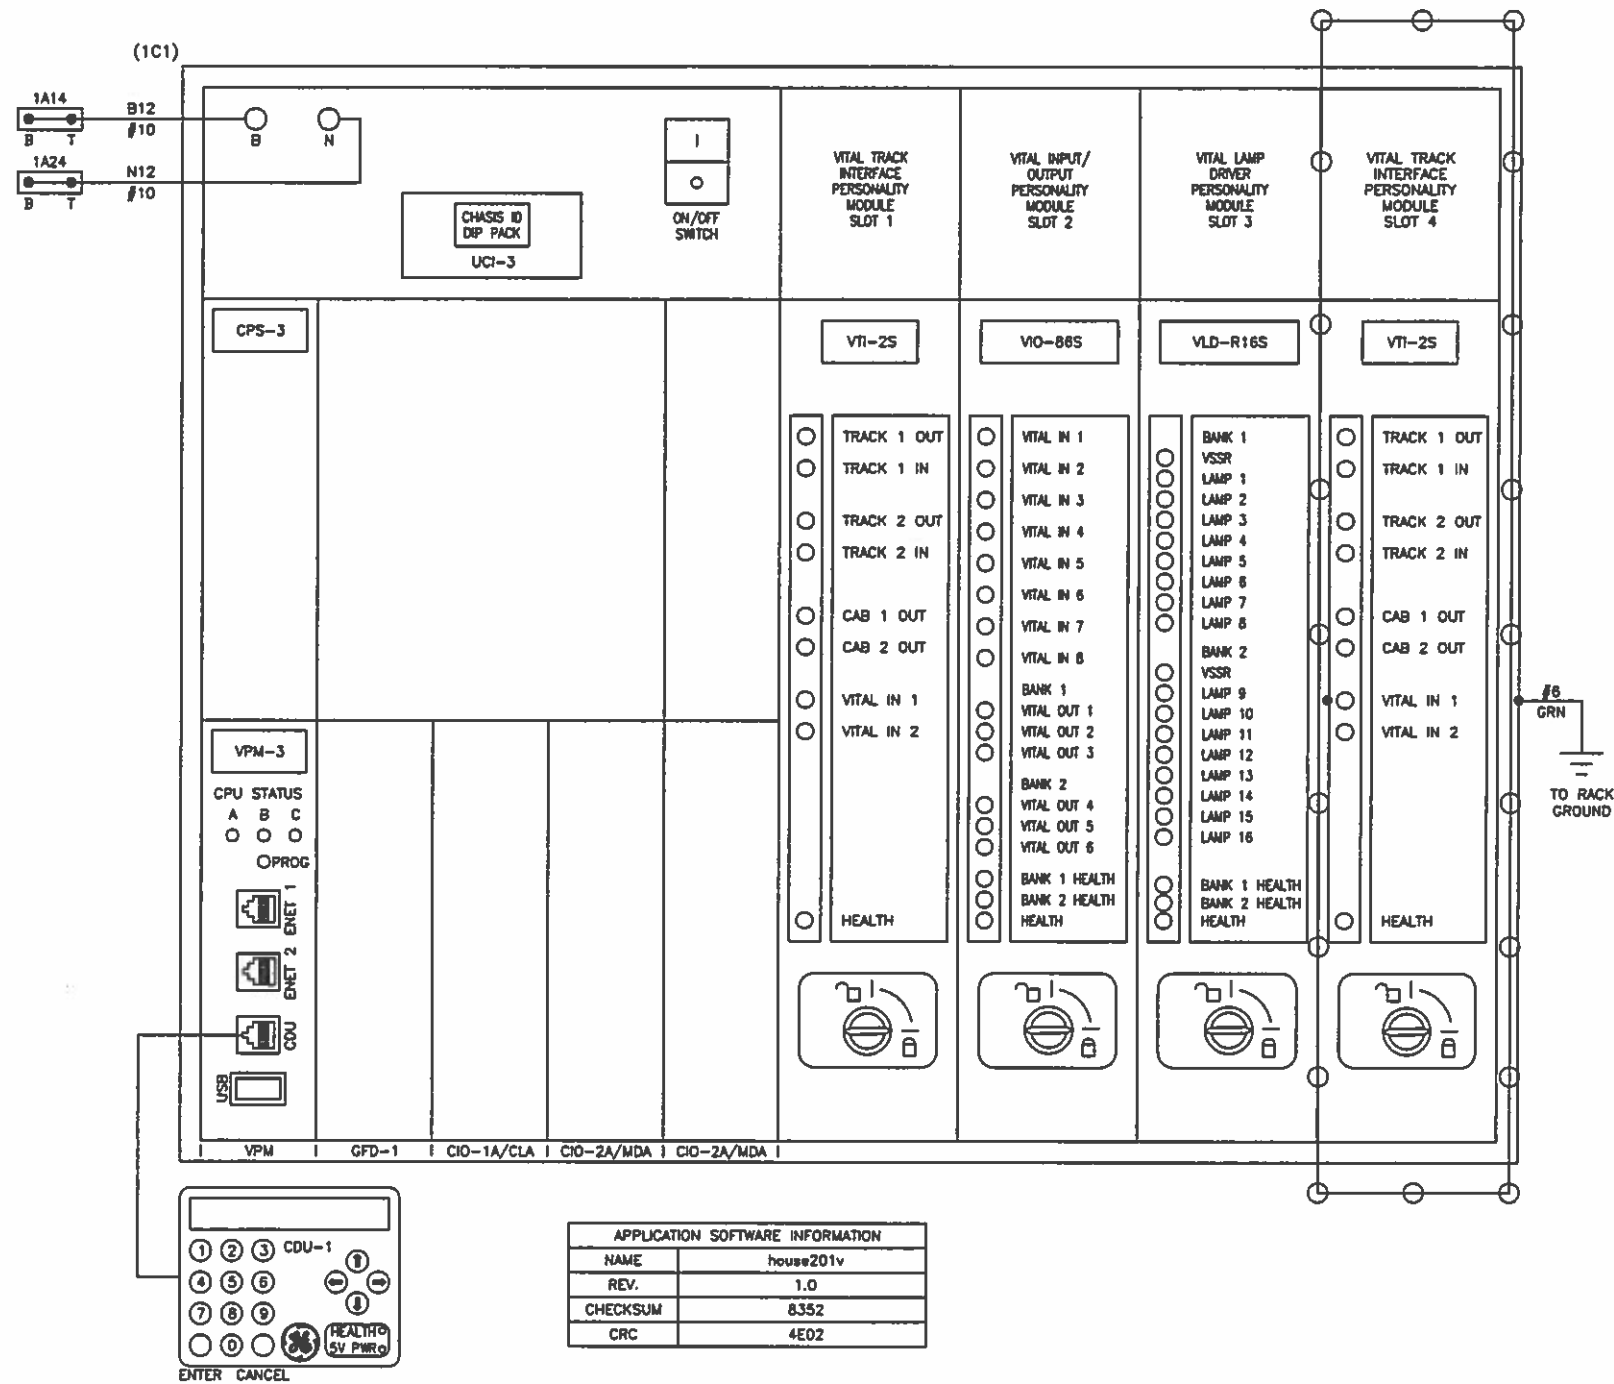

NOTES:

CDU-1 = CONTROL DISPLAY UNIT
CPS-3 = CENTRAL POWER SUPPLY
VPM-3 = VITAL PERIPHERAL MASTER MODULE
UCI-3 = CHASSIS INFORMATION MODULE
VTI-2S = VITAL TRACK INTERFACE
VLD-86S = VITAL LAMP DRIVER MODULE
VIO-86S = VITAL INPUTS/OUTPUTS
CIO-1A = COMMUNICATION INPUT/OUTPUT
CIO-MDA = COMMUNICATION INPUT/OUTPUT

○ ○ ○ ADDED
X X X DELETED

Designed By: BDV
Drawn By: SAT
Checked By: RWL
Approved By: AEB

TTCI

HOUSE 201

ELECTROLOGIXS 4-SLOT
HARDWARE CONFIGURATION

Scale: NTS
CADD File Name: 201009.DWG
Submitted Date: 04/03/13
Sheet No. 009

GETS
Global Signaling

REV	DATE	DESCRIPTION
2	03/19/15	ADDED VTI-2S FOR TTT TRACK
1	11/26/14	AS-IN SERVICE

SYSTEM CONFIGURATION				
DATE/TIME	SETTING MADE WHEN USING PTC CONFIGURATION			
DIAGNOSTIC PORT				
ETHERNET CONFIG.				
OFFICE CONFIG	NA			
LCP CONFIG	ENABLED	FALSE		
VITAL REMOTE CONFIG	LOCAL PORT	REMOTE PORT	REMOTE PORT CONFIG	
	ETHERNET PORT 1 192.168.40.14	1	IP	192.168.40.18
			PORT	8284
			LOCAL NETWORK ID	513
			REMOTE NETWORK ID	18
			PROTOCOL	RP2000
			DATE/TIME UPDATE	ENABLED
			MAC	DISABLED
			KEY IN USE	NO
		2	IP	192.168.40.71
			PORT	8290
			LOCAL NETWORK ID	18
			REMOTE NETWORK ID	71
			PROTOCOL	RP2000
			DATE/TIME UPDATE	ENABLED
			MAC	DISABLED
			KEY IN USE	NO
		3	IP	192.168.40.78
			PORT	8291
			LOCAL NETWORK ID	19
			REMOTE NETWORK ID	78
			PROTOCOL	RP2000
			DATE/TIME UPDATE	ENABLED
			MAC	DISABLED
			KEY IN USE	NO
	ETHERNET PORT 2 TBD	NA	NA	NA
	SERIAL PORT 2		NA	
	SERIAL PORT 3		NA	

TRACK CONFIG	SLOT	TRACK	CONFIGURATION	
			TRANSMITTER	4V
	SLOT 1: 14T_T11	1	RECEIVER	0.5A
			CODE 5 TYPE	ALT 5
			TRANSMITTER	4V
	SLOT 1: 15T_T11	2	RECEIVER	0.5A
			CODE 5 TYPE	ALT 5
			TRANSMITTER	4V
	SLOT 4: 1T_T11	1	RECEIVER	0.5A
			CODE 5 TYPE	ALT 5
			TRANSMITTER	4V
	SLOT 4: 2T_T11	2	RECEIVER	0.5A
			CODE 5 TYPE	ALT 5

—○—○—○— ADDED
—X—X—X— DELETED

NOTES:
1. FINAL VITAL CONFIGURATION SETTINGS ARE SUBJECT TO CHANGE IN ACCORDANCE WITH SOFTWARE UPGRADES. FINAL VITAL CONFIGURATION SETTINGS TO BE UPDATED ON AS-IN-SERVICE.
2. XX = TO BE FILLED OUT DURING FIELD/FACTORY TESTING.
* = FIELD ADJUSTMENT


2	03/19/15	ADDED REMOTE NETWORK AND TRACK CONFIG FOR TTT.
1	11/26/14	AS-IN SERVICE
REV	DATE	DESCRIPTION




Designed By:	BDV
Drawn By:	SAT
Checked By:	RWL
Approved By:	AEB

TTCI
HOUSE 201
ELECTROLOGIXS 4-SLOT
CONFIGURATION SETTINGS

Scale:	NTS
CADD File Name:	201010.DWG
Submitted Date:	04/03/13
Sheet No.	010

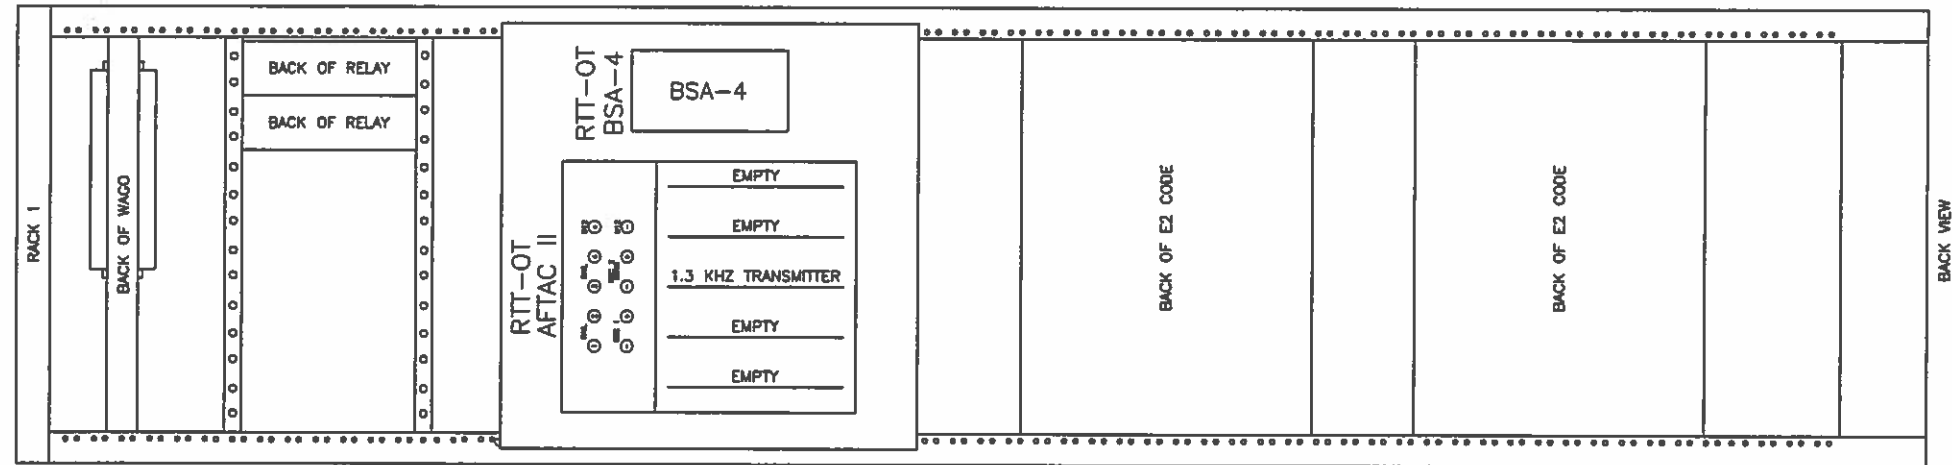

8

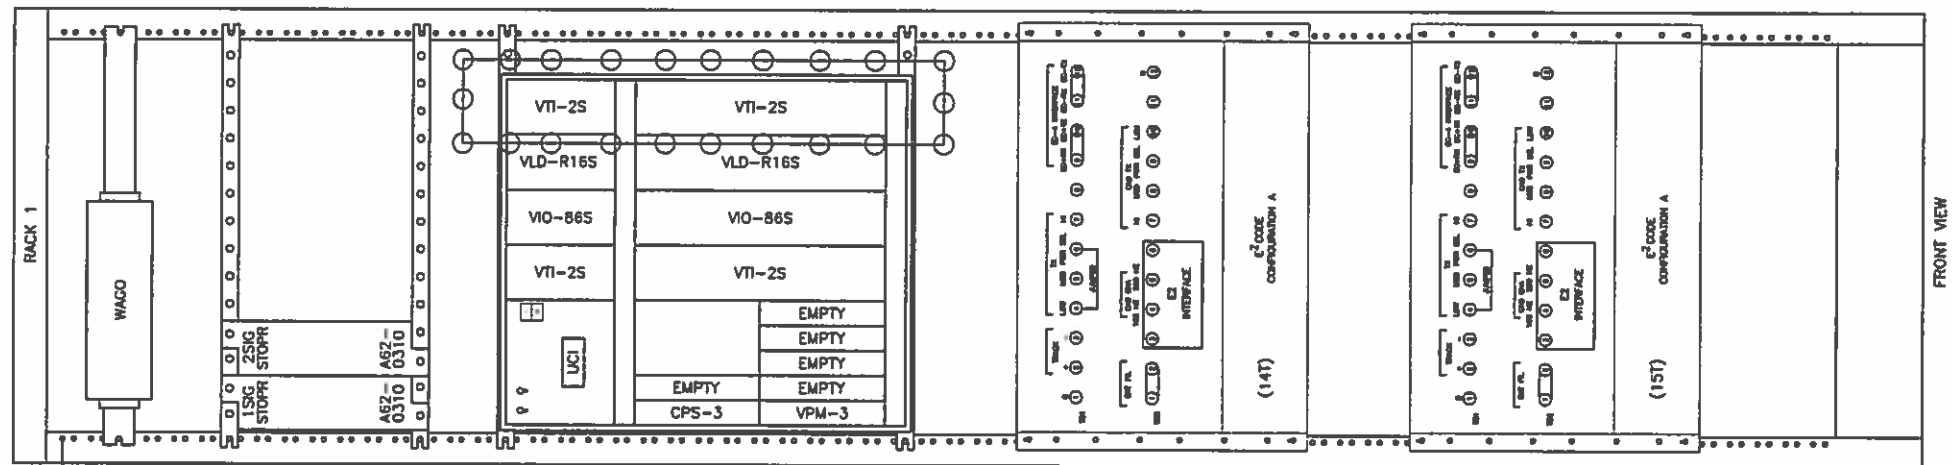

GRN 7/8



○ ○ ○ ADDED
 × × × DELETED



REV	DATE	DESCRIPTION
2	3/19/15	ADDED VTI-25 FOR TTT PROJECT
1	11/26/14	AS-IN SERVICE



Designed By:	BDV
Drawn By:	SAT
Checked By:	RWL
Approved By:	AEB

TTCI
 HOUSE 201
 RACK 1 LAYOUT


Scale:	NTS
CADD File Name:	201011.DWG
Submitted Date:	04/03/13
Sheet No.	011

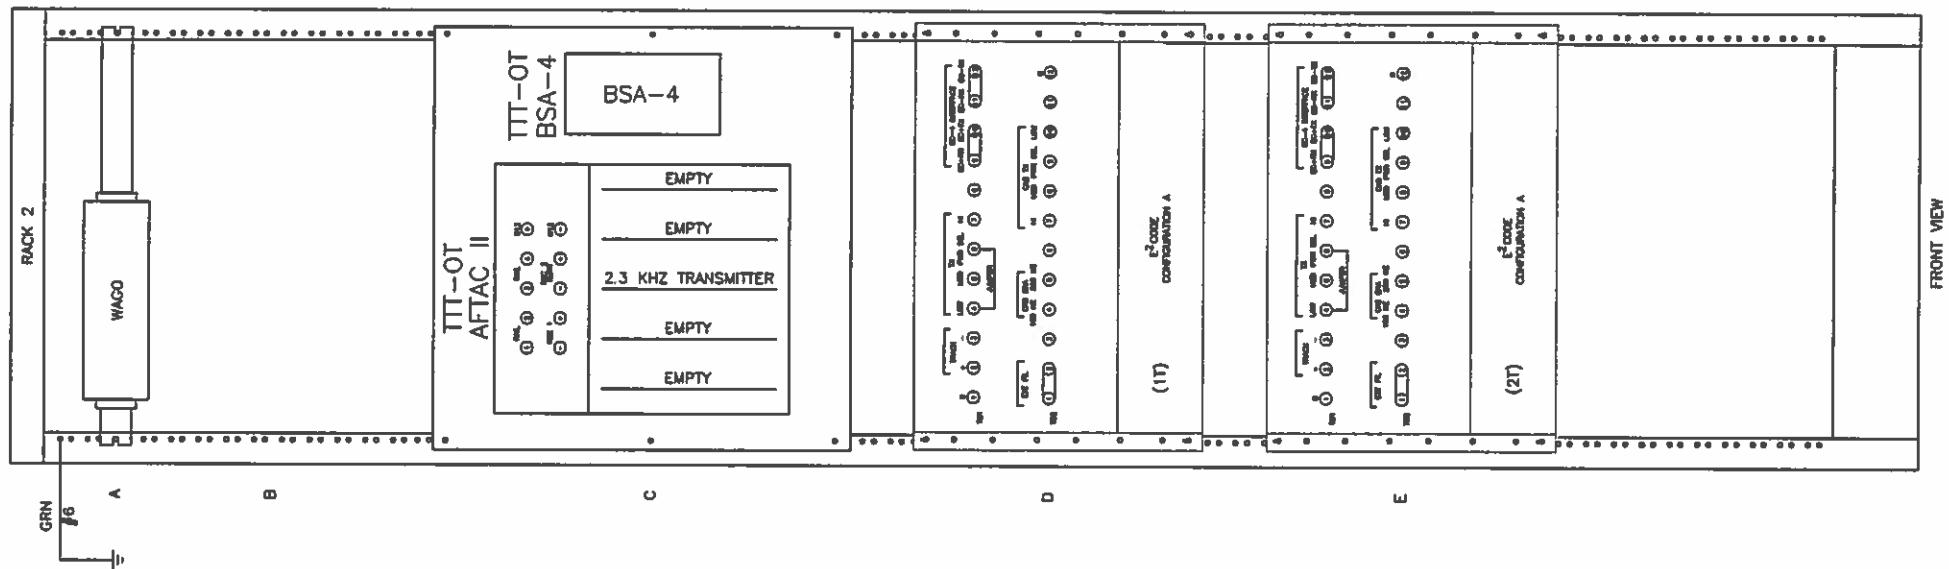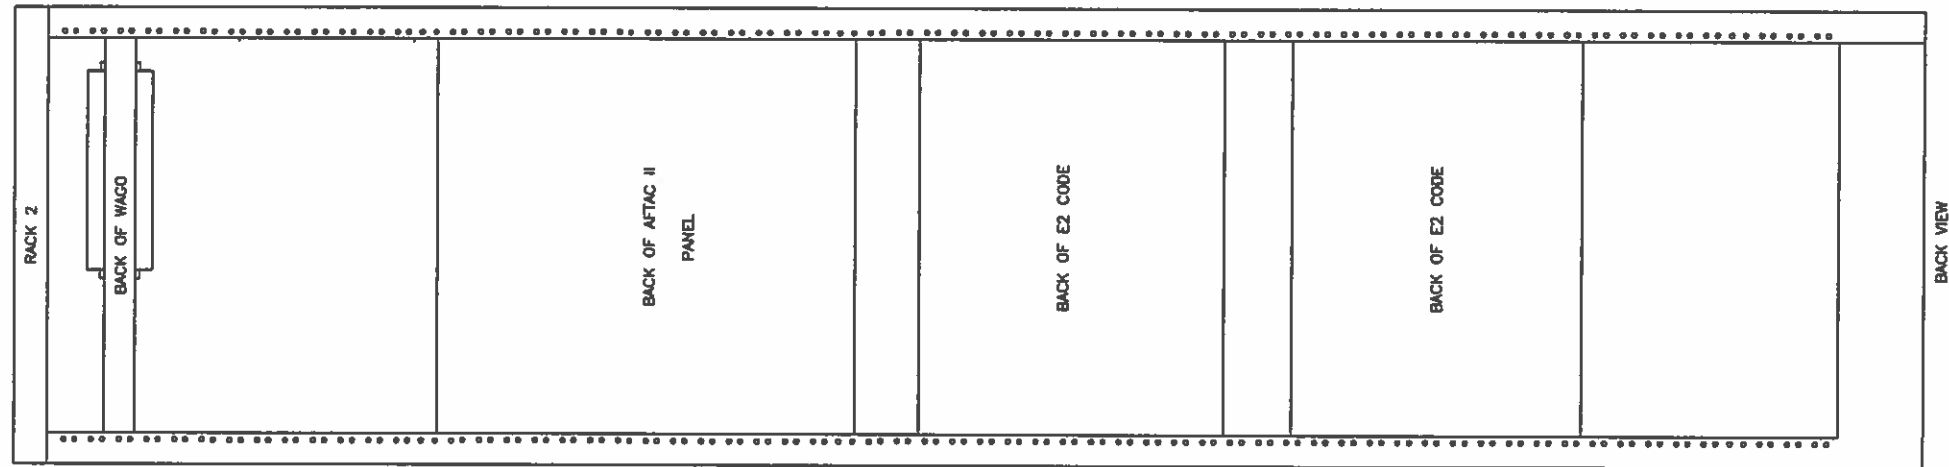

NEW SHEET




				Designed By: BPC		TTCI HOUSE 201 RACK 2 LAYOUT	Scale: NTS						
				Drawn By: BPC			CADD File Name: 201011a.DWG						
				Checked By: BDW			Submitted Date: 03/1915						
				Approved By: AEB									
							Sheet No. 011a						
REV	DATE	DESCRIPTION											
2	03/19/15	AS-DESIGNED FOR TTT PROJECT											
1	11/26/14	AS-IN SERVICE											

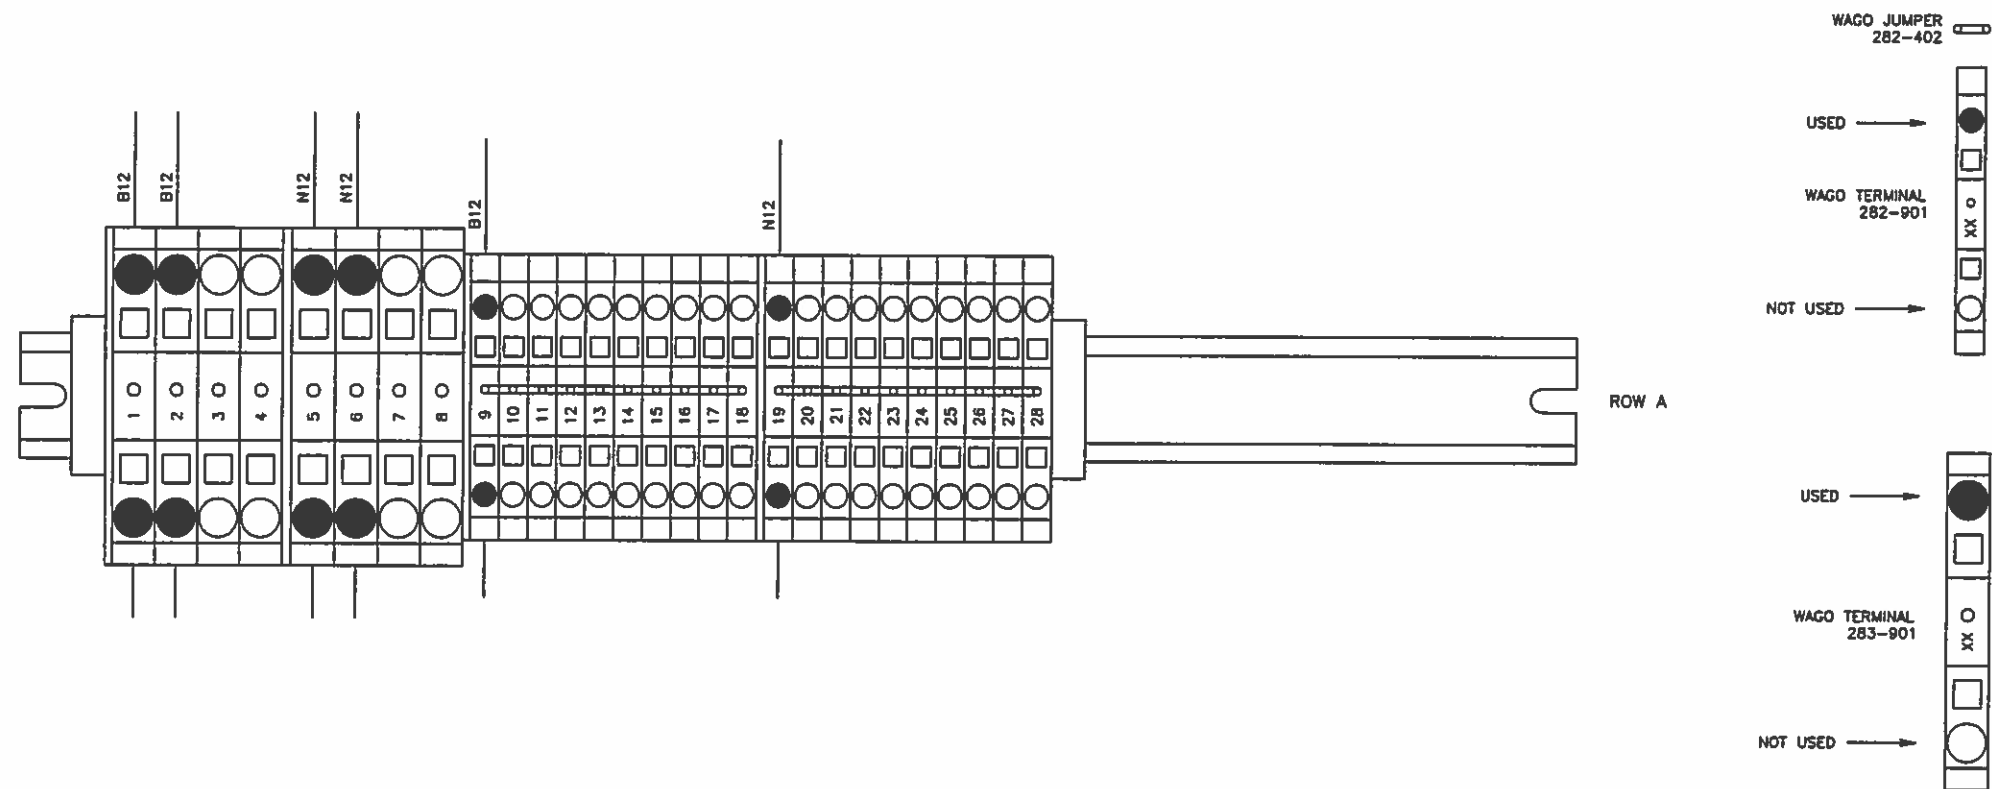

NEW SHEET

				Designed By:	BPC	TTCI HOUSE 201 WAGO & RELAY LAYOUT RACK 2, ROW A	Scale:	NTS
				Drawn By:	BPC		CADD File Name:	201012a.DWG
				Checked By:	BDW		Submitted Date:	03/19/15
				Approved By:	AEB			
1	03/19/15	AS-DESIGNED FOR TTT PROJECT						
REV	DATE	DESCRIPTION						

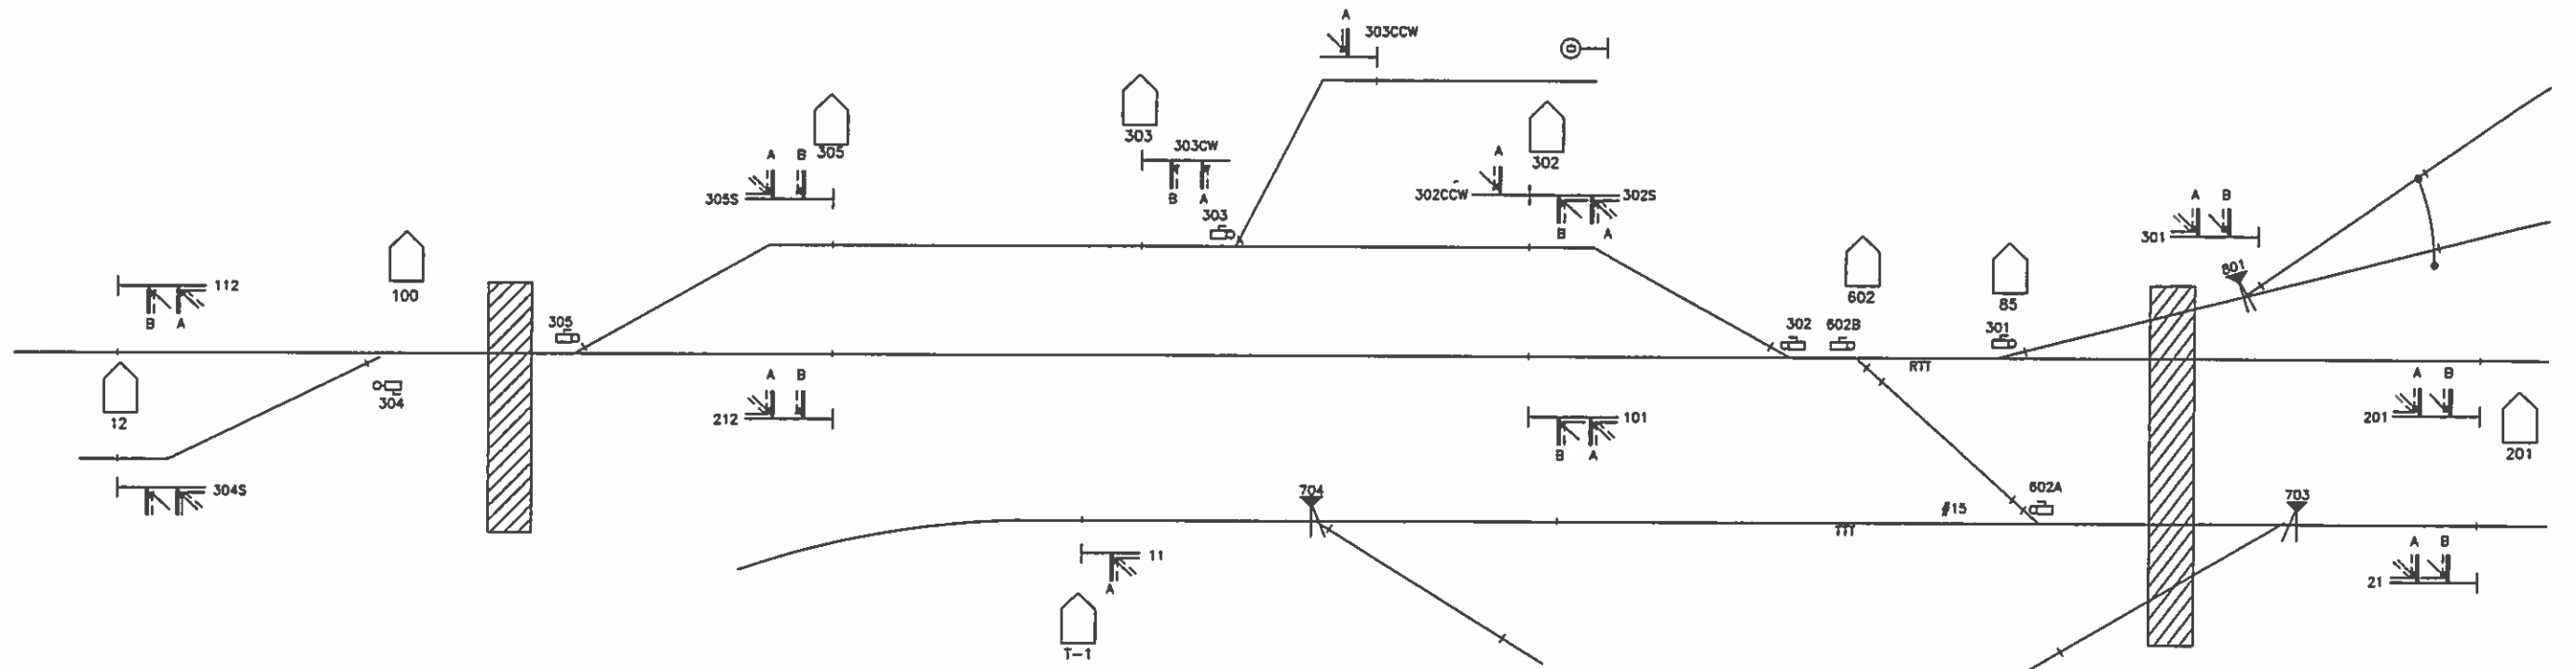

HOUSE 12

RACK 1	
IP ADDRESS: 192.168.40.11	
REMOTE 1	
RP2000 PORT	8280
NETWORK ID	10
REMOTE 2	
RP2000 PORT	8281
NETWORK ID	11
REMOTE 3	
RP2000 PORT	8282
NETWORK ID	12
REMOTE 4	
RP2000 PORT	8288
NETWORK ID	13
REMOTE 5	
RP2000 PORT	8285
NETWORK ID	14

POST 100

RACK 1	
IP ADDRESS: 192.168.40.13	
REMOTE 1	
RP2000 PORT	8280
NETWORK ID	4

HOUSE 305

RACK 1	
IP ADDRESS: 192.168.40.15	
REMOTE 1	
RP2000 PORT	8281
NETWORK ID	5

HOUSE 303

RACK 1	
IP ADDRESS: 192.168.40.12	
REMOTE 1	
RP2000 PORT	8285
NETWORK ID	6
REMOTE 2	
RP2000 PORT	8286
NETWORK ID	7

HOUSE 302

RACK 1	
IP ADDRESS: 192.168.40.18	
REMOTE 1	
RP2000 PORT	8283
NETWORK ID	770
REMOTE 2	
RP2000 PORT	8282
NETWORK ID	119
REMOTE 3	
RP2000 PORT	8287
NETWORK ID	15

RACK 2

RACK 2	
IP ADDRESS: 192.168.40.17	
REMOTE 1	
RP2000 PORT	8286
NETWORK ID	8
REMOTE 2	
RP2000 PORT	8287
NETWORK ID	9

HOUSE 602

RACK 1	
RS400 IP ADDRESS: 192.168.40.16	
REMOTE 1	
RP2000 PORT	8283
NETWORK ID	16
RAW SOCKET	COM 2
VHLC RS232 PORT	B
REMOTE 2	
RP2000 PORT	8284
NETWORK ID	15
RAW SOCKET	COM 4
VHLC RS232 PORT	D

HOUSE T-1

RACK 1	
IP ADDRESS: 192.168.40.71	
REMOTE 1	
RP2000 PORT	8290
NETWORK ID	71

HOUSE 201

RACK 1	
IP ADDRESS: 192.168.40.14	
REMOTE 1	
RP2000 PORT	8284
NETWORK ID	513
REMOTE 2	
RP2000 PORT	8290
NETWORK ID	18
REMOTE 3	
RP2000 PORT	8291
NETWORK ID	19

HOUSE T-6

RACK 1	
IP ADDRESS: 192.168.40.76	
REMOTE 1	
RP2000 PORT	8291
NETWORK ID	76

ADDED
X X X DELETED

REV	DATE	DESCRIPTION
2	03/17/15	ADDED HOUSES T-1 AND T-6
1	11/26/14	AS-IN SERVICE



Designed By:	BPC
Drawn By:	SAT
Checked By:	BDV
Approved By:	AEB

TTCI
HOUSE 201
VITAL REMOTE NETWORKS


Scale:	NTS
CADD File Name:	201013.DWG
Submitted Date:	06/03/14
Sheet No.	013

HOUSE 85

						Designed By: BDV	TTCI HOUSE 85 COVER SHEET	Scale: NTS
						Drawn By: SAT		CADD File Name: 85000.DWG
						Checked By: RWL		Submitted Date: 04/03/13
						Approved By: AEB		
								Sheet No. 000
3	03/30/15	UPDATES AFTER TTCI SITE SURVEY/DESIGN REVIEW						
2	03/19/15	UPDATED FOR TTT PROJECT						
1	11/26/14	AS-IN SERVICE						
REV	DATE	DESCRIPTION						

INDEX OF DRAWINGS			
SHT. NO.	DWG. NO.	REV	DESCRIPTION
000	85000.DWG	3	COVER SHEET
001	85001.DWG	3	INDEX
002	85002.DWG	3	TRACK & SIGNAL PLAN
003	85003.DWG	3	TRACK CIRCUITS
004	85004.DWG	3	WALL LAYOUT

						Designed By:	BDV	TTCI HOUSE 85 INDEX	Scale: NTS	
						Drawn By:	SAT		CADD File Name: 85001.DWG	
						Checked By:	RWL		Submitted Date: 04/03/13	
						Approved By:	AEB			
3	03/30/15	UPDATES AFTER TTCI SITE SURVEY/DESIGN REVIEW								
2	03/19/15	UPDATED FOR TTT PROJECT								
1	11/26/14	AS-IN SERVICE								
REV	DATE	DESCRIPTION								

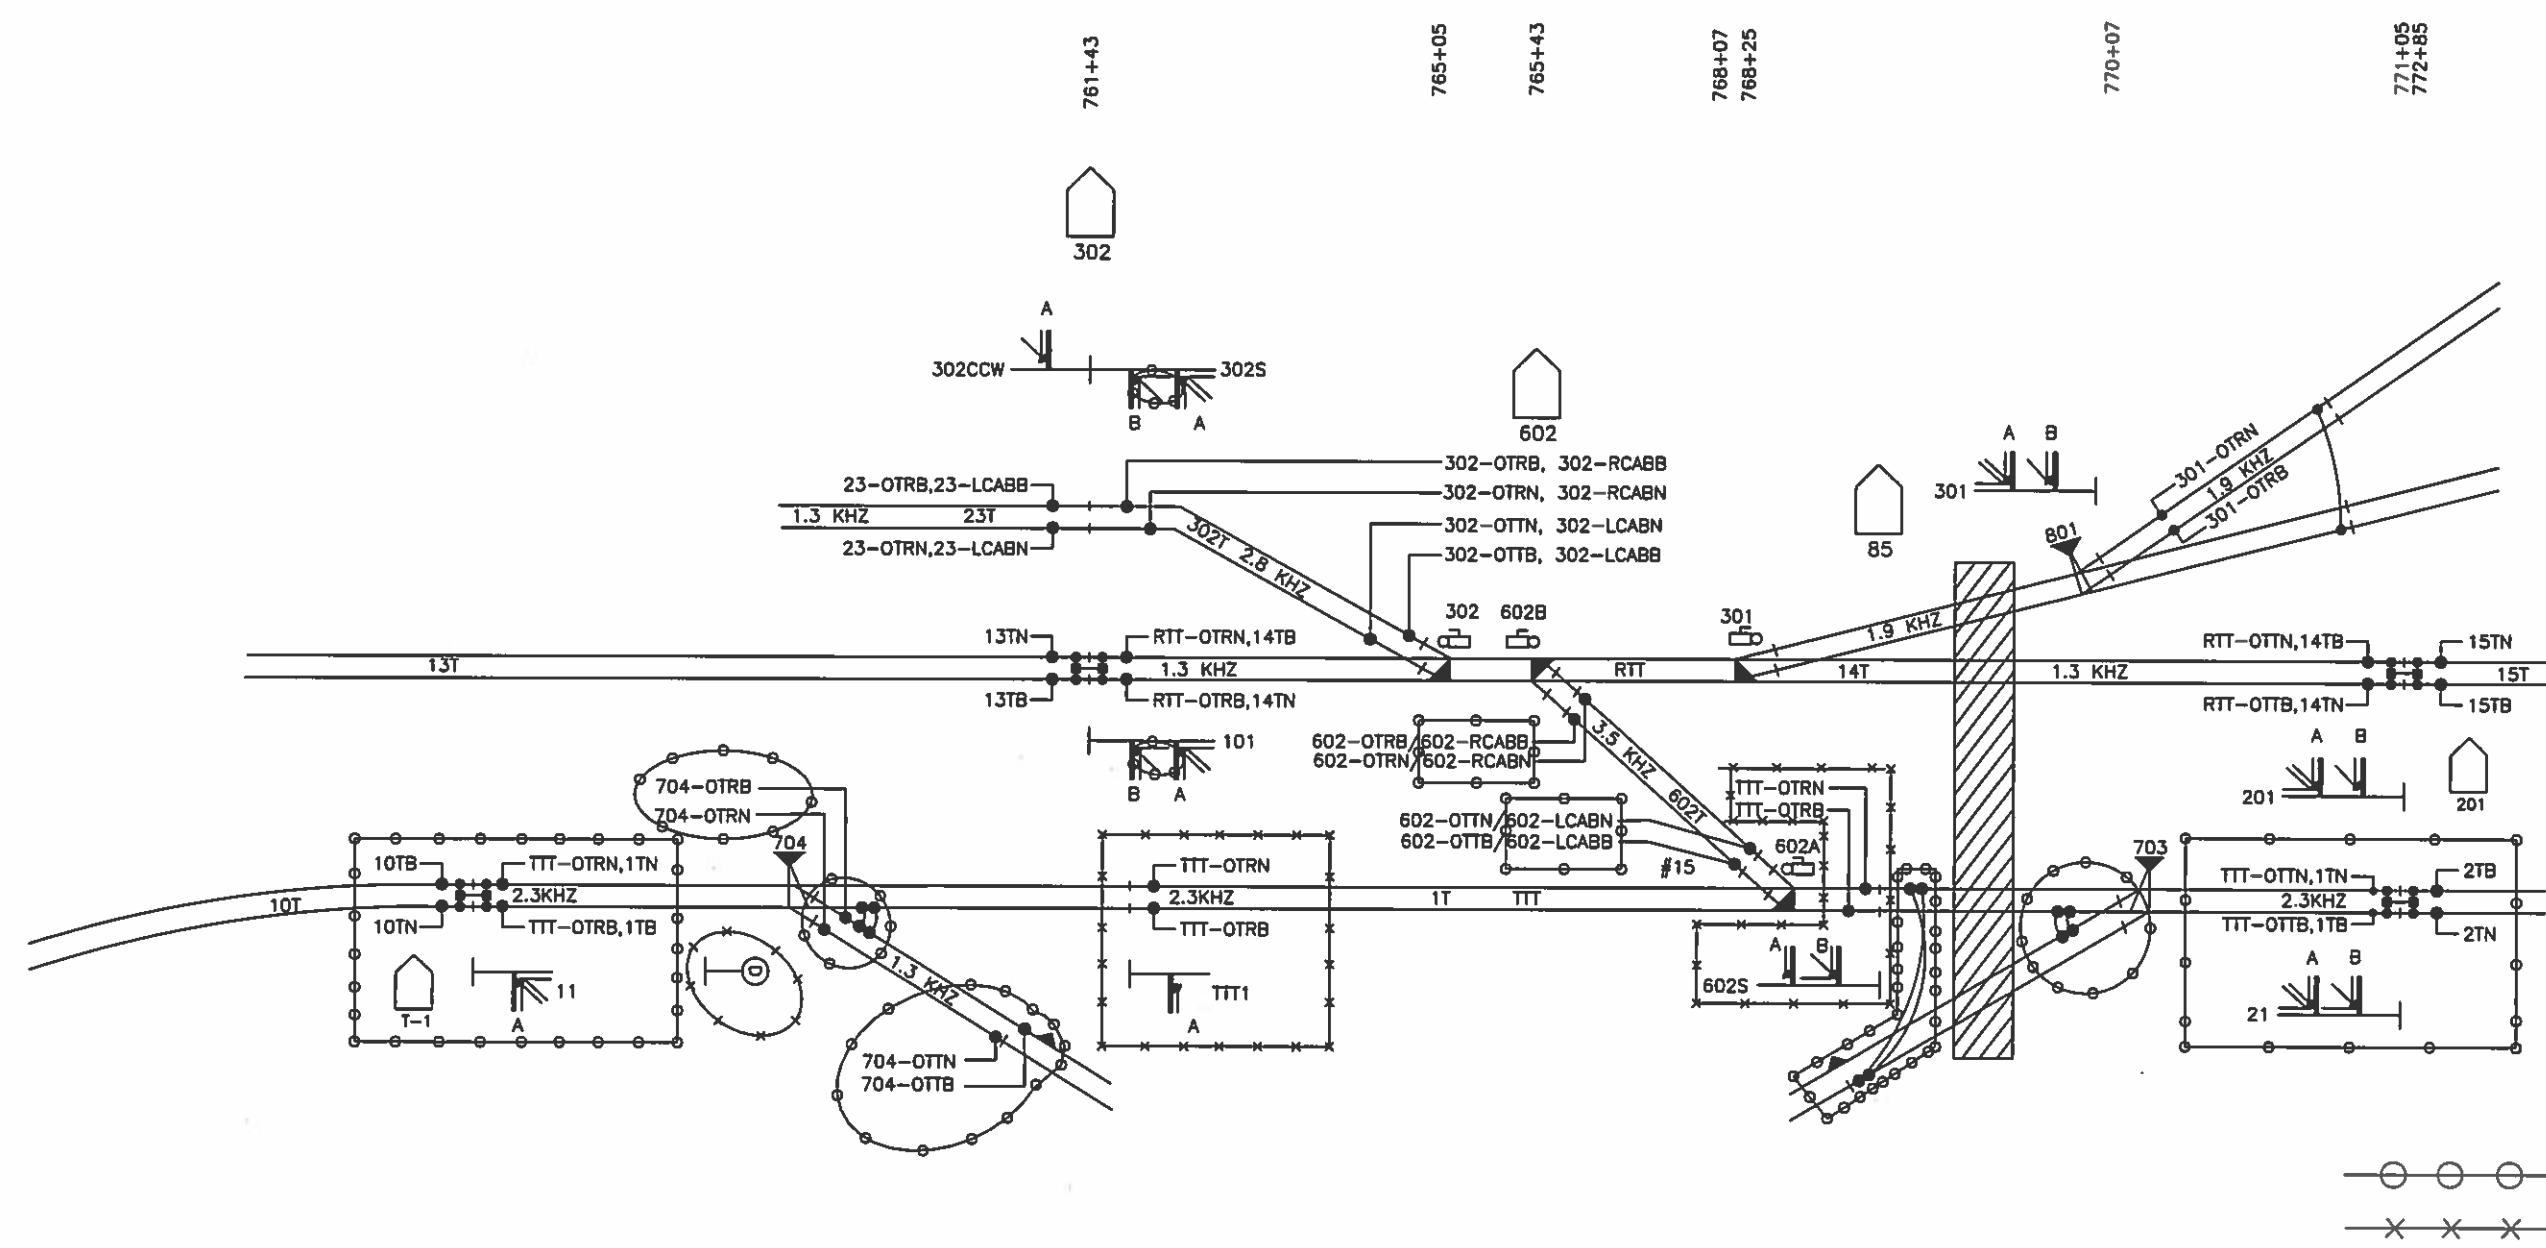


REV	DATE	DESCRIPTION
3	03/30/15	CHANGED 703 & 704 CIRCUITS
2	03/17/15	UPDATED FOR TTT SIGNALING PROJECT
1	11/26/14	AS-IN SERVICE








Designed By:	BDV
Drawn By:	SAT
Checked By:	RWL
Approved By:	AEB

TTCI
HOUSE 85
TRACK & SIGNAL PLAN

Scale:	NTS
CADD File Name:	85002.DWG
Submitted Date:	04/03/13
Sheet No.	002

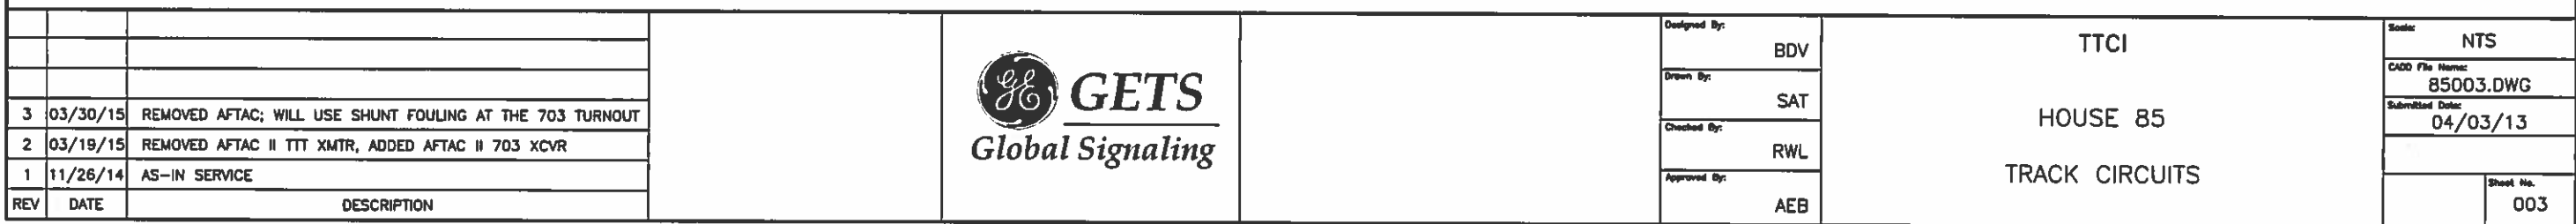

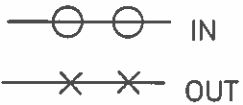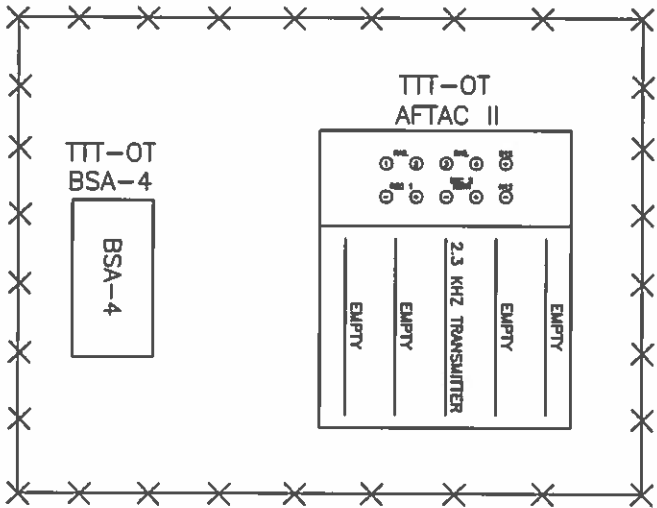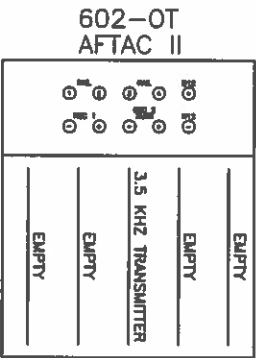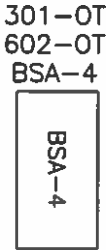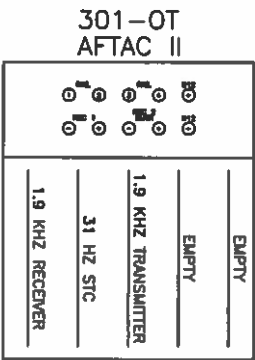

REV	DATE	DESCRIPTION
3	03/30/15	REMOVED AFTAC; WILL USE SHUNT FOULING AT THE 703 TURNOUT
2	03/19/15	REMOVED AFTAC II TTT XMTR, ADDED AFTAC II 703 XCVR
1	11/26/14	AS-IN SERVICE



Designed By:	BDV
Drawn By:	SAT
Checked By:	RWL
Approved By:	AEB

TTCI
HOUSE 85
WALL LAYOUT


Scale:	NTS
CADD File Name:	85004.DWG
Submitted Date:	04/03/13
Sheet No.	004

HOUSE 302

				Designed By: BDV Drawn By: SAT Checked By: RWL Approved By: AEB	TTCI HOUSE 302 COVER SHEET	Scale: NTS	
						CADD File Name: 302000.DWG	
						Submitted Date: 04/03/13	
							Sheet No. 000
3	03/30/15	UPDATES AFTER TTCI SITE SURVEY/DESIGN REVIEW					
2	03/17/15	UPDATED FOR TTT SIGNALING PROJECT					
1	11/26/14	AS-IN SERVICE					
REV	DATE	DESCRIPTION					

INDEX OF DRAWINGS			
SHT. NO.	DWG. NO.	REV.	DESCRIPTION
000	302000.DWG	3	COVER SHEET
001	302001.DWG	3	INDEX
002	302002.DWG	3	TRACK & SIGNAL PLAN
003	302003.DWG	2	CODE & ASPECT CHART
004	302004.DWG	2	TRACK CIRCUITS
005	302005.DWG	2	SIGNAL LIGHTING CIRCUITS (RACK 1)
005a	302005a.DWG	1	SIGNAL LIGHTING CIRCUITS (RACK 2)
006	302006.DWG	1	PTC & COMMUNICATIONS
007	302007.DWG	1	POWER DISTRIBUTION CIRCUITS (RACK 1)
007a	302007a.DWG	1	POWER DISTRIBUTION CIRCUITS
008	302008.DWG	2	ELECTROLOGIXS 4-SLOT MODULE CONNECTOR USAGE (RACK 1)
008a	302008a.DWG	1	ELECTROLOGIXS 4-SLOT MODULE CONNECTOR USAGE (RACK 2)
009	302009.DWG	1	ELECTROLOGIXS 4-SLOT HARDWARE CONFIGURATION (RACK 1)
009a	302009a.DWG	1	ELECTROLOGIXS 4-SLOT HARDWARE CONFIGURATION (RACK 2)
010	302010.DWG	1	ELECTROLOGIXS 4-SLOT CONFIGURATION SETTINGS (RACK 1)
010a	302010a.DWG	1	ELECTROLOGIXS 4-SLOT CONFIGURATION SETTINGS (RACK 2)
011	302011.DWG	2	RACK 1 LAYOUT
011a	302011a.DWG	1	RACK 2 LAYOUT
012	302012.DWG	1	WAGO & RELAY LAYOUT RACK 1, ROW A & B
012a	302012a.DWG	1	WAGO & RELAY LAYOUT RACK 2, ROW A & B
013	302013.DWG	2	VITAL REMOTE NETWORKS

				Designed By:	TTCI HOUSE 302 INDEX	Scale: NTS
				BDV		
				Drawn By:		
				SAT		
				Checked By:		CADD File Name: 302001.DWG
3	03/30/15	UPDATES AFTER TTCI SITE SURVEY/DESIGN REVIEW		Approved By:		Submitted Date: 04/04/14
2	03/17/15	UPDATED FOR TTT SIGNALING PROJECT		RWL		
1	11/26/14	AS-IN SERVICE		AEB		Sheet No. 001
REV	DATE	DESCRIPTION				

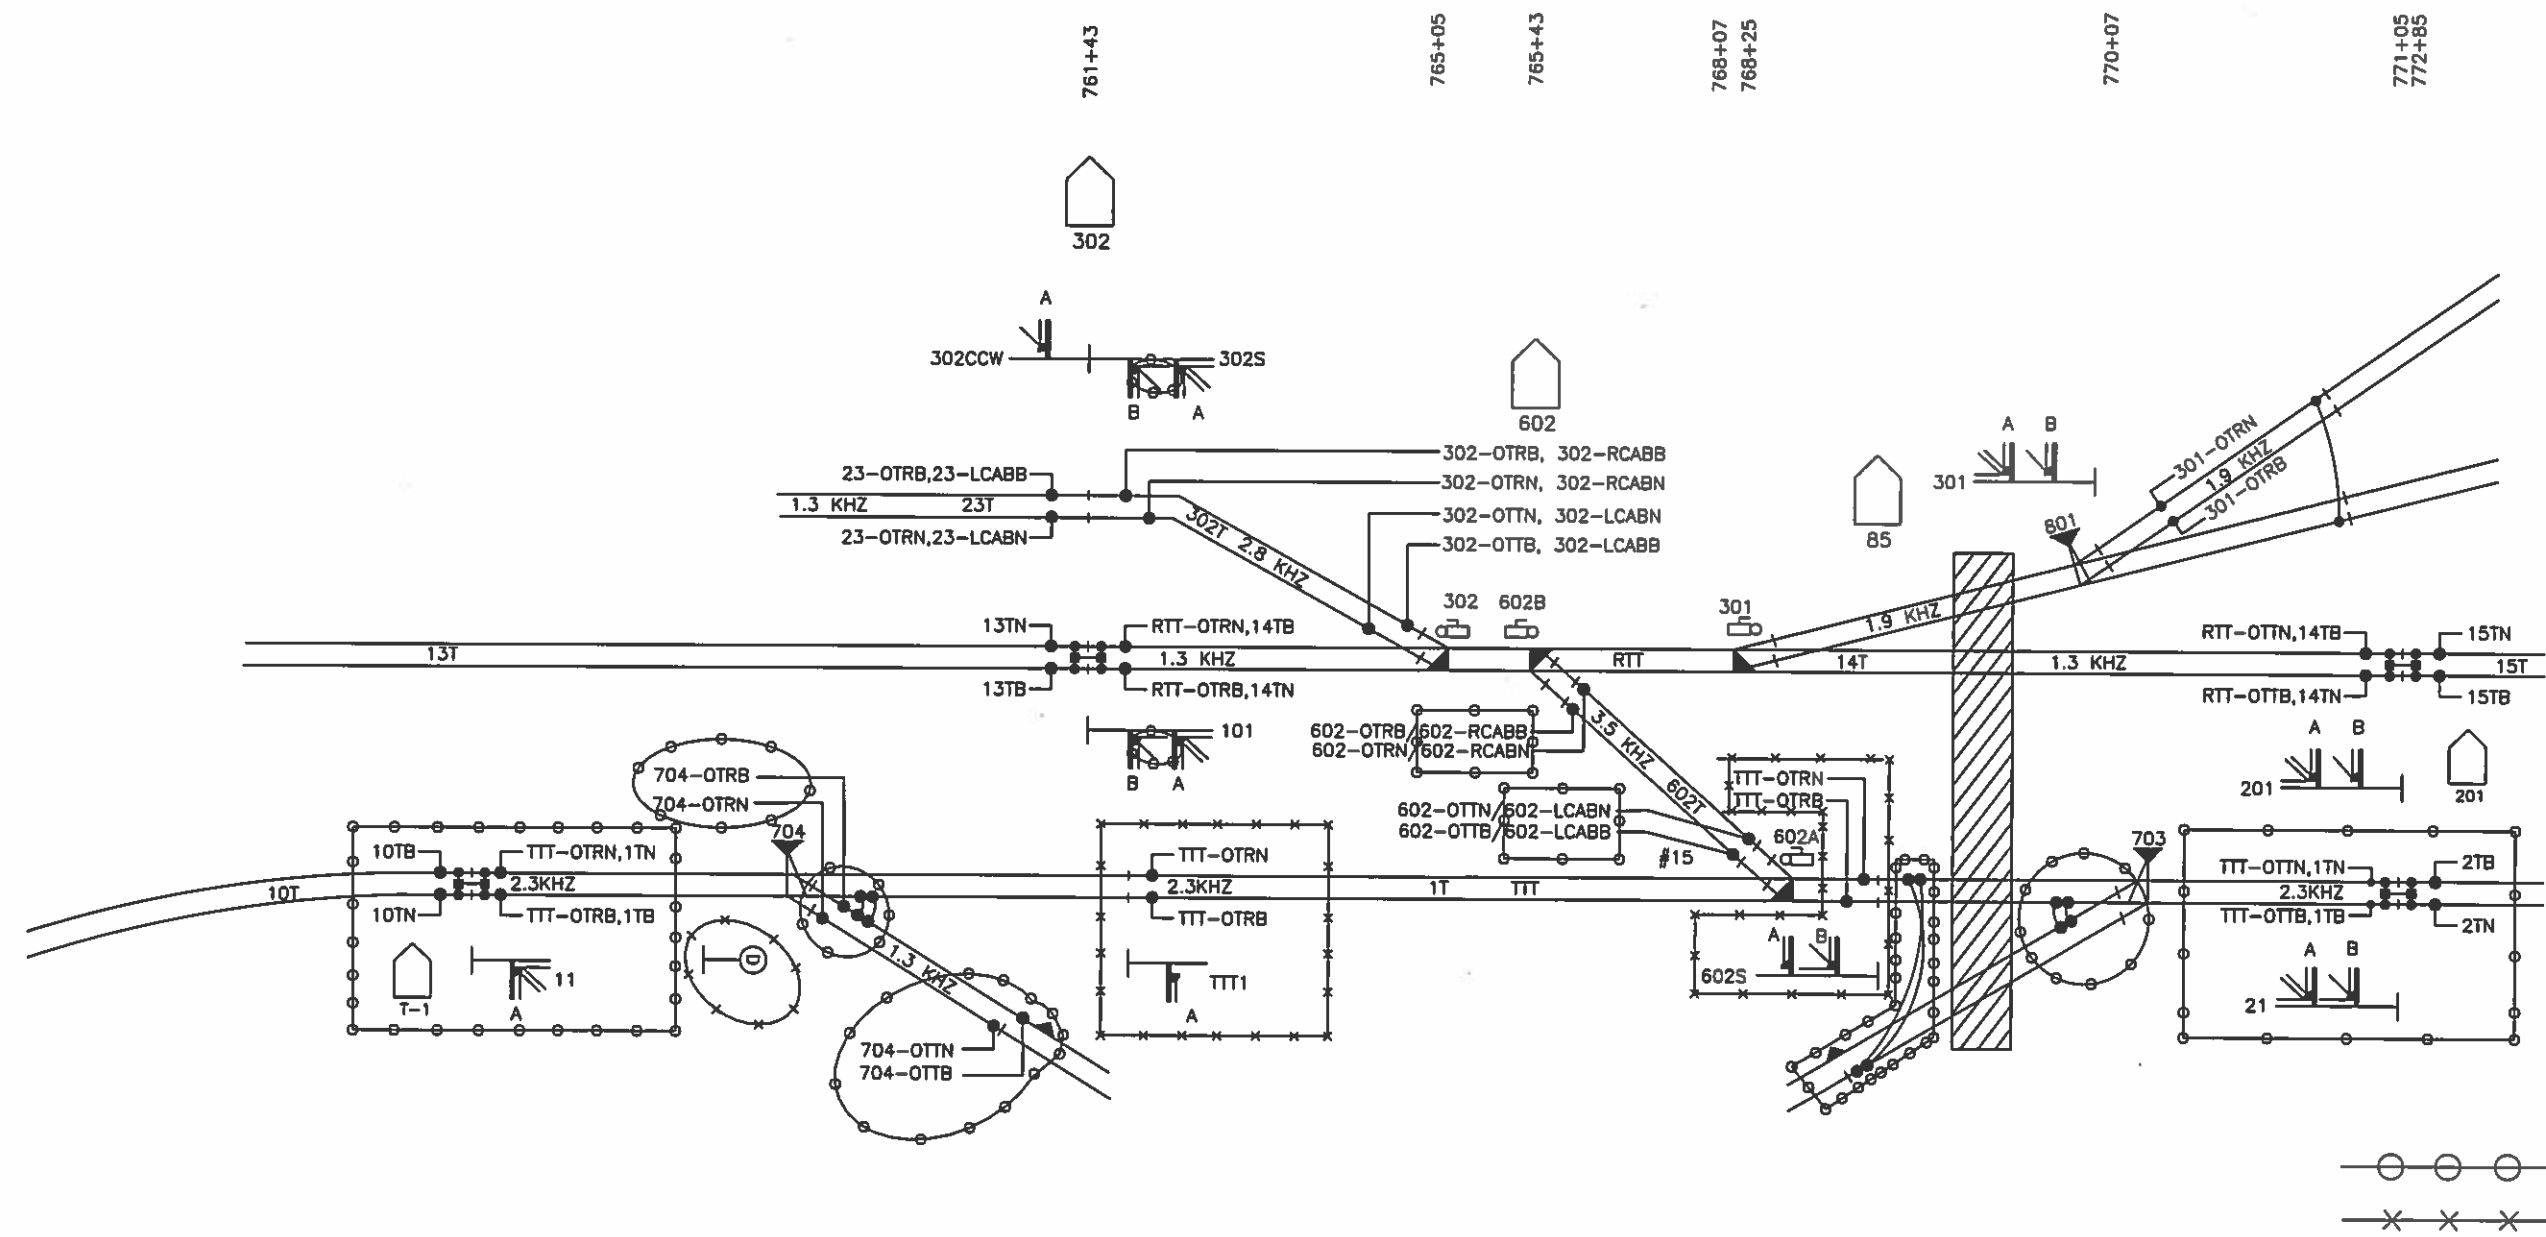

REV	DATE	DESCRIPTION
3	03/30/15	CHANGED 703 & 704 CIRCUITS
2	03/17/15	UPDATED FOR TTT SIGNALING PROJECT
1	11/26/14	AS-IN SERVICE




Designed By:	BDV
Drawn By:	SAT
Checked By:	RWL
Approved By:	AEB

TTCI
HOUSE 302
TRACK & SIGNAL PLAN


Scale:	NTS
CADD File Name:	302002.DWG
Submitted Date:	04/10/14
Sheet No.	002

LAMP OUT DOWNGRADES FOR 302CCW					
CODE IN	LAMP OUT	ASPECT	PTC	CODE OUT	CAB RATE
8	Y	FR	13	8	120/-
2	R	D	30	9	75/-
*NO CODE	R	D	30	9	75/-

* OR SIGNAL AT STOP

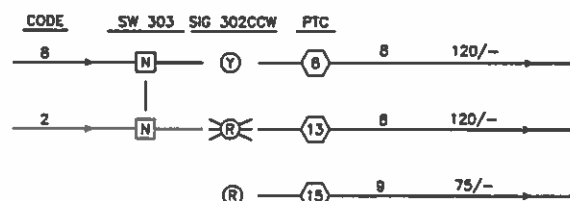


LAMP OUT DOWNGRADES FOR TTT1				
CODE IN	LAMP OUT	ASPECT	PTC	CODE OUT
-	R	D	30	-

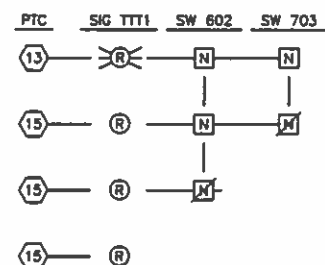

CAB RATE TABLE		
NAME	DESIGNATOR	RATE
Clear (150)	C150	180/180
Clear (125)	C125	180/-
Cab Speed (80)	CS80	120/120
Cab Speed (60)	CS60	270/-
Approach Limited (??)	AL??	120/-
Approach Medium (??)	AM??	75/75
Approach	A	75/-


LAMP OUT DOWNGRADES FOR 101					
CODE IN	LAMP OUT	ASPECT	PTC	CODE OUT	CAB OUT
7,9	TOP G	FY/R	8	7	180/-
3,4,7,8,9	TOP G & Y	FR/R	13	8	75/-
3,4,7,8,9	ALL TOP	D/FR	13	8	75/-
7	BOTTOM R	G/D	3	7	180/180
8	BOTTOM R	Y/D	8	3	270/-
3	BOTTOM R	FY/D	6	4	120/120
4	BOTTOM R	FY/D	6	7	180/-
9	BOTTOM R	G/D	3	7	180/180
*NO CODE	TOP R	D/R	15	8	75/-
*NO CODE	BOTTOM R	R/D	15	8	75/-
DIVERGING	TOP R	D/FR	13	8	120/-
DIVERGING,7	BOTTOM G	R/FY	11	8	120/-
DIVERGING,7,4,8	BOTTOM G & Y	R/FR	13	8	120/-
DIVERGING	ALL BOTTOM	FR/D	13	8	120/-
ALL CODES	ALL TOP & BOTTOM	D/D	30	8	75/-

* OR SIGNAL AT STOP

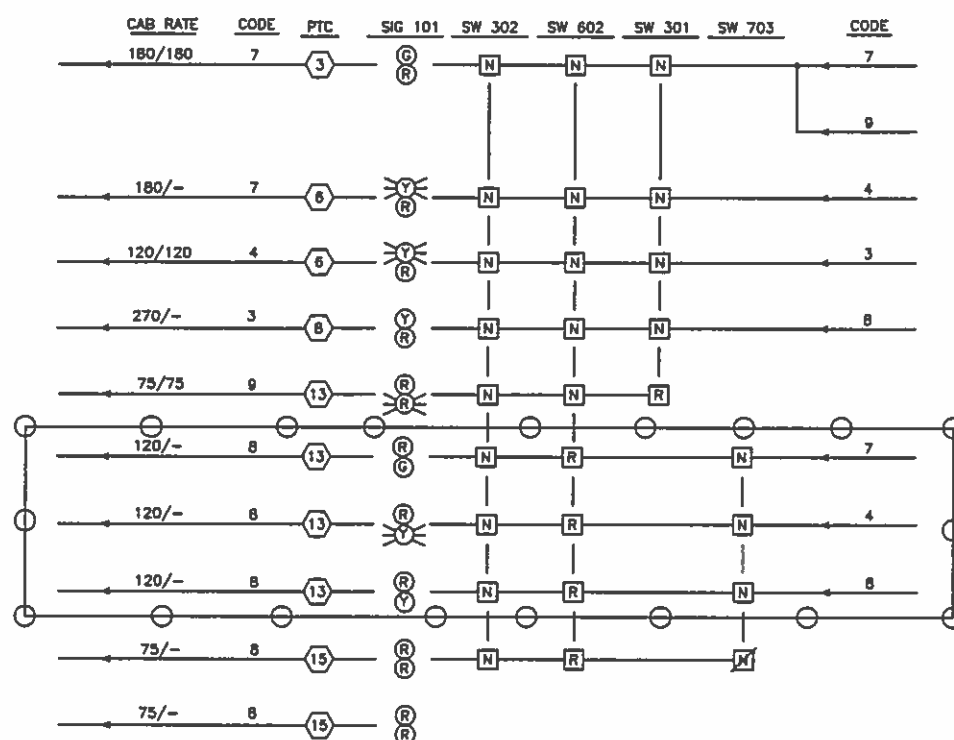

LAMP OUT DOWNGRADES FOR 302S					
CODE IN	LAMP OUT	ASPECT	PTC	CODE OUT	CAB OUT
7,9	TOP G	FY/R	8	8	120/-
3,4,7,8,9	TOP G & Y	FR/R	13	8	120/-
3,4,7,8,9	ALL TOP	D/FR	13	8	120/-
7	BOTTOM R	G/D	3	8	120/-
8	BOTTOM R	Y/D	8	8	120/-
3	BOTTOM R	FY/D	6	8	120/-
4	BOTTOM R	FY/D	6	8	120/-
9	BOTTOM R	G/D	8	8	120/-
*NO CODE	TOP R	D/R	15	2	75/-
*NO CODE	BOTTOM R	R/D	15	8	75/-
DIVERGING	TOP R	D/FR	13	8	120/-
DIVERGING,7	BOTTOM G	R/FY	11	8	120/-
DIVERGING,7,4,8	BOTTOM G & Y	R/FR	13	8	120/-
DIVERGING	ALL BOTTOM	FR/D	13	8	120/-
ALL CODES	ALL TOP & BOTTOM	D/D	30	8	75/-

* OR SIGNAL AT STOP

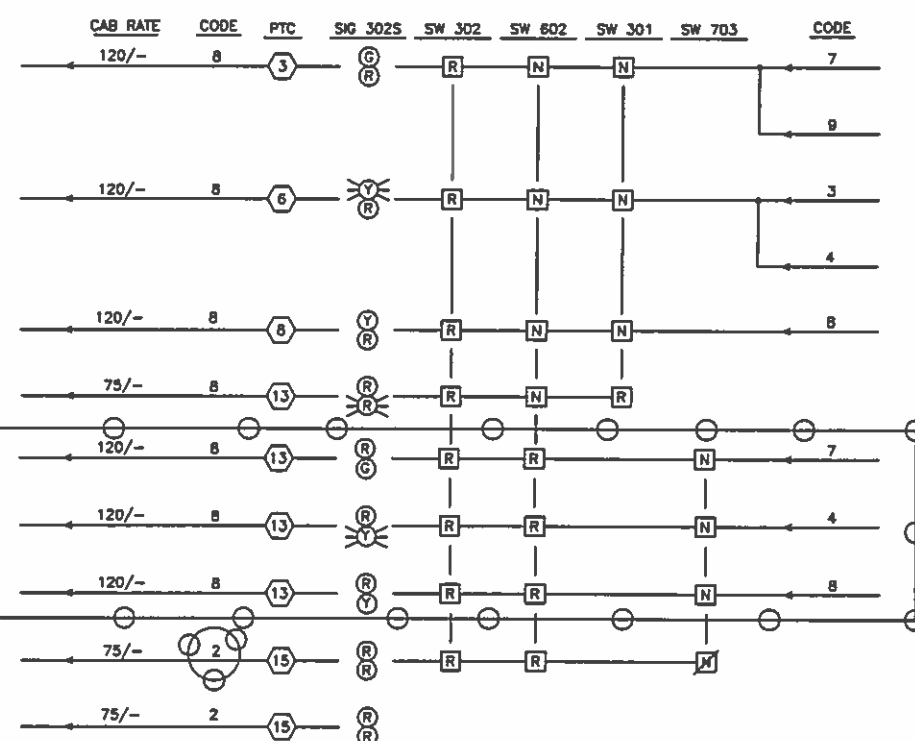

NOTES:

- [N] - SWITCH IN NORMAL POSITION
- [R] - SWITCH IN REVERSE POSITION
- [X] - SWITCH NOT NORMAL


REV	DATE	DESCRIPTION
2	03/17/15	REMOVED TTT-1 SIG, ADDED DIVERGING ROUTES 101& 302S SIGS
1	11/26/14	AS-IN SERVICE



Designed By:	BDV
Drawn By:	SAT
Checked By:	RWL
Approved By:	AEB

TTCI
HOUSE 302
CODE & ASPECT CHART

Scale:	NTS
CADD File Name:	302003.DWG
Submitted Date:	04/10/14
Sheet No.:	003

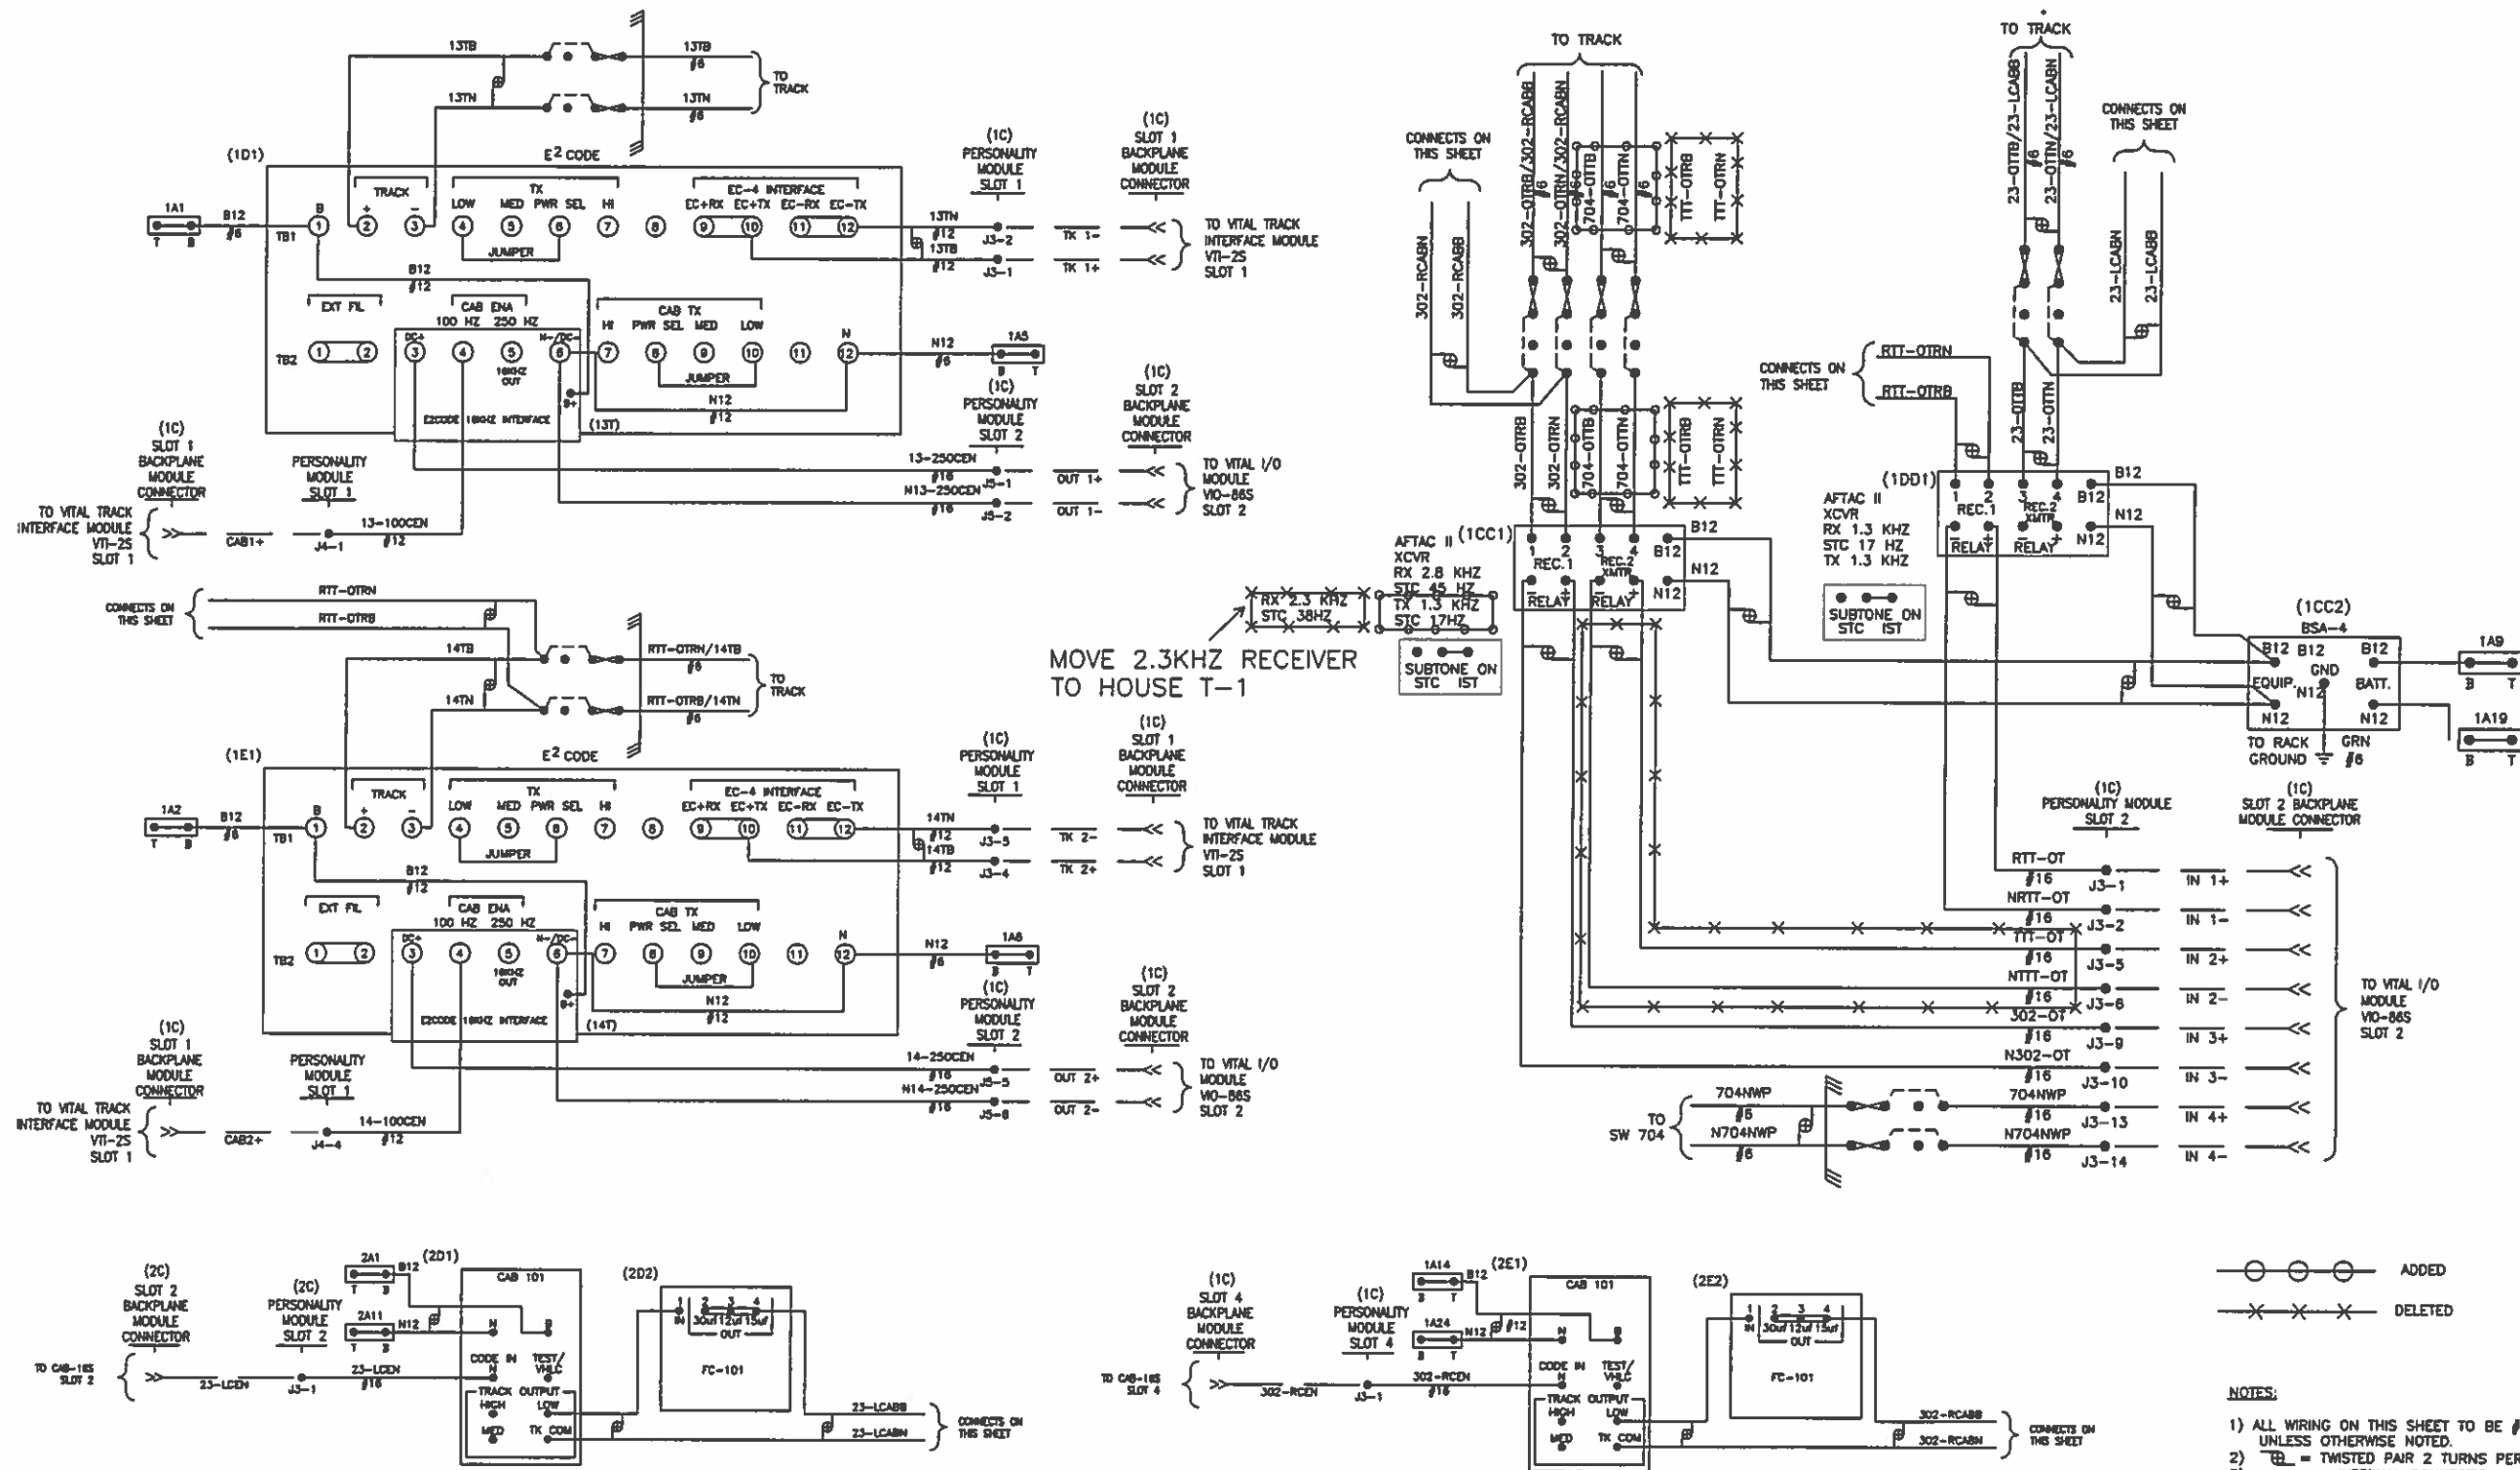



REV	DATE	DESCRIPTION
2	3/17/15	CHANGED AFTAC TO DRIVE 704 XMTR FOR TTT SIGNALING PROJECT
1	11/26/14	AS-IN SERVICE



Designed By:	BDV
Drawn By:	SAT
Checked By:	RWL
Approved By:	AEB

TTCI
 HOUSE 302
 TRACK CIRCUITS

Scale:	NTS
CADD File Name:	302004.DWG
Submitted Date:	04/14/14
Sheet No.	004

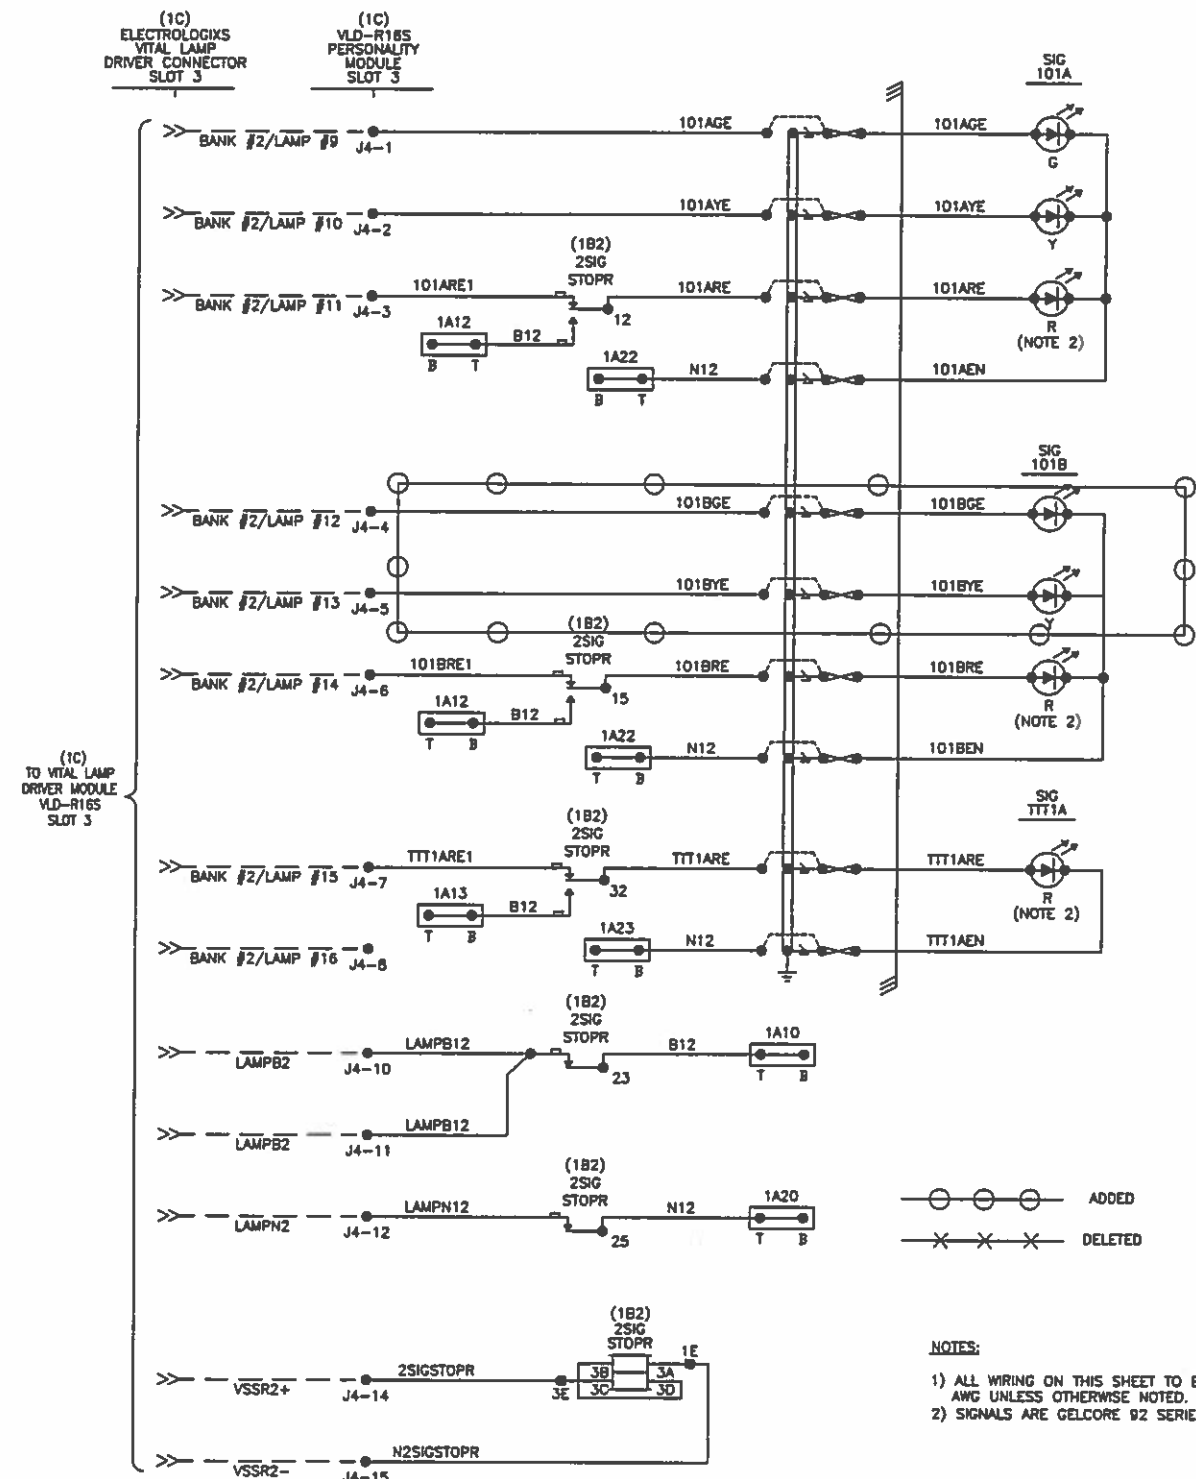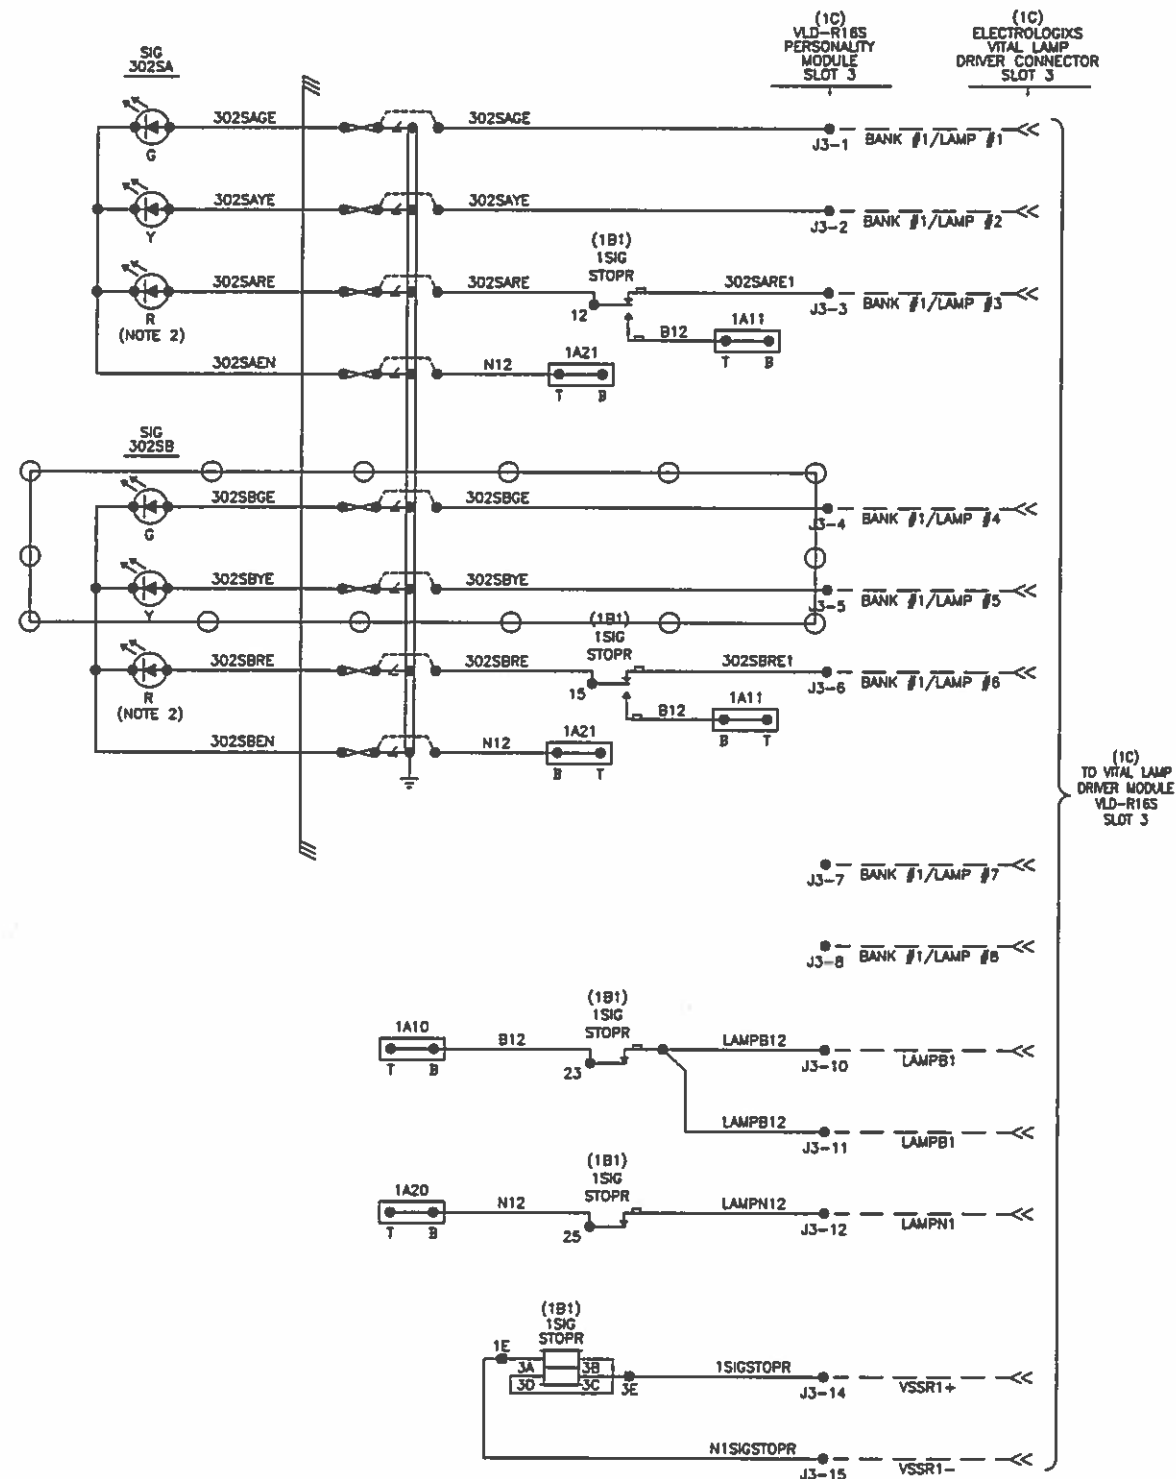

○ ○ ○ ADDED
 × × × DELETED

NOTES:

- 1) ALL WIRING ON THIS SHEET TO BE #12 AWG UNLESS OTHERWISE NOTED.
- 2) SIGNALS ARE GELCORE 92 SERIES

REV	DATE	DESCRIPTION
2	03/17/15	ADDED 101 BGE,BYE & 202 BGE,BYE SIGS FOR TTT SIG. PROJECT.
1	11/26/14	AS-IN SERVICE



Designed By: BDV
 Drawn By: SAT
 Checked By: RWL
 Approved By: AEB

TTCI
 HOUSE 302
 SIGNAL LIGHTING CIRCUITS (RACK 1)

Scale:	NTS
CADD File Name:	302005.DWG
Submitted Date:	04/03/13
Sheet No.	005

(1C)
VH-2S
PERSONALITY
MODULE
(SLOT 1)

TK 1+	13TB	X	1
TK 1-	13TN	X	2
			3
TK 2+	14TB	X	4
TK 2-	14TN	X	5
			6
			7

J3

CAB1+	13-100CEN	X	1
CAB1-			2
			3
CAB2+	14-100CEN	X	4
CAB2-			5
			6
IN 1+			7
IN 1-			8
			9
IN 2+			10
IN 2-			11

J4

(1C)
VH-66S
PERSONALITY
MODULE
(SLOT 2)

IN 1+	RTT-OT	X	1
IN 1-	NRTT-OT	X	2
IN 2+	TTT-OT	X	5
IN 2-	NTTT-OT	X	8
IN 3+	302-OT	X	9
IN 3-	N302-OT	X	10
IN 4+	704NWP	X	13
IN 4-	N704NWP	X	14
IN 5+			17
IN 5-			18

J3

IN 6+			1
IN 6-			2
IN 7+			5
IN 7-			6
IN 8+			9
IN 8-			10
OUT 6+			17
OUT 6-			18

J4

OUT 1+	13-250CEN	X	1
OUT 1-	N13-250CEN	X	2
OUT 2+	14-250CEN	X	5
OUT 2-	N14-250CEN	X	6
OUT 3+			9
OUT 3-			10
OUT 4+			13
OUT 4-			14
OUT 5+			17
OUT 5-			18

J5

(1C)
VLD-R16S
PERSONALITY
MODULE
(SLOT 3)

BANK 1

LAMP1	302SAGE	X	1
LAMP2	302SAYE	X	2
LAMP3	302SARE1	X	3
LAMP4	302SBGE	X	4
LAMP5	302SBYE	X	5
LAMP6	302SBRE1	X	6
LAMP7			7
LAMP8			8
			9
LAMPB1	LAMPB12	X	10
LAMPB1	LAMPB12	X	11
LAMPN1	LAMPN12	X	12
			13
VSSR1+	1SIGSTOPR	X	14
VSSR1-	N1SIGSTOPR	X	15

J3

BANK 2

LAMP9	101AGE	X	1
LAMP10	101AYE	X	2
LAMP11	101ARE1	X	3
LAMP12	101BGE	X	4
LAMP13	101BYE	X	5
LAMP14	101BRE1	X	6
LAMP15	TTT1ARE1	X	7
LAMP16			8
			9
LAMPB2	LAMPB12	X	10
LAMPB2	LAMPB12	X	11
LAMPN2	LAMPN12	X	12
			13
VSSR2+	2SIGSTOPR	X	14
VSSR2-	N2SIGSTOPR	X	15

J4

(1C)
CAB-16S
PERSONALITY
MODULE
(SLOT 4)

CAB1	302-RCEN	X	1
			2
CAB2			3
			4
CAB3			5
			6
CAB4			7
			8
CAB5			9
			10
CAB6			11
			12
CAB7			13
			14
CAB8			15

J3

CAB9			1
			2
CAB10			3
			4
CAB11			5
			6
CAB12			7
			8
CAB13			9
			10
CAB14			11
			12
CAB15			13
			14
CAB16			15

J4

PERSONALITY MODULE
LEGEND

TERMINAL LABEL → XXX XXXX X X → PIN NUMBER

APPLICATION DESCRIPTION WIRE PRESENT

○ ○ ○ ADDED

✕ ✕ ✕ DELETED

2	03/17/15	REMOVED TTT-OT, ADDED SIGS 101BGE, 101BYE, 302BGE, 302BYE
1	11/26/14	AS-IN SERVICE
REV	DATE	DESCRIPTION



Designed By: BDV

Drawn By: SAT

Checked By: RWL

Approved By: AEB

TTCI

HOUSE 302


ELECTROLOGIXS 4-SLOT (RACK 1)
MODULE CONNECTOR USAGE

Scale: NTS

CADD File Name: 302008.DWG

Submitted Date: 04/14/14

Sheet No. 008

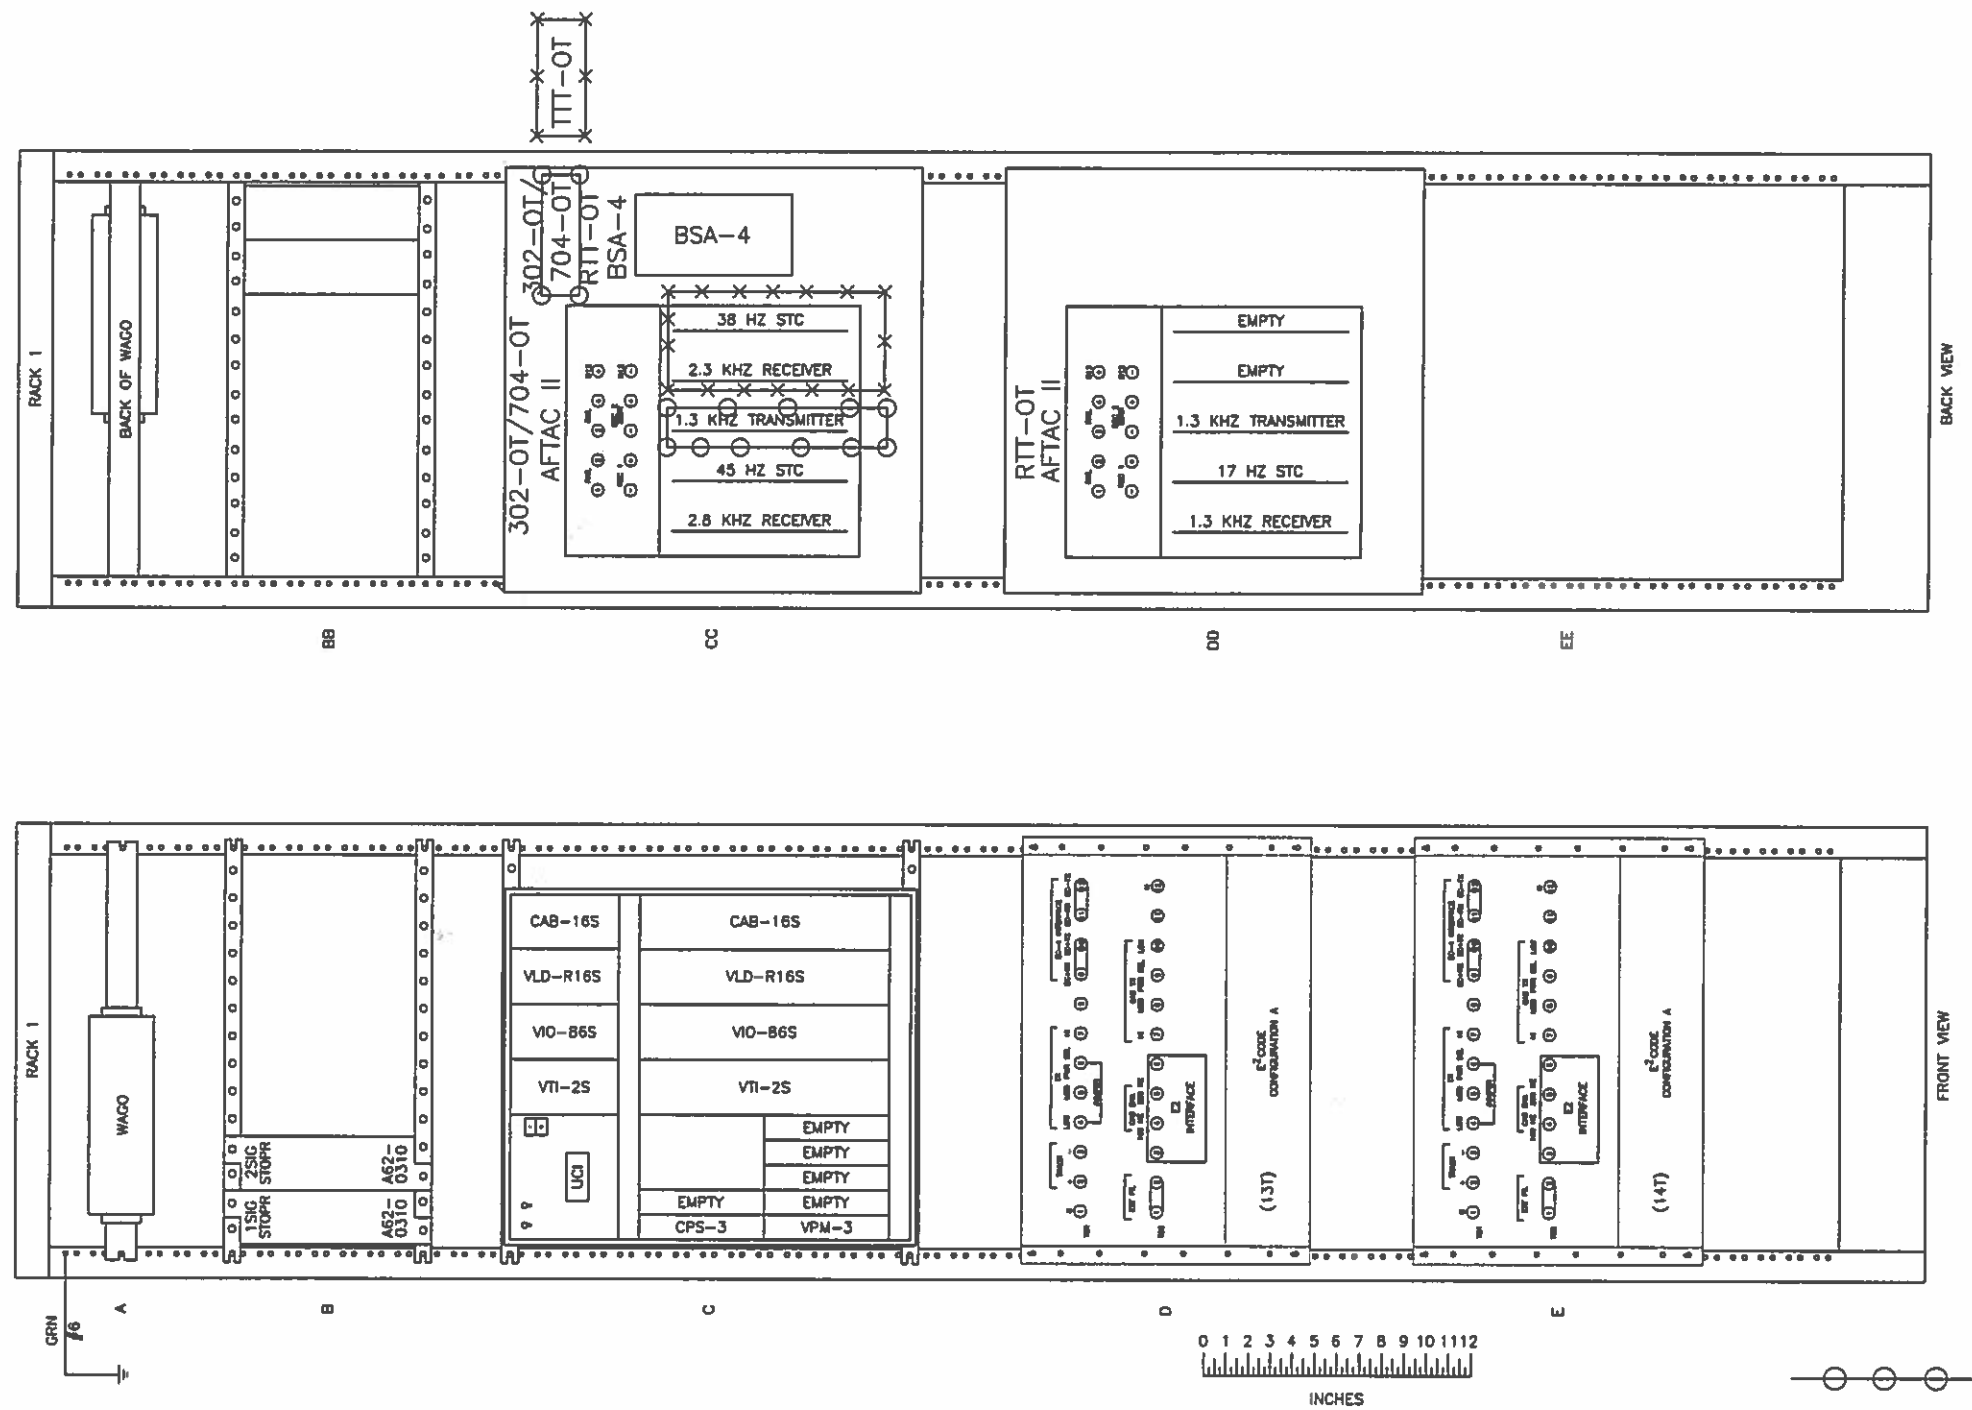



REV	DATE	DESCRIPTION
2	03/17/15	REMOVED AFTACII 2.3KHZ RCVR & 38HZ STC, ADDED 1.3KHZ XMTR
1	11/26/14	AS-IN SERVICE



Designed By:	BDV
Drawn By:	SAT
Checked By:	RWL
Approved By:	AEB

TTCI
HOUSE 302
RACK 1 LAYOUT

Scale:	NTS
CADD File Name:	302011.DWG
Submitted Date:	04/03/13
Sheet No.	011

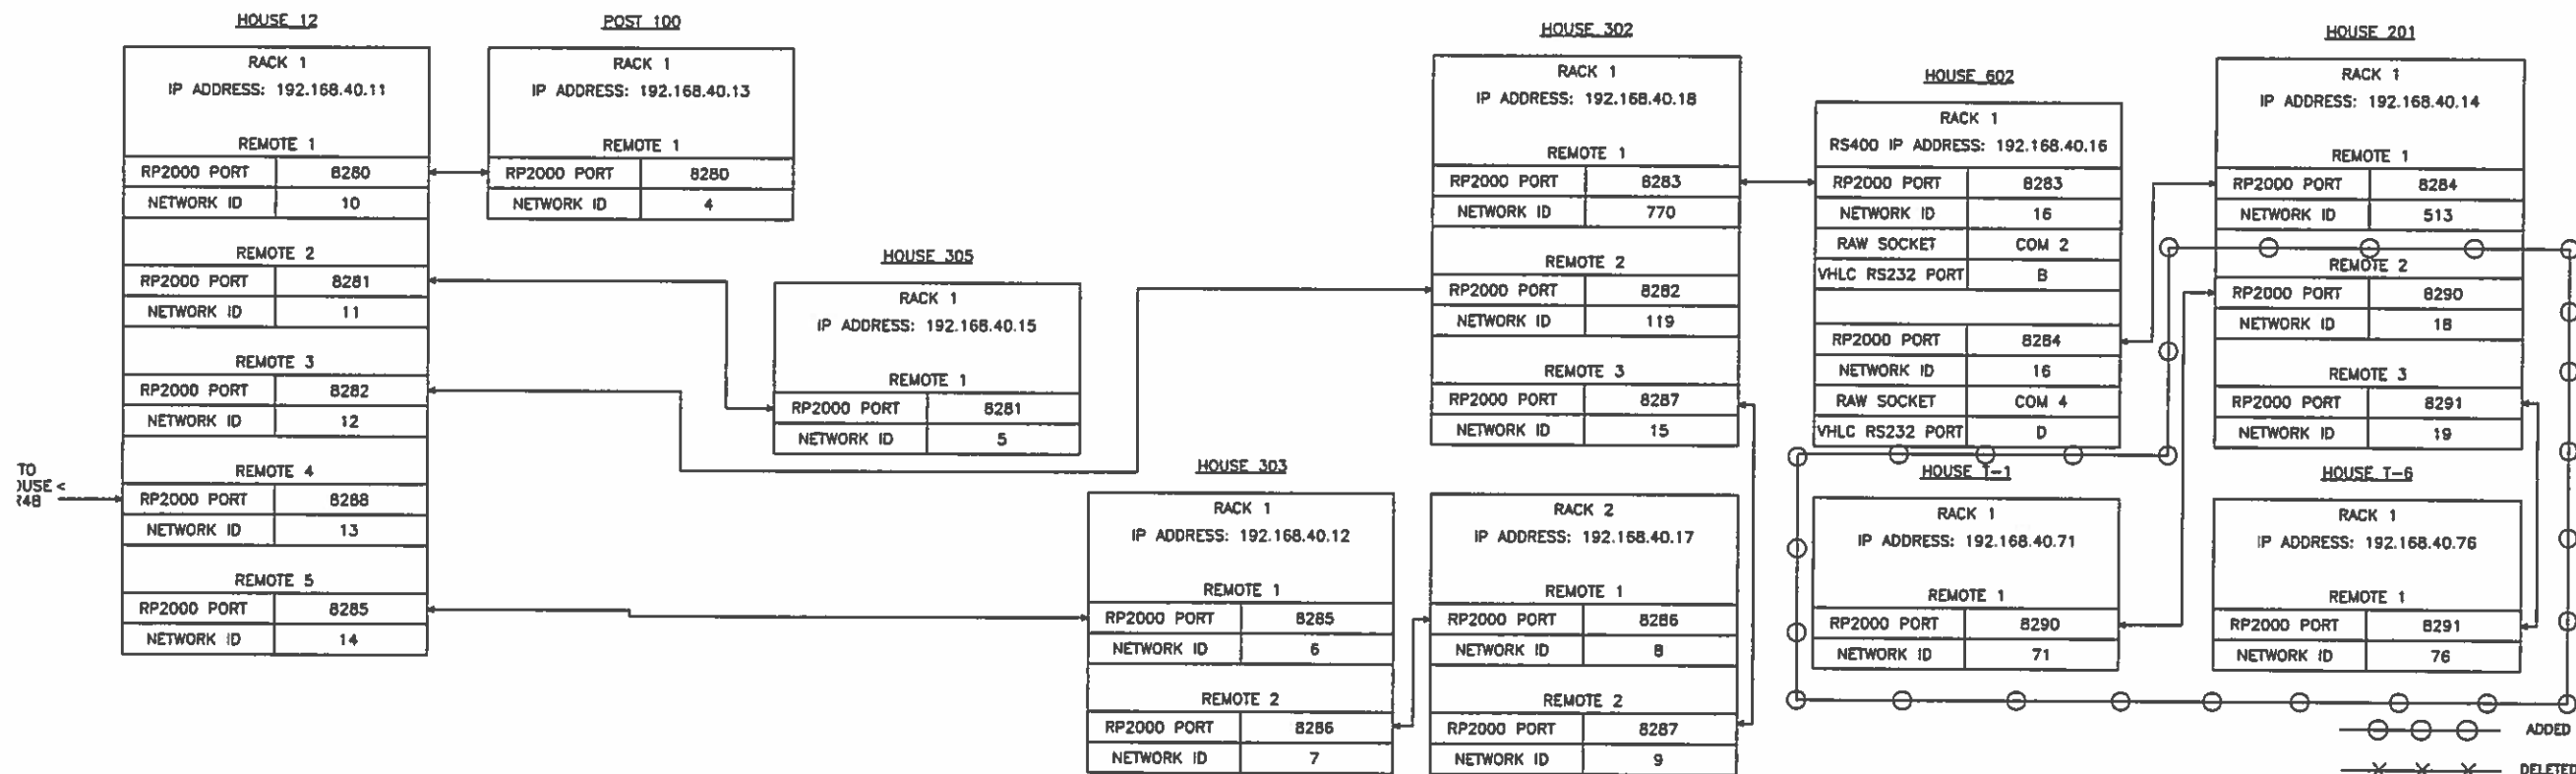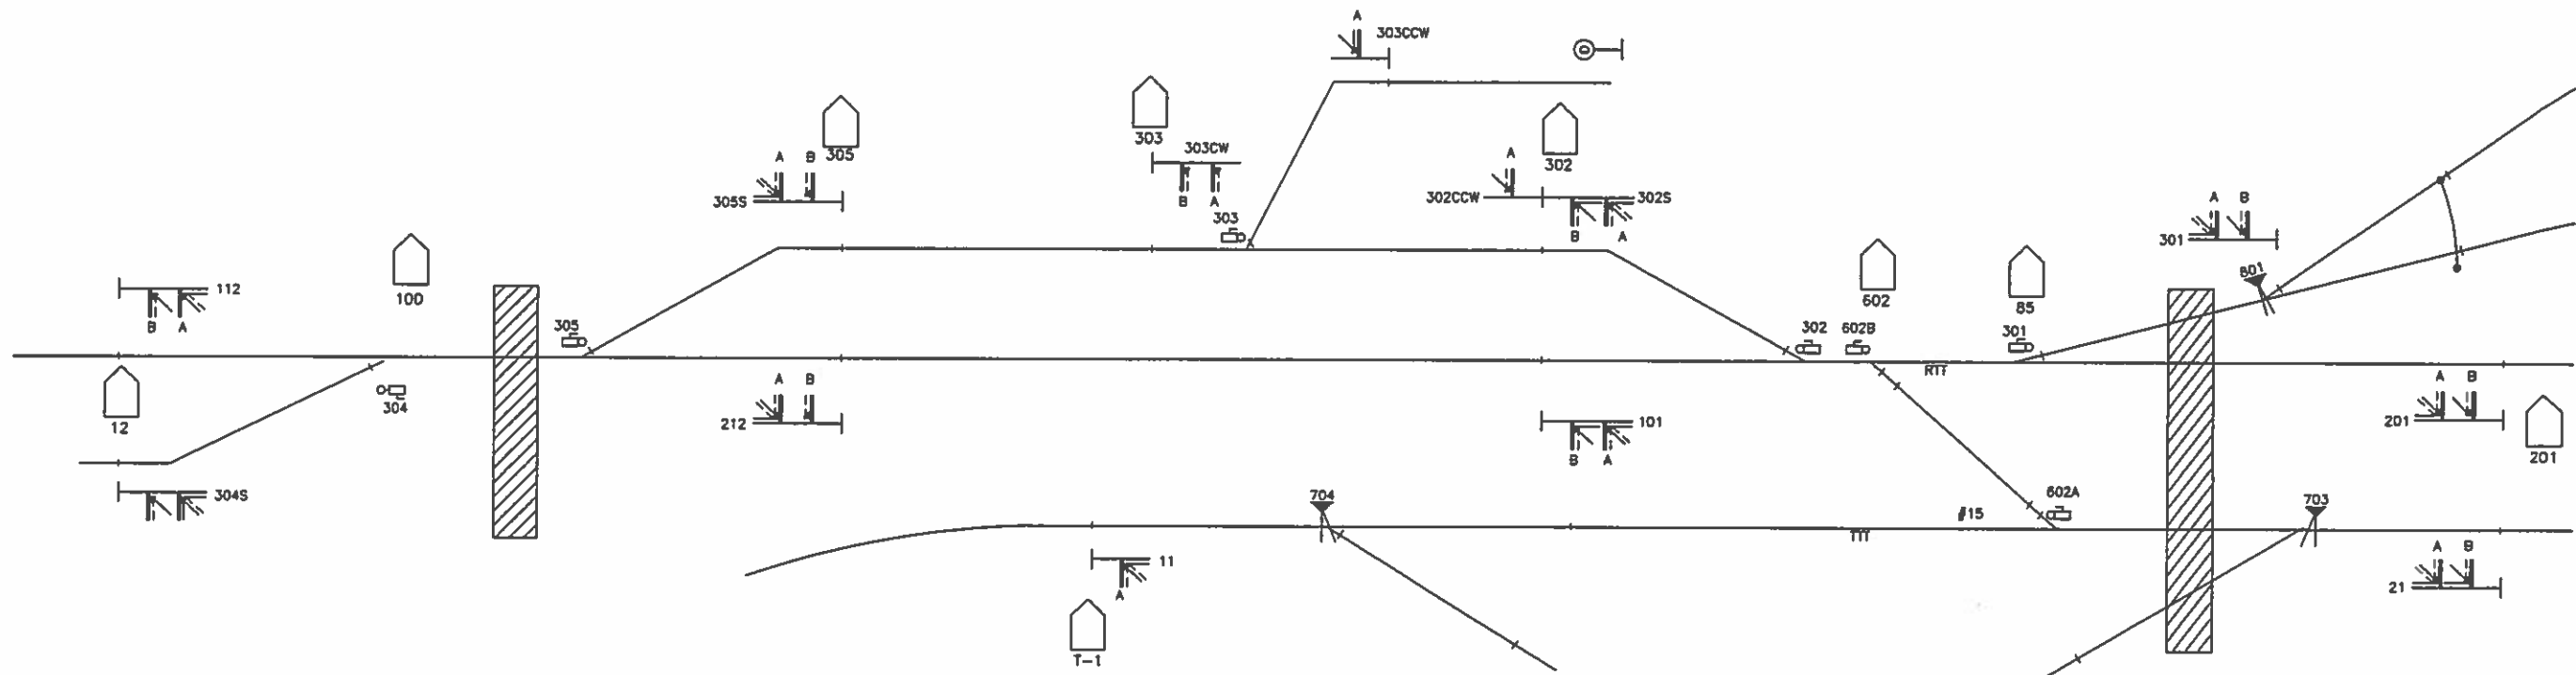

REV	DATE	DESCRIPTION
2	03/17/15	ADDED HOUSES T-1 AND T-6
1	11/26/14	AS-IN SERVICE




Designed By:	BPC
Drawn By:	SAT
Checked By:	BDV
Approved By:	AEB

TTCI
HOUSE 302
VITAL REMOTE NETWORKS


Scale:	NTS
CADD File Name:	302013.DWG
Submitted Date:	06/03/14
Sheet No.	013

HOUSE T-1

						Designed By: BPC	TTCI TTT HOUSE T-1 COVER SHEET	Scale: NTS
						Drawn By: BPC		CAD File Name: T1000.DWG
						Checked By: BDW		Submitted Date: 03/06/15
						Approved By: AEB		
								Sheet No. 000
2	03/30/15	UPDATES AFTER TTCI SITE SURVEY/DESIGN REVIEW						
1	03/06/15	AS DESIGNED						
REV	DATE	DESCRIPTION						

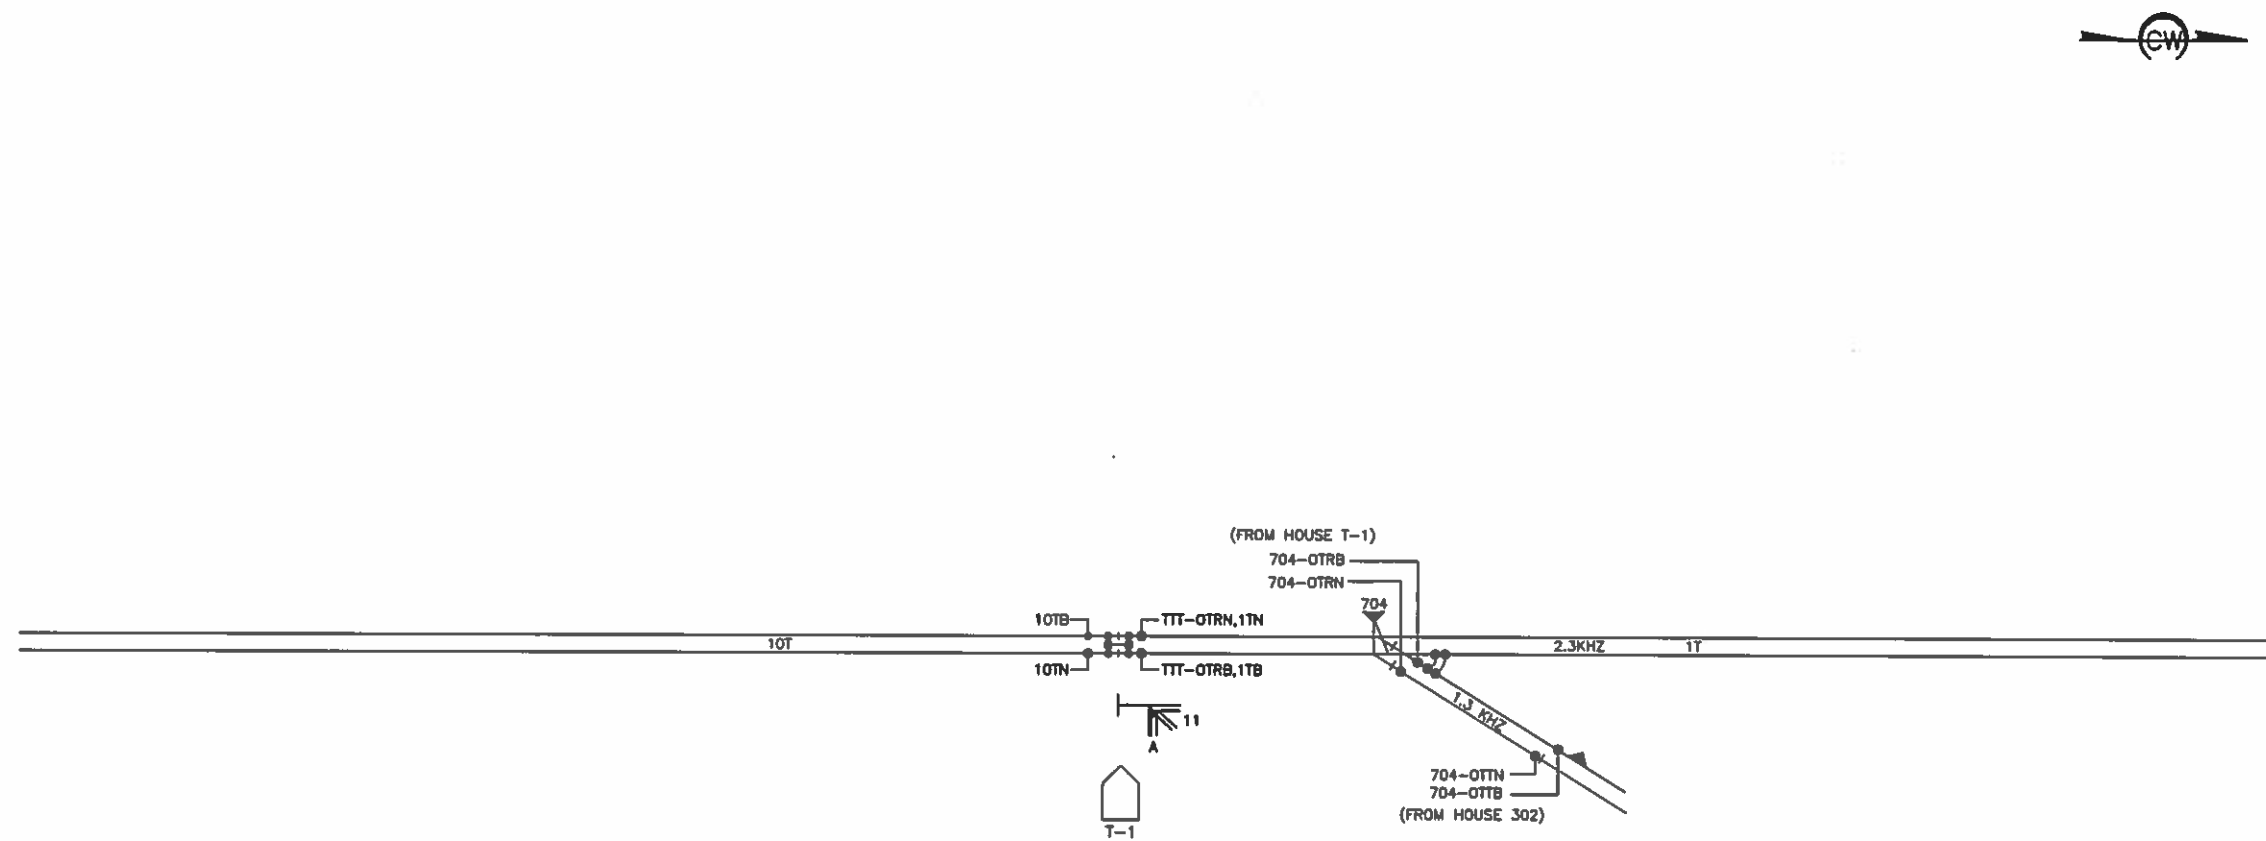


					Designed By:	TTCI TTT HOUSE T-1 TRACK & SIGNAL PLAN		Scale: NTS	
					BPC			CADD File Name: T1002.DWG	
					BPC			Submitted Date: 03/06/15	
					BDW				
					AEB			Sheet No. 002	
2	03/30/15	ADDED JUMPERS TO TRACK CIRCUIT 704							
1	03/06/15	AS DESIGNED							
REV	DATE	DESCRIPTION							

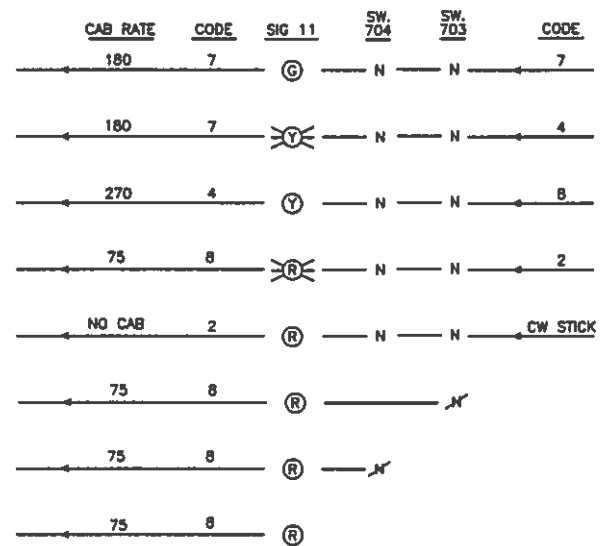

LAMP OUT DOWNGRADES FOR SIG 11				
CODE IN	LAMP OUT	ASPECT	CODE OUT	CAB RATE
7	G	FY	7	180
4.8	Y	FR	8	75
*NO CODE	R	D	8	75
ALL CODES	ALL	D	8	75

TTT CAB RATE TABLE		
NAME	DESIGNATOR	RATE
CLEAR	C	180
CAB SPEED	CS	270
APPROACH LIMITED	AL?	120
APPROACH	A	75
RESTRICTING	R	NO CAB

Designed By:	BPC	TTCI TTT HOUSE T-1 CODE & ASPECT CHART	Scale:	NTS
Drawn By:	BPC		CADD File Name:	T1003.DWG
Checked By:	BDW		Submitted Date:	03/06/15
Approved By:	AEB			
				Sheet No. 003

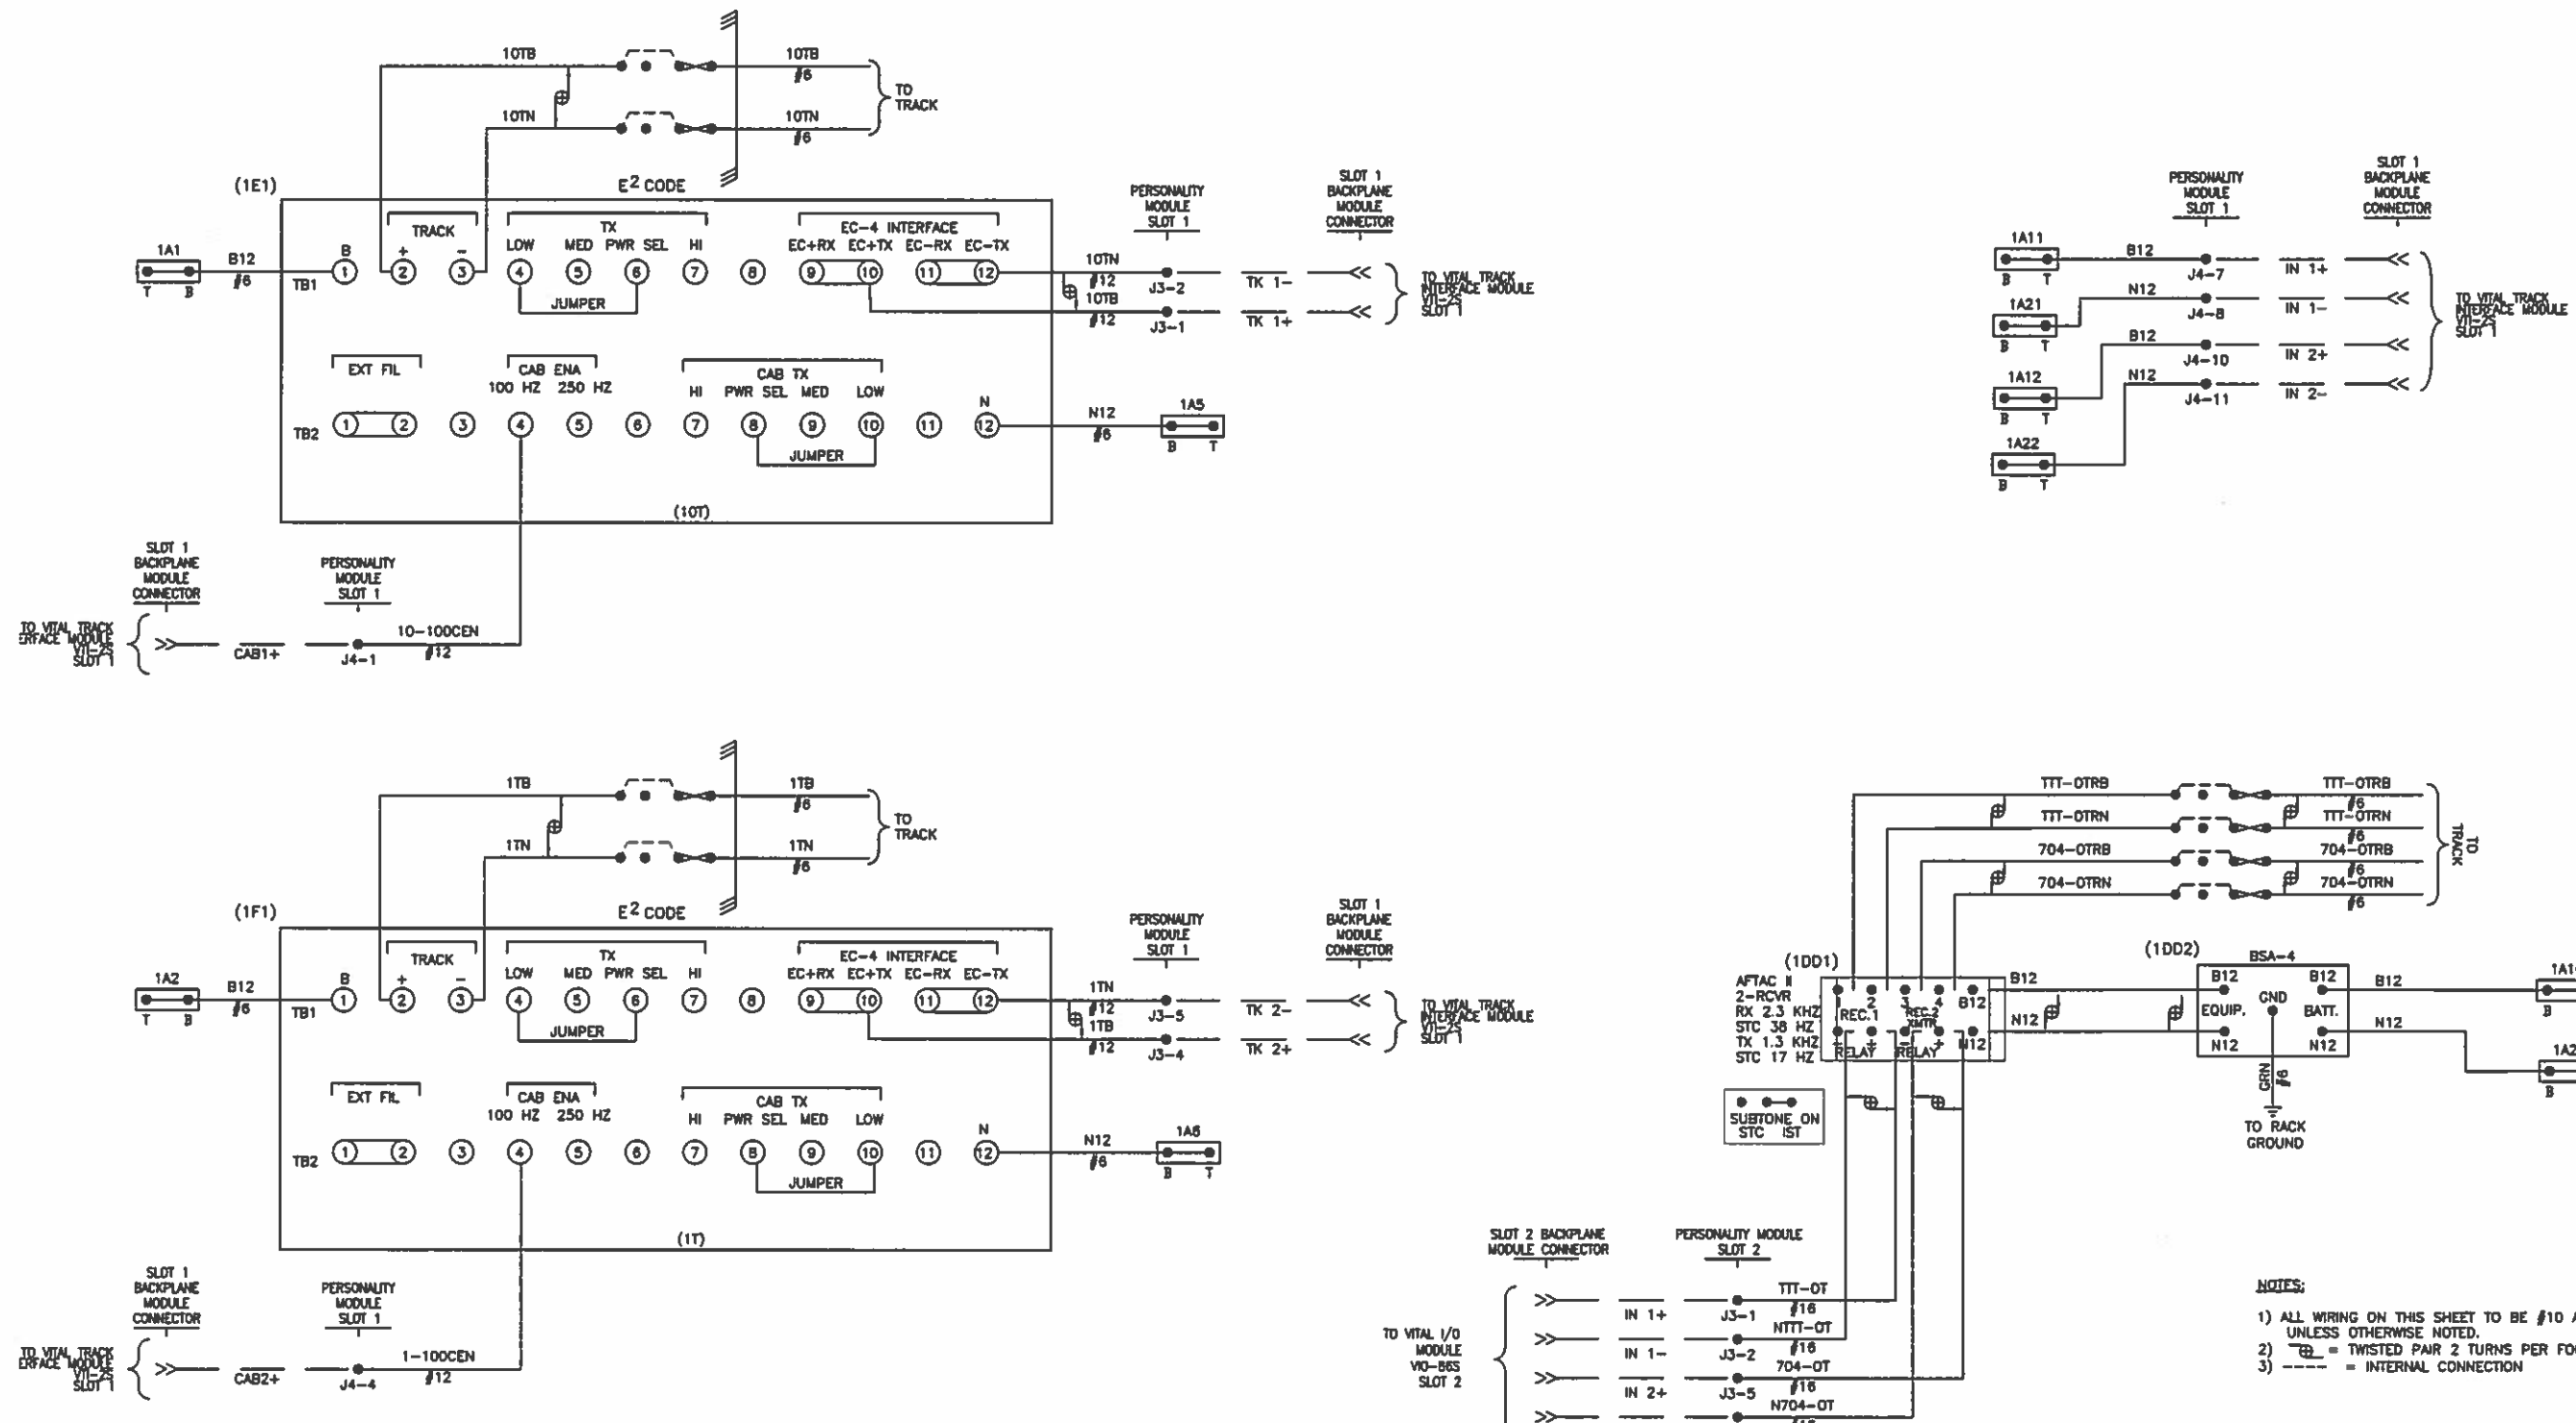


REV	DATE	DESCRIPTION
1	03/06/15	AS DESIGNED



Designed By:	BPC
Drawn By:	BPC
Checked By:	BDW
Approved By:	AEB

TTCI
TTT HOUSE T-1
TRACK CIRCUITS

Scale:	NTS
CADD File Name:	T1004.DWG
Submitted Date:	03/06/15
Sheet No.	004

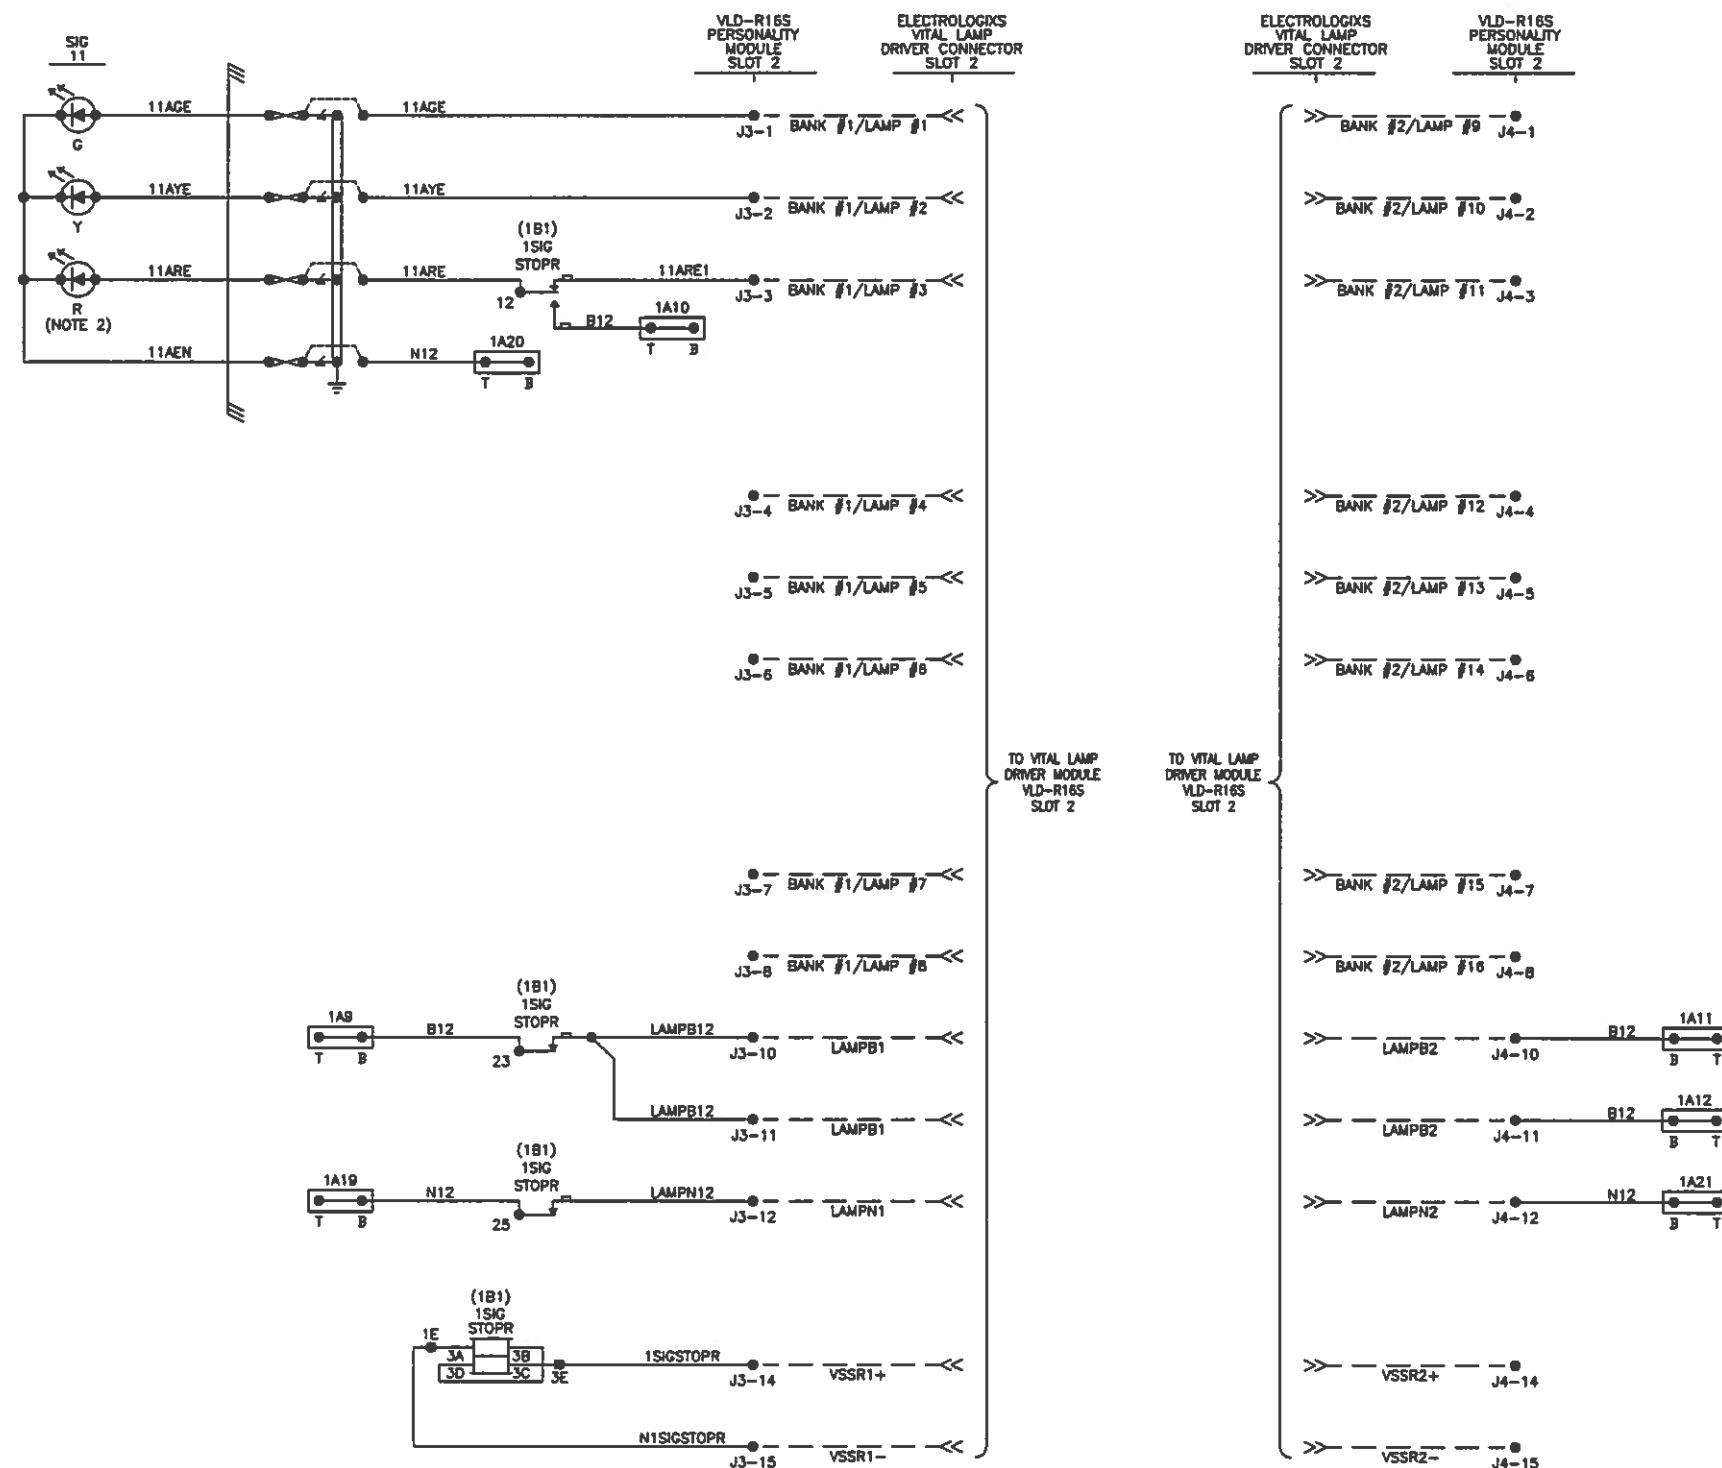

NOTES:

- 1) ALL WIRING ON THIS SHEET TO BE #12 AWG UNLESS OTHERWISE NOTED.
- 2) SIGNALS ARE GELCORE 98 SERIES


Designed By:
BPC
Drawn By:
BPC
Checked By:
BDW
Approved By:
AEB

TTCI
TTT HOUSE T-1
SIGNAL LIGHTING CIRCUITS

Scale: NTS
CADD File Name: T1005.DWG
Submitted Date: 03/06/15
Sheet No. 005



GETS
Global Signaling

REV	DATE	DESCRIPTION
1	03/06/15	AS DESIGNED

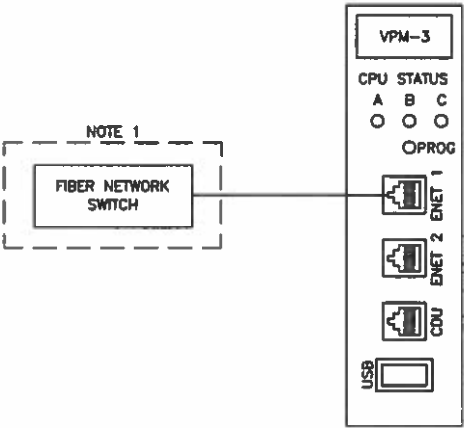

NOTES:
1) FIELD SUPPLIED

					Designed By:	BPC	TTCI	Scale:	NTS
					Drawn By:	BPC		CADD File Name:	T1006.DWG
					Checked By:	BDW	TTT HOUSE T-1	Submitted Date:	03/06/15
					Approved By:	AEB	COMMUNICATIONS		Sheet No.
1	03/06/15	AS DESIGNED							006
REV	DATE	DESCRIPTION							

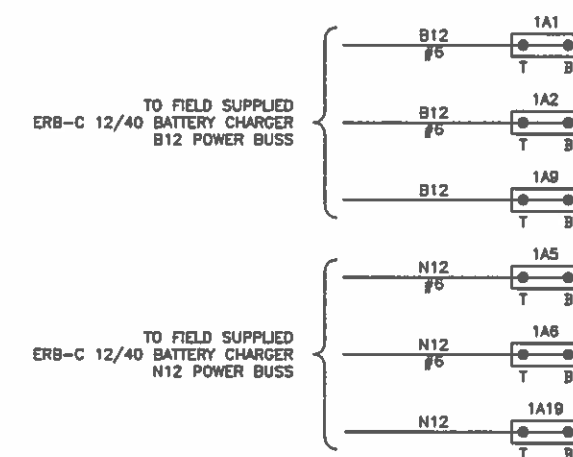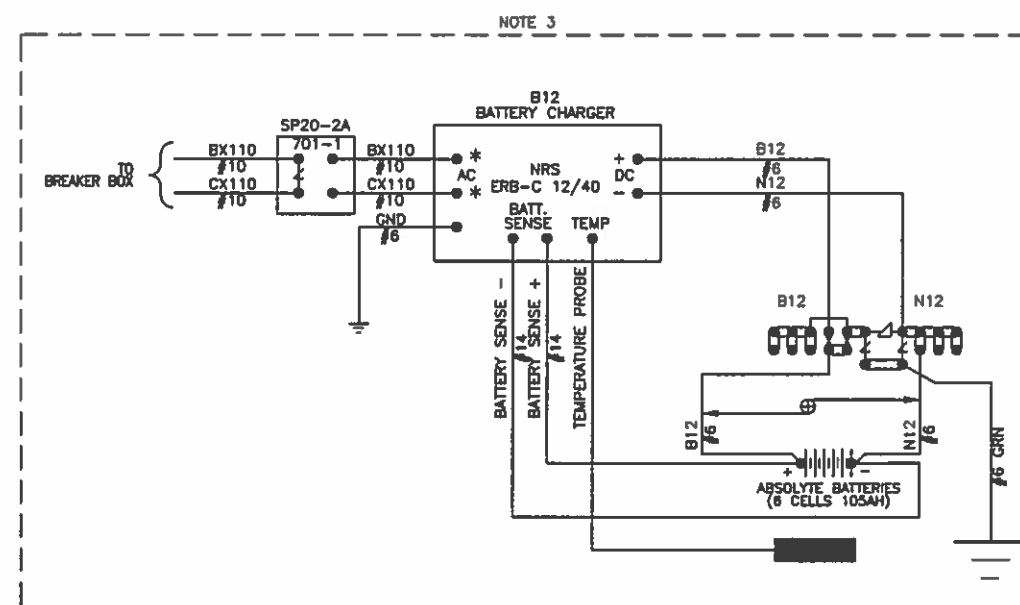

NOTES:

- 1) ALL SIGNAL WIRING ON THIS SHEET TO BE #10 AWG UNLESS OTHERWISE NOTED.
- 2) TP = TWISTED PAIR 2 TURNS PER FOOT.
- 3) FIELD SUPPLIED

				Designed By:	BPC	TTCI TIT HOUSE T-1 POWER DISTRIBUTION CIRCUITS	Scale:	NTS
				Drawn By:	BPC		CADD File Name:	T1007.DWG
				Checked By:	BDW		Submitted Date:	03/06/15
				Approved By:	AEB			
1	03/06/15	AS DESIGNED						
REV	DATE	DESCRIPTION						Sheet No.

V7I-2S PERSONALITY MODULE (SLOT 1)			
TK 1+	10TB	X	1
TK 1-	10TN	X	2
			3
TK 2+	1TB	X	4
TK 2-	1TN	X	5
			6
			7

J3

CAB1+	10-100CEN	X	1
CAB1-			2
			3
CAB2+	1-100CEN	X	4
CAB2-			5
			6
IN 1+	B12	X	7
IN 1-	N12	X	8
			9
IN 2+	B12	X	10
IN 2-	N12	X	11


J4

VLD-R16S PERSONALITY MODULE (SLOT 2)			
BANK 1			
LAMP1	11AGE	X	1
LAMP2	11AYE	X	2
LAMP3	11ARE1	X	3
LAMP4			4
LAMP5			5
LAMP6			6
LAMP7			7
LAMP8			8
			9
LAMPB1	LAMPB12	X	10
LAMPB1	LAMPB12	X	11
LAMPN1	LAMPN12	X	12
			13
VSSR1+	1SIGSTOPR	X	14
VSSR1-	N1SIGSTOPR	X	15

J3





BANK 2			
LAMP9			1
LAMP10			2
LAMP11			3
LAMP12			4
LAMP13			5
LAMP14			6
LAMP15			7
LAMP16			8
			9
LAMPB2	B12	X	10
LAMPB2	B12	X	11
LAMPN2	N12	X	12
			13
VSSR2+			14
VSSR2-			15

J4

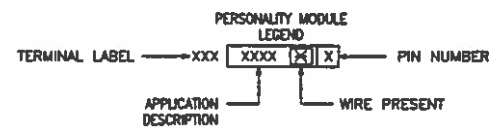


					Designed By: BPC	TTCI TTT HOUSE T-1 ELECTROLOGIXS 4-SLOT MODULE CONNECTOR USAGE	Scale: NTS
					Drawn By: BPC		CADD File Name: T1008.DWG
					Checked By: BDW		Submitted Date: 03/06/15
					Approved By: AEB		
							Sheet No. 008
1	03/06/15	AS DESIGNED					
REV	DATE	DESCRIPTION					



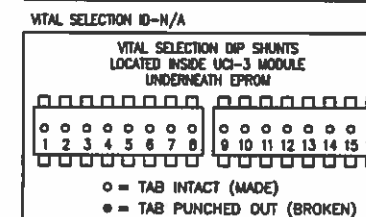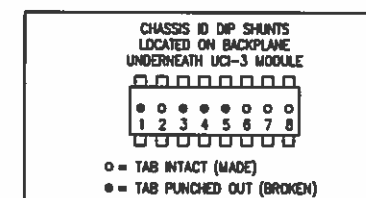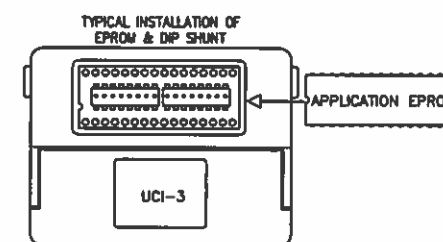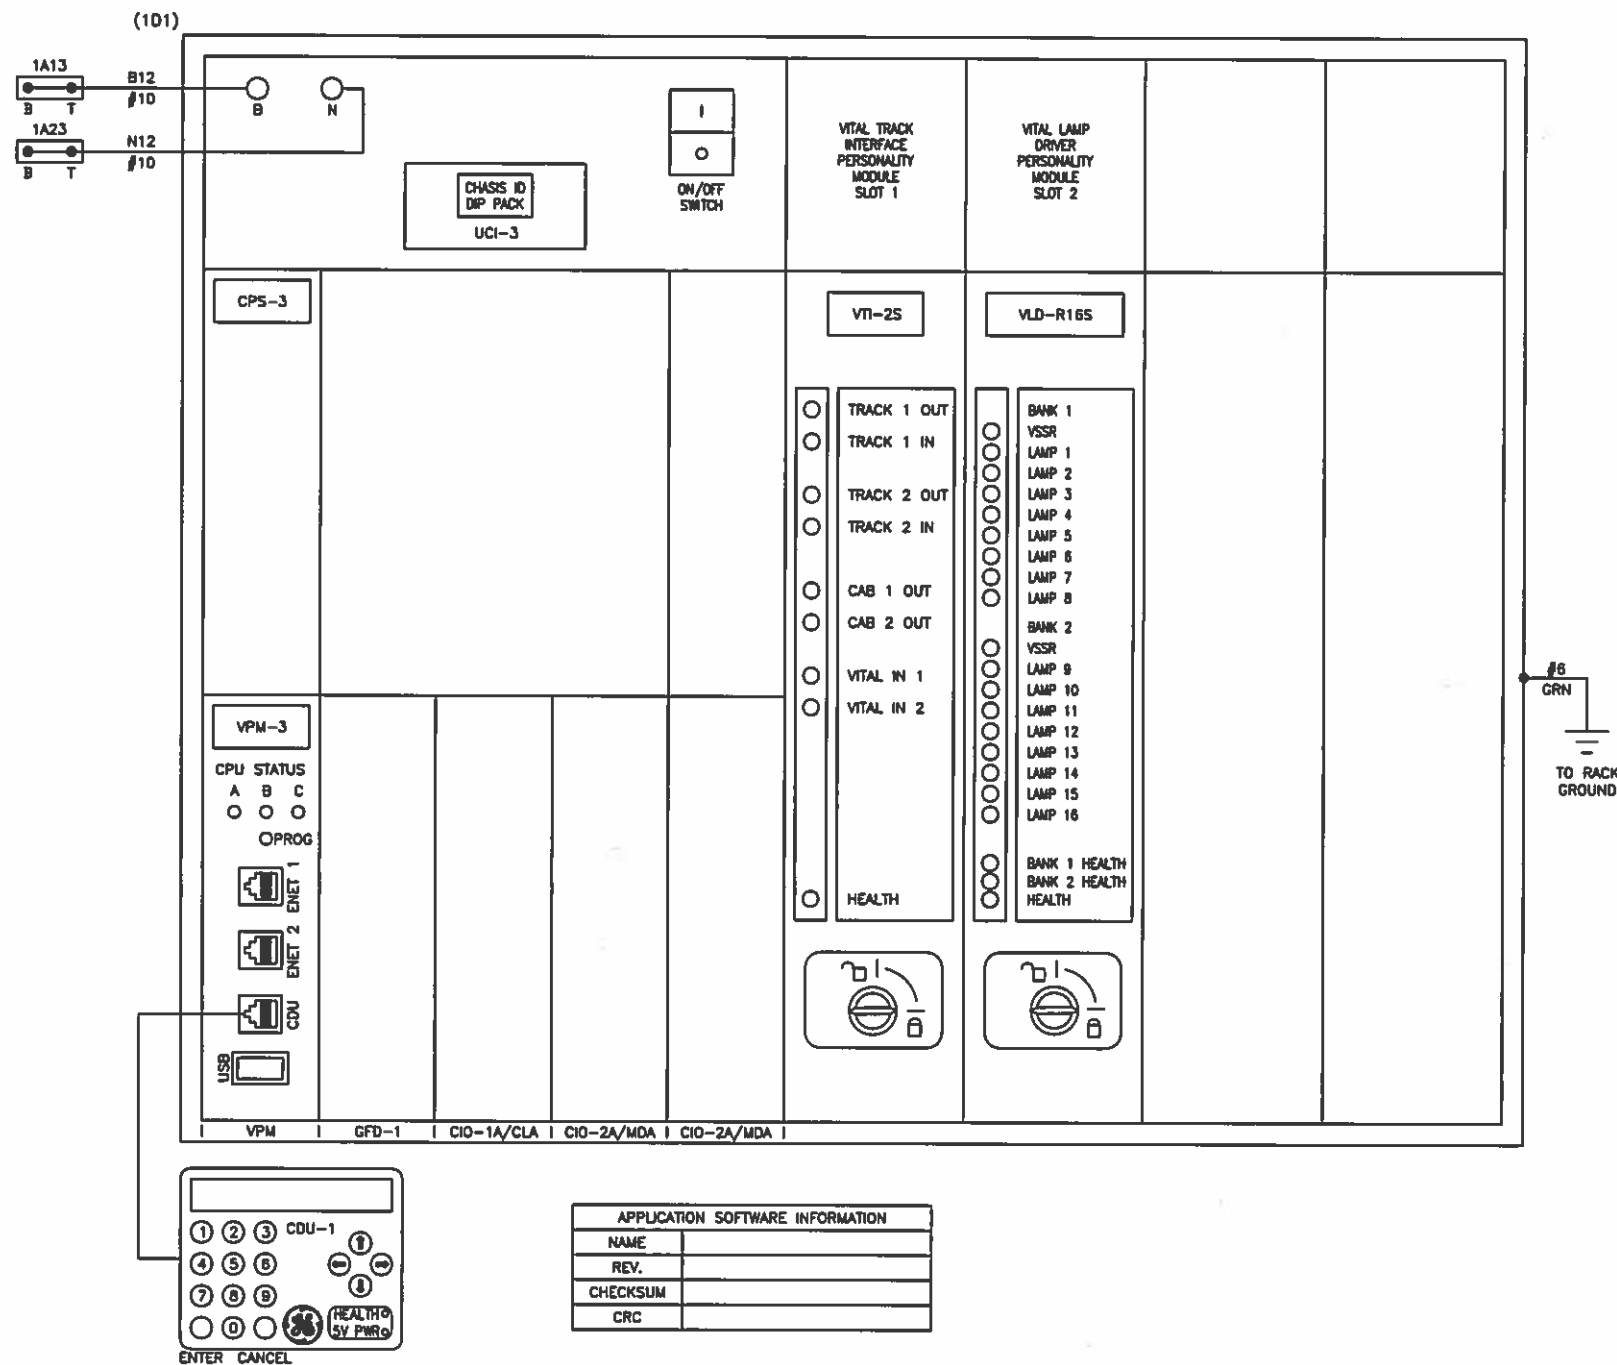

NOTES:

- CDU-1 = CONTROL DISPLAY UNIT
- CPS-3 = CENTRAL POWER SUPPLY
- VPM-3 = VITAL PERIPHERAL MASTER MODULE
- UCI-3 = CHASSIS INFORMATION MODULE
- VTI-25 = VITAL TRACK INTERFACE
- VLD-R16S = VITAL LAMP DRIVER MODULE
- VO-86S = VITAL INPUTS/OUTPUTS
- CIO-CLA = COMMUNICATION INPUT/OUTPUT CURRENT LOOP ADAPTER

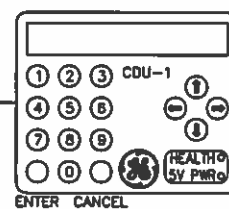

APPLICATION SOFTWARE INFORMATION	
NAME	
REV.	
CHECKSUM	
CRC	

REV	DATE	DESCRIPTION
2	03/30/15	CORRECTED TYPO. VLD-R16S IS IN SLOT 2.
1	03/06/15	AS DESIGNED



Designed By:	BPC
Drawn By:	BPC
Checked By:	BDW
Approved By:	AEB

TTCI

TIT HOUSE T-1


ELECTROLOGIXS 4-SLOT
HARDWARE CONFIGURATION

Scale:	NTS
CADD File Name:	T1009.DWG
Submitted Date:	03/06/15
Sheet No.	009


SYSTEM CONFIGURATION					
DATE/TIME	SETTING MADE WHEN USING PTC CONFIGURATION				
DIAGNOSTIC PORT					
ETHERNET CONFIG.					
OFFICE CONFIG	NA				
LCP CONFIG	ENABLED		TRUE		
VITAL REMOTE CONFIG	LOCAL PORT		REMOTE PORT	REMOTE PORT CONFIG	
	ETHERNET PORT 1 192.168.40.71		1	IP	192.168.40.14
				PORT	8290
				LOCAL NETWORK ID	71
				REMOTE NETWORK ID	18
				PROTOCOL	RP2000
				DATE/TIME UPDATE	ENABLED
				MAC	DISABLED
	ETHERNET PORT 2 192.168.1.12		NA	NA	NA
	SERIAL PORT 2		NA		
SERIAL PORT 3		NA			
TRACK CONFIG	SLOT		TRACK	CONFIGURATION	
	SLOT 1: 10T_T11		1	TRANSMITTER	4V
				RECEIVER	0.5A
				CODE 5 TYPE	ALT 5
	SLOT 1: 1T_T11		2	TRANSMITTER	4V
				RECEIVER	0.5A
CODE 5 TYPE				ALT 5	

NOTES:
1. FINAL VITAL CONFIGURATION SETTINGS ARE SUBJECT TO CHANGE IN ACCORDANCE WITH SOFTWARE UPGRADES. FINAL VITAL CONFIGURATION SETTINGS TO BE UPDATED ON AS-IN-SERVICE.



					Designed By: BPC	TTCI TTT HOUSE T-1 ELECTROLOGIXS 4-SLOT CONFIGURATION SETTINGS	Scale: NTS
					Drawn By: BPC		CADD File Name: T1010.DWG
					Checked By: BDW		Submitted Date: 03/06/15
					Approved By: AEB		
							Sheet No. 010
1	03/06/15	AS DESIGNED					
REV	DATE	DESCRIPTION					

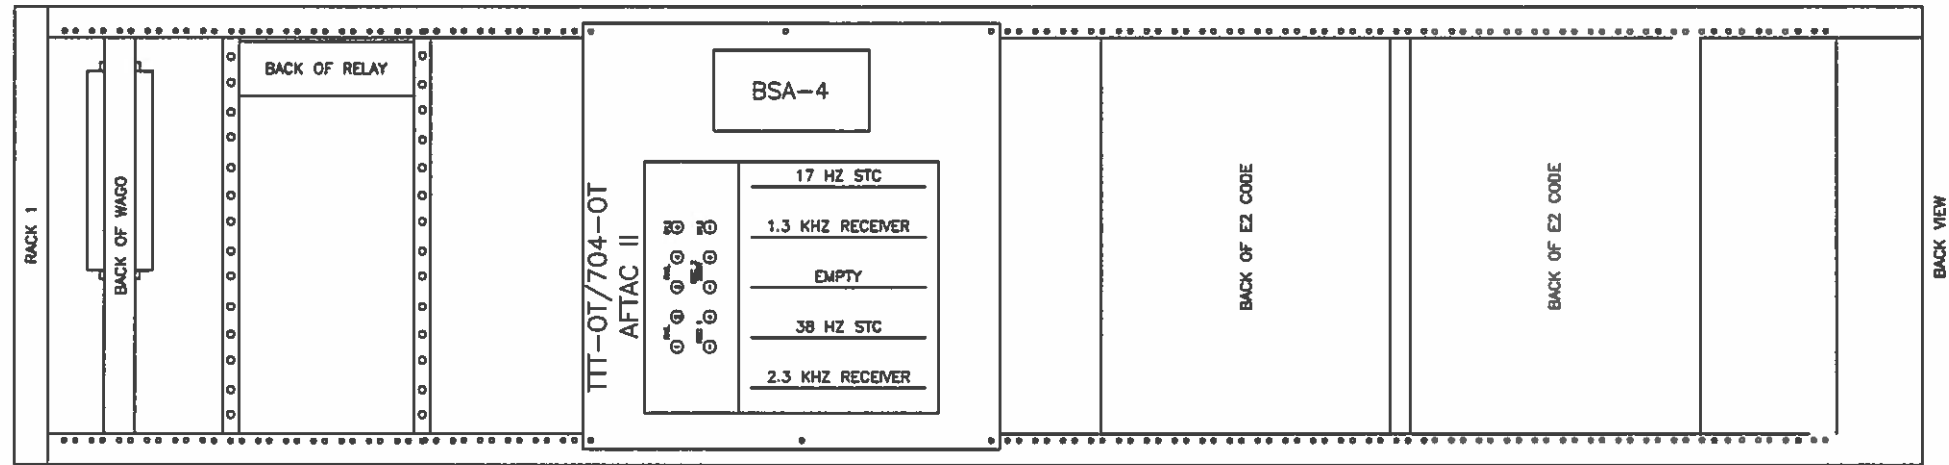



00

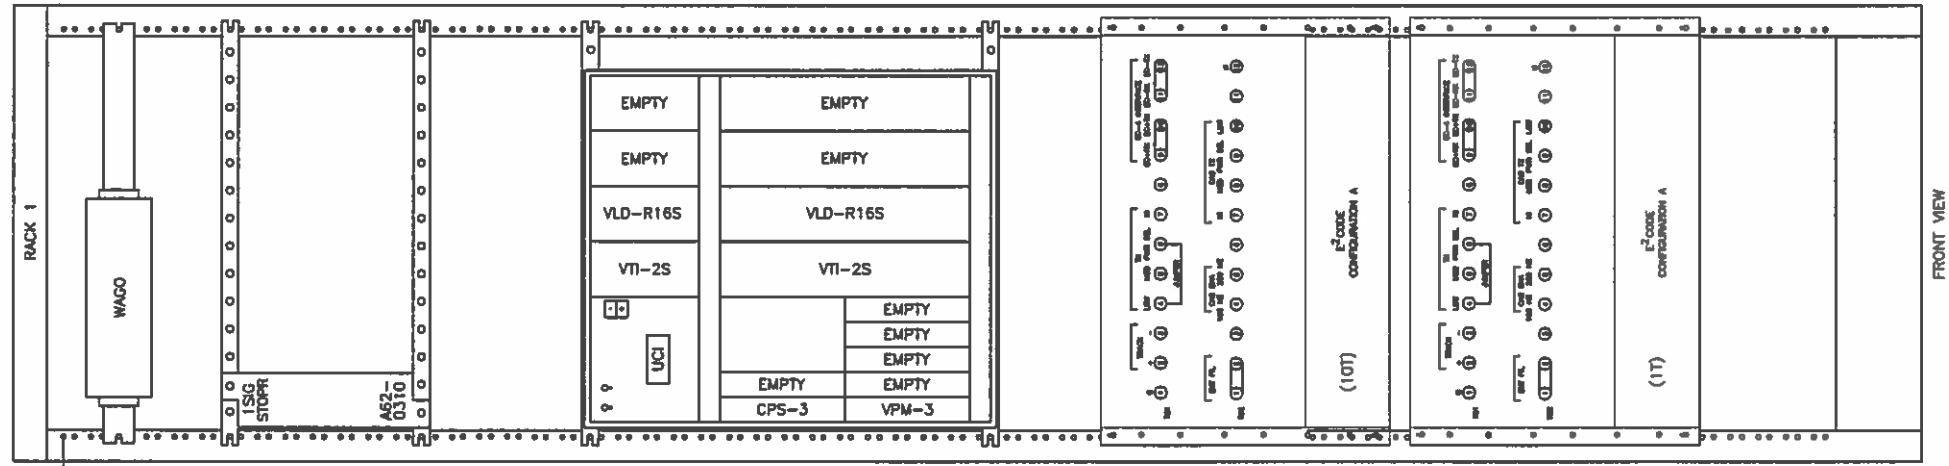

				Designed By: BPC	TTCI TTT HOUSE T-1 RACK 1 LAYOUT	Scale: NTS
				Drawn By: BPC		CADD File Name: T1011.DWG
				Checked By: BDW		Submitted Date: 03/06/15
				Approved By: AEB		
1	03/06/15	AS DESIGNED				
REV	DATE	DESCRIPTION				Sheet No. 011

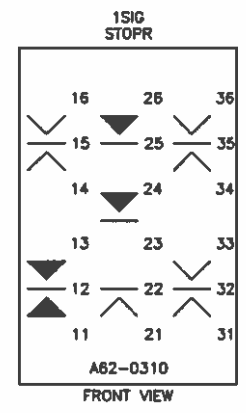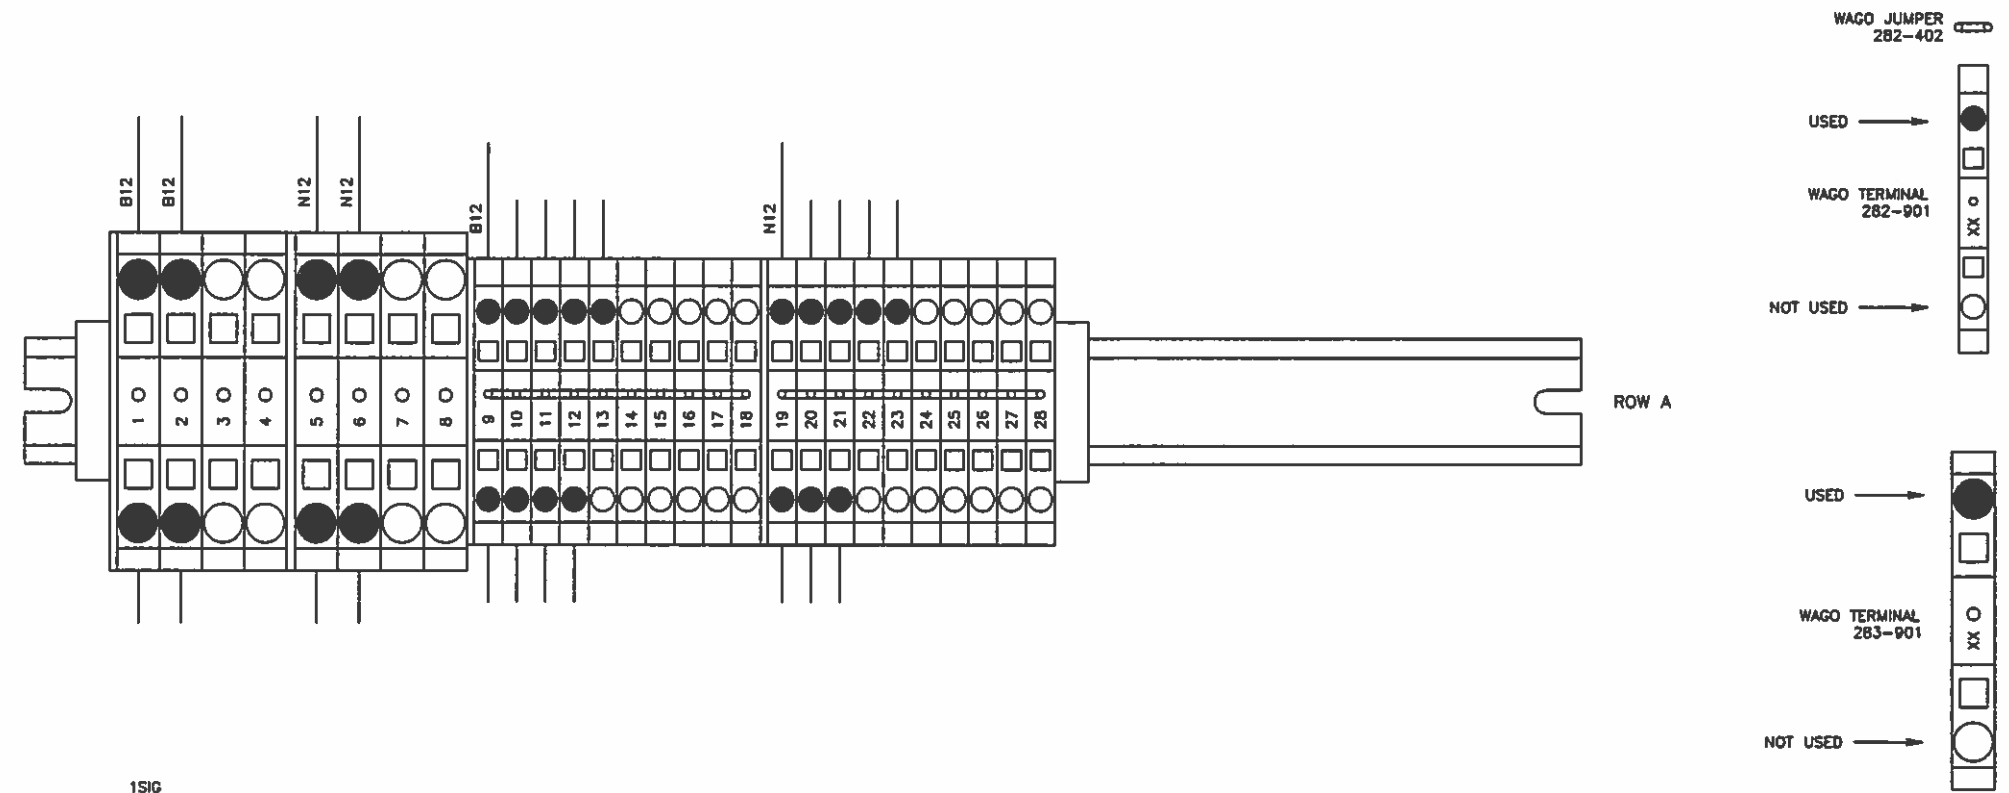

				Designed By:	BPC	TTCI TTT HOUSE T-1 WAGO & RELAY LAYOUT RACK 1, ROW A & B	Scale: NTS	
				Drawn By:	BPC		CADD File Name: T1012.DWG	
				Checked By:	BDW		Submitted Date: 03/06/15	
				Approved By:	AEB			
1	03/06/15	AS DESIGNED						
REV	DATE	DESCRIPTION						Sheet No. 012

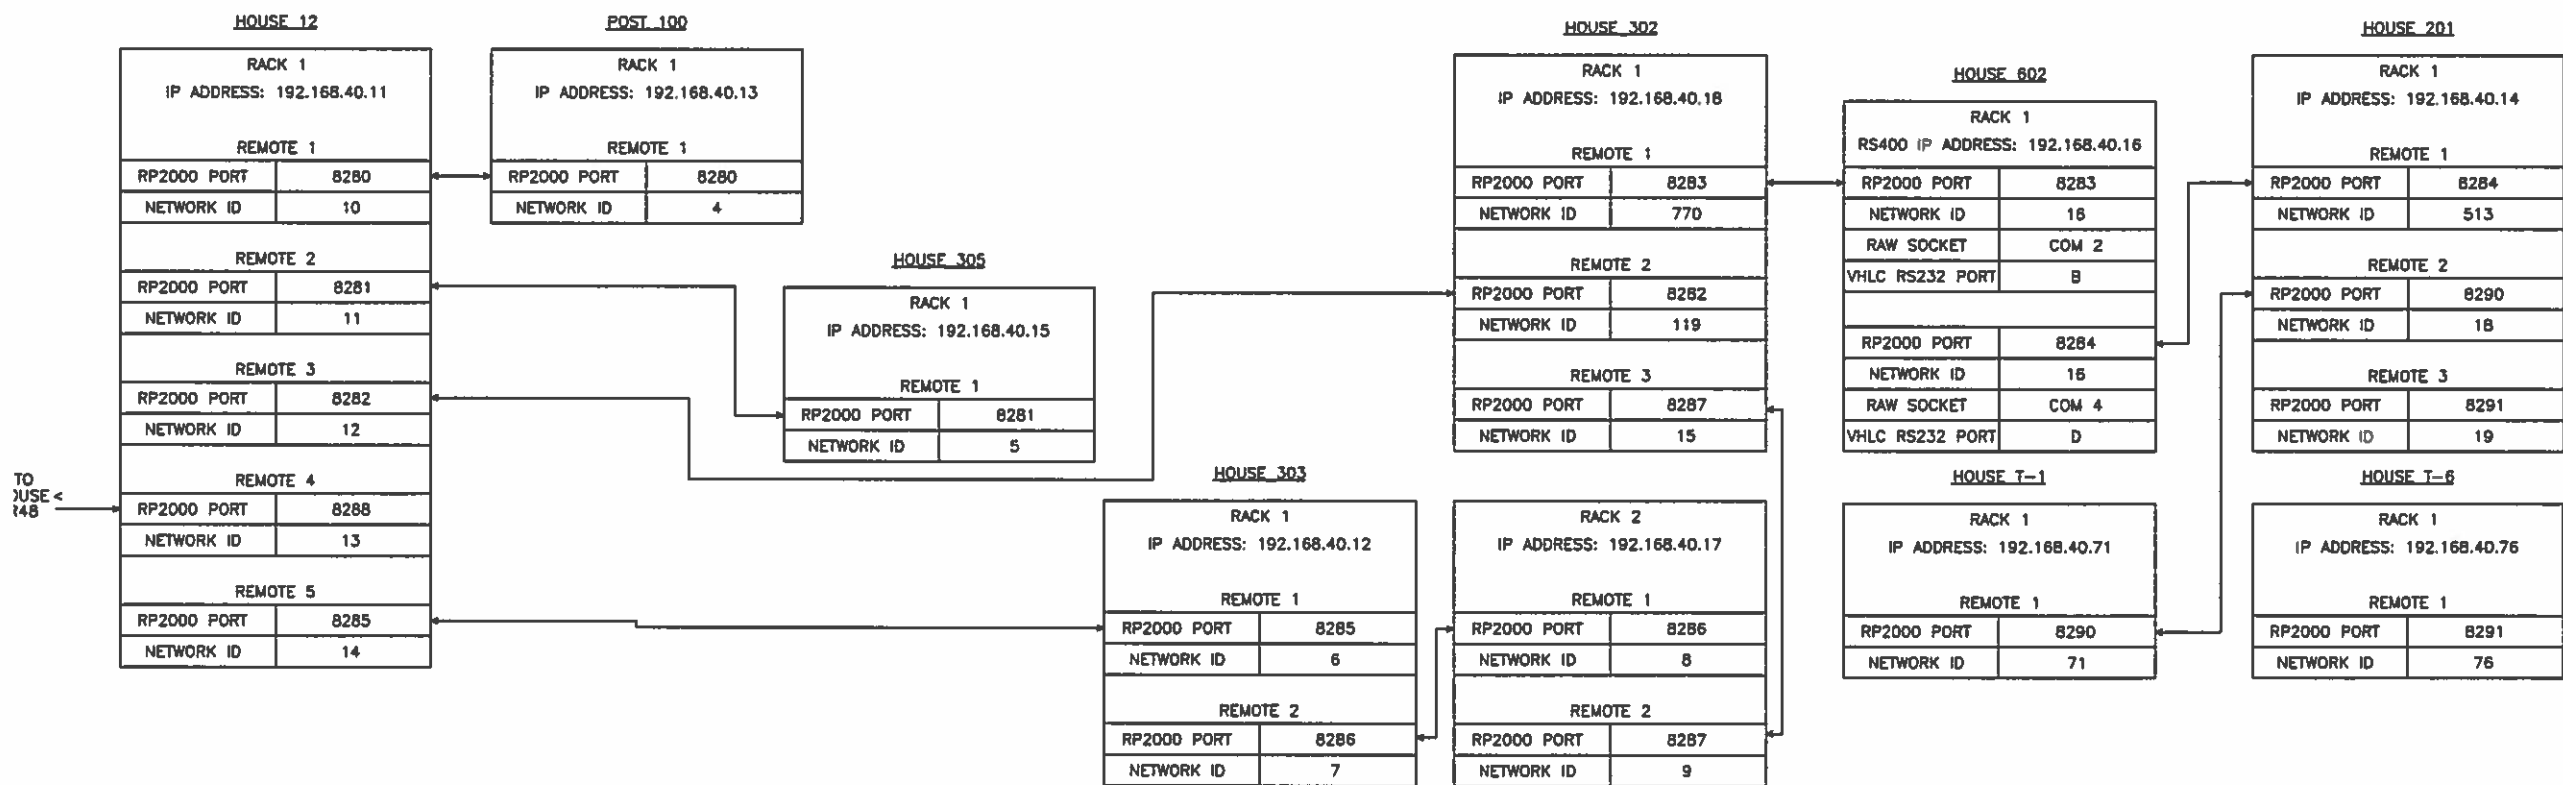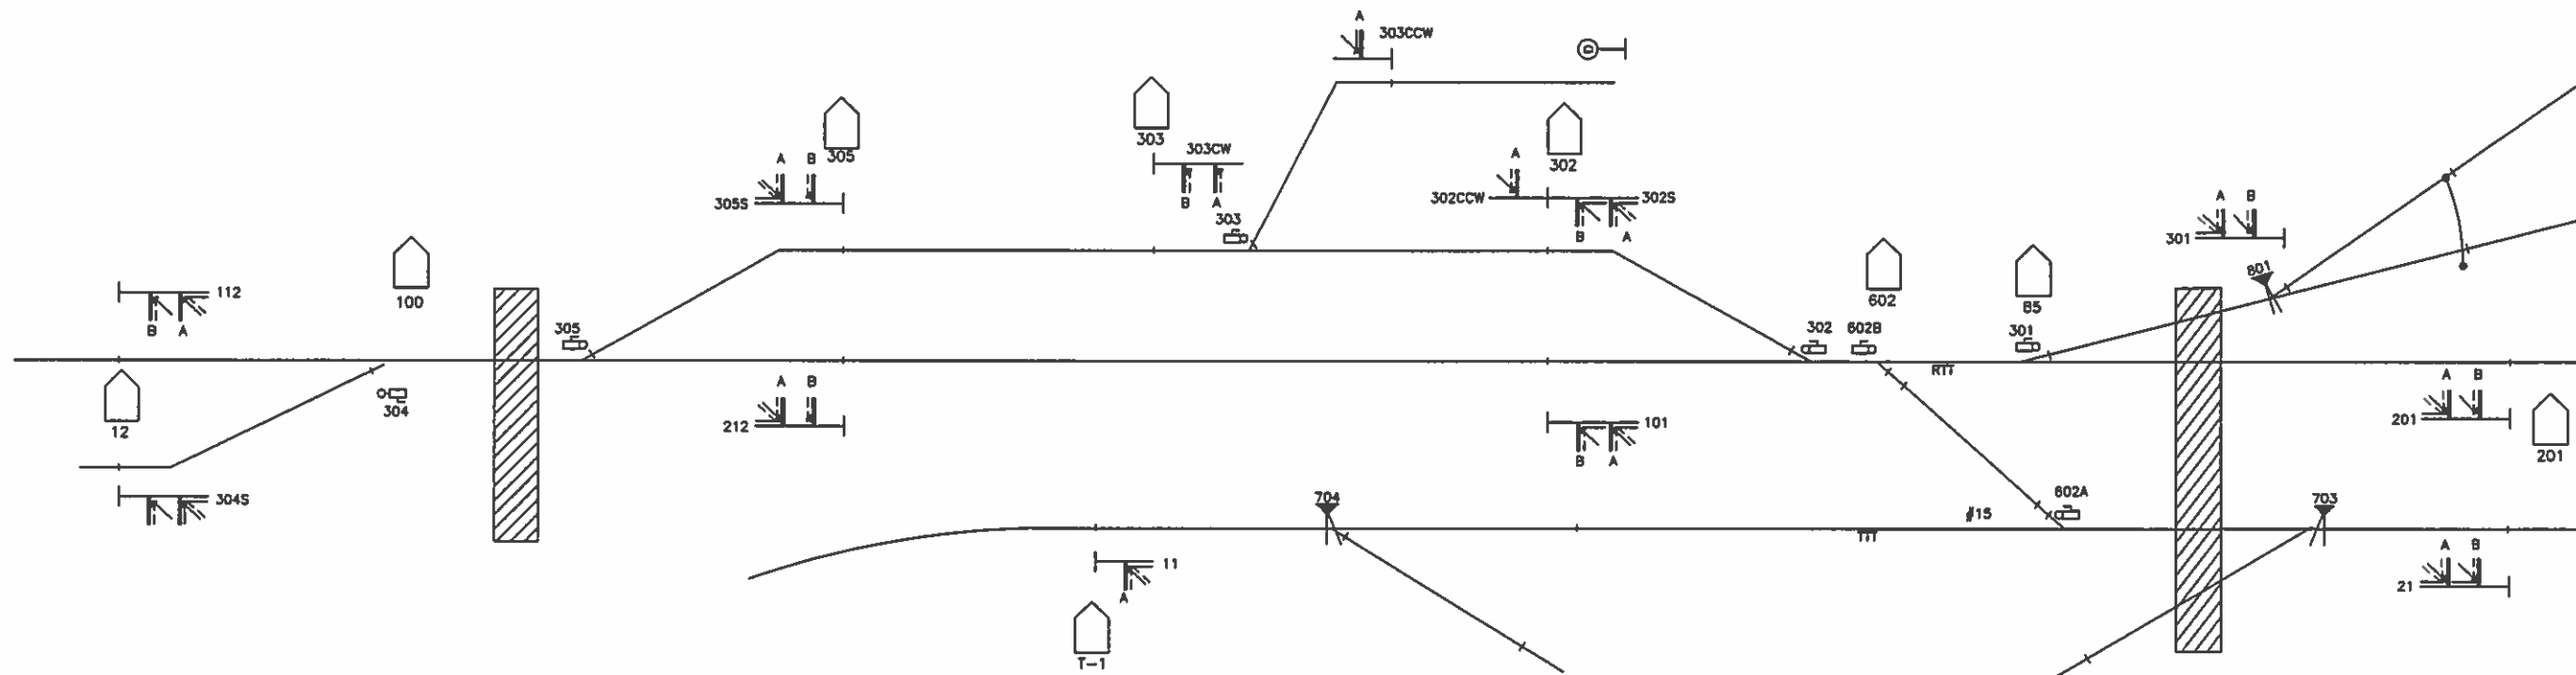

REV	DATE	DESCRIPTION
1	03/06/15	AS DESIGNED



Designed By:	BPC
Drawn By:	BPC
Checked By:	BDW
Approved By:	AEB

TTCI
TTT HOUSE T-1
RTT/TTT VITAL REMOTE NETWORKS

Scale:	NTS
CADD File Name:	T1013.DWG
Submitted Date:	03/06/15
Sheet No.	013

HOUSE T-2

						Designed By: BPC	TTCI TTT HOUSE T-2 COVER SHEET	Scale: NTS
						Drawn By: BPC		CADD File Name: T2000.DWG
						Checked By: BDW		Submitted Date: 03/06/15
2	03/30/15	UPDATES AFTER TTCI SITE SURVEY/DESIGN REVIEW				Approved By: AEB		
1	03/06/15	AS DESIGNED						Sheet No. 000
REV	DATE	DESCRIPTION						

CAB RATE	CODE	CODE
180	7	7
180	7	4
270	4	8
75	8	2
NO CAB	2	CW STICK
75	8	

CODE	CODE	CAB RATE
7	7	180
4	7	180
8	4	270
2	8	75
CW STICK	2	NO CAB
	8	75

TTT CAB RATE TABLE		
NAME	DESIGNATOR	RATE
CLEAR	C	180
CAB SPEED	CS	270
APPROACH LIMITED	AL?	120
APPROACH	A	75
RESTRICTING	R	NO CAB



2	03/30/15	ADDED COUNTER-CLOCKWISE CODES
1	03/06/15	AS DESIGNED
REV	DATE	DESCRIPTION



Designed By:	BPC
Drawn By:	BPC
Checked By:	BDW
Approved By:	AEB



TTCI
TTT HOUSE T-2
CODE & ASPECT CHART

Scale:	NTS
CADD File Name:	T2003.DWG
Submitted Date:	03/06/15
Sheet No.	003

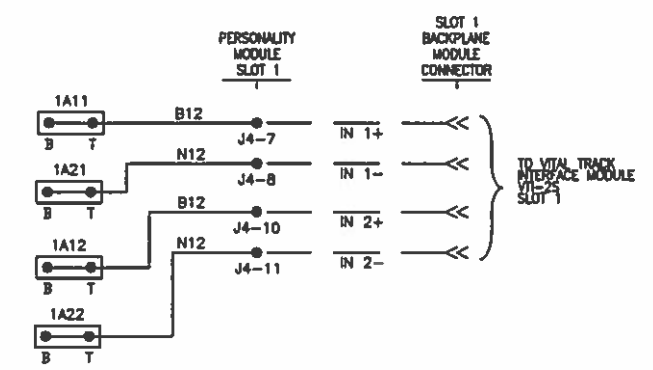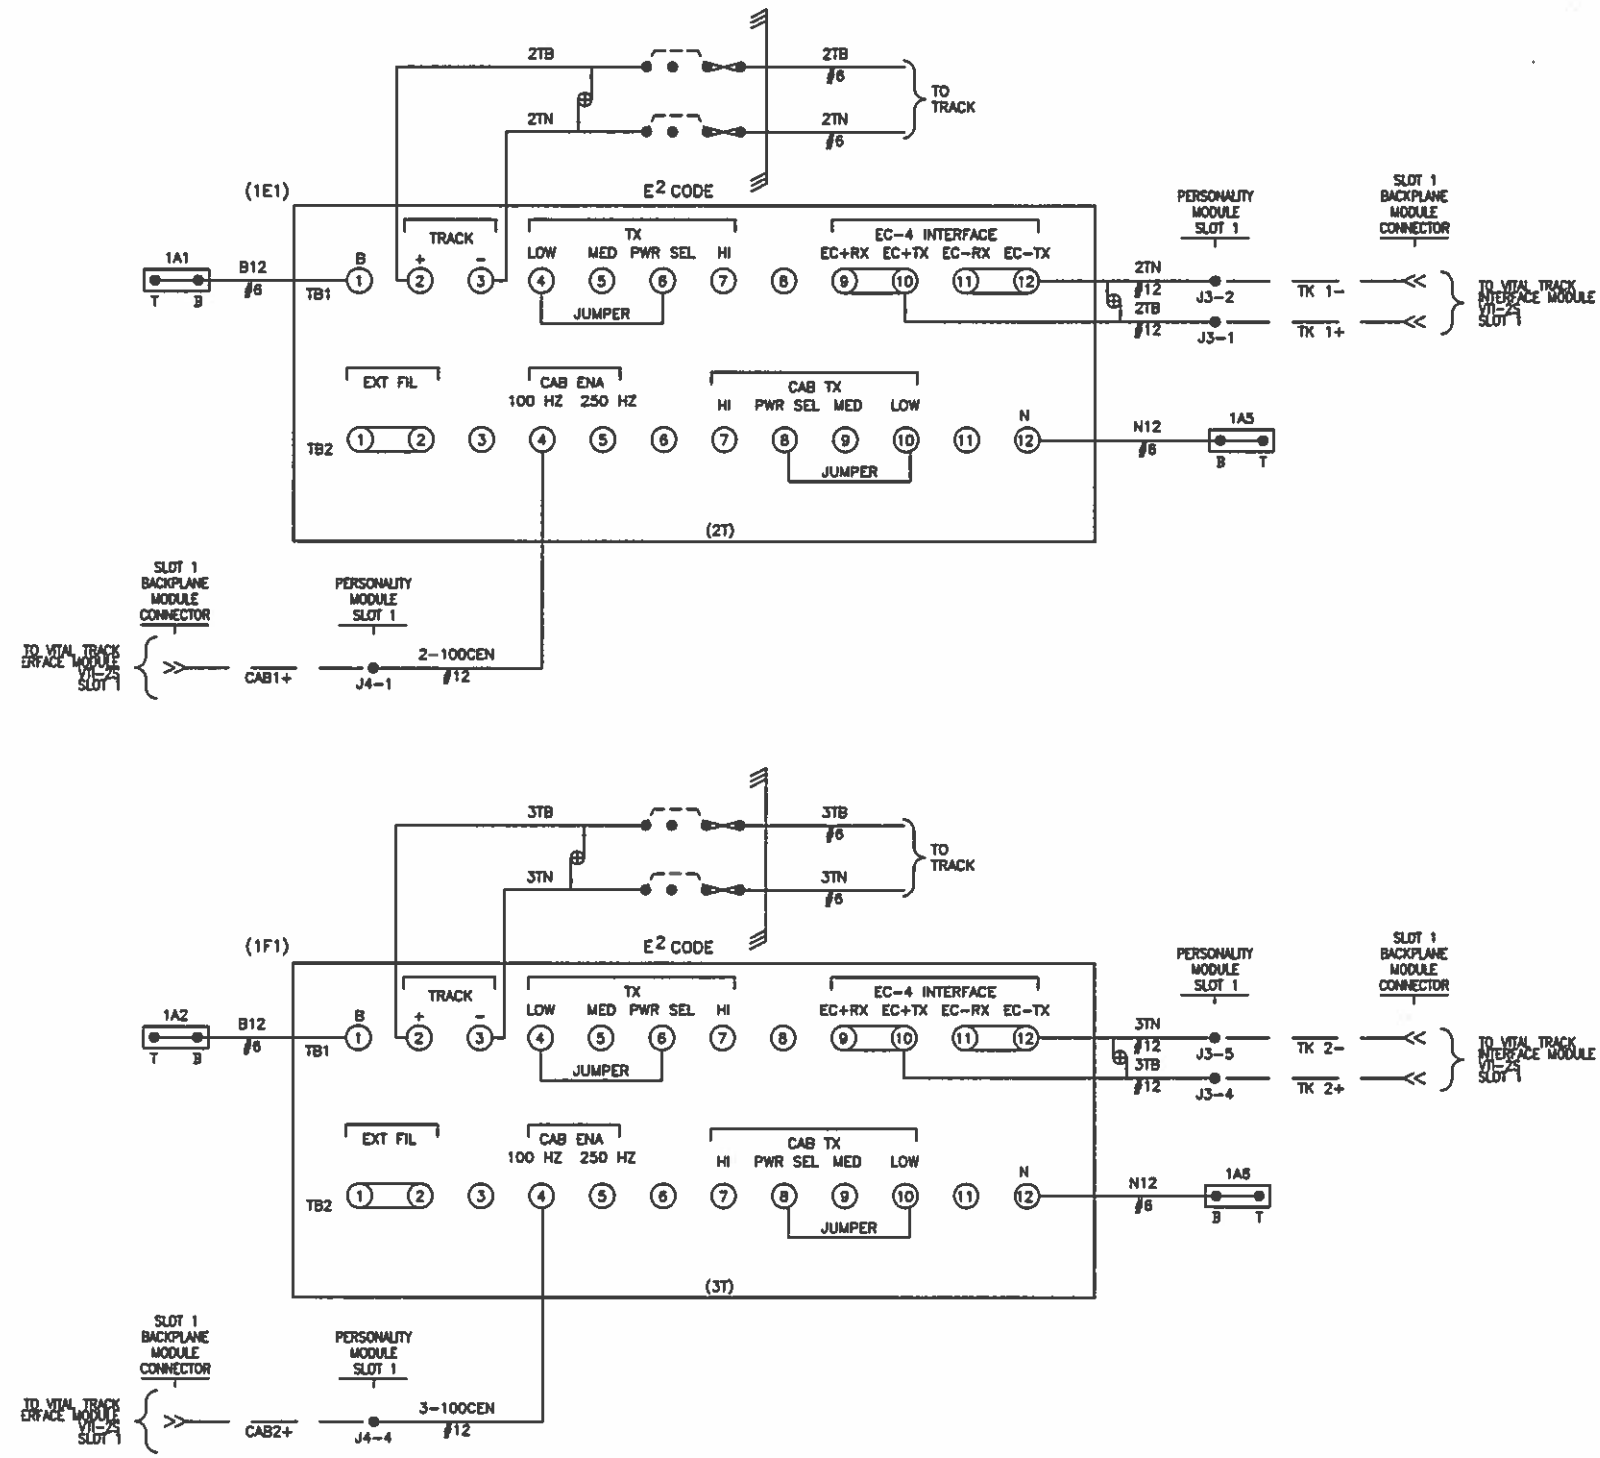

- NOTES:
- 1) ALL WIRING ON THIS SHEET TO BE #10 AWG UNLESS OTHERWISE NOTED.
 - 2) = TWISTED PAIR 2 TURNS PER FOOT.
 - 3) ----- = INTERNAL CONNECTION

				Designed By:	BPC	TTCI TTT HOUSE T-2 TRACK CIRCUITS	Scale: NTS	
				Drawn By:	BPC		CADD File Name: T2004.DWG	
				Checked By:	BDW		Submitted Date: 03/06/15	
				Approved By:	AEB			
1	03/06/15	AS DESIGNED						
REV	DATE	DESCRIPTION						

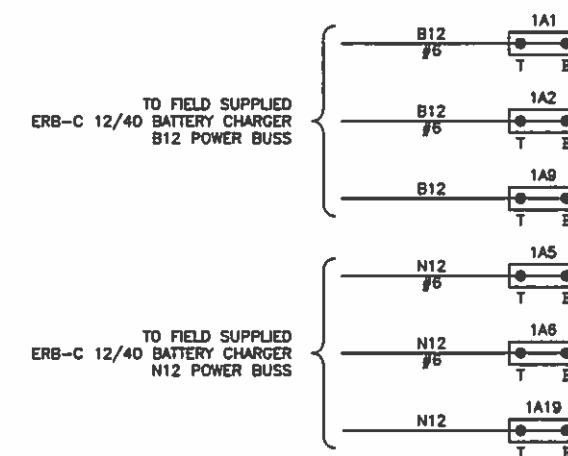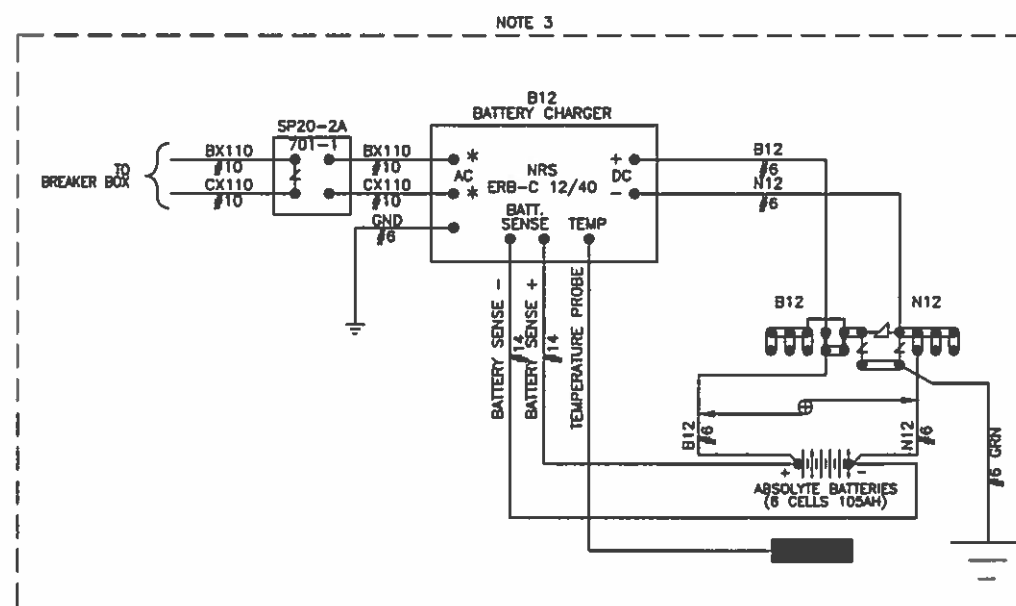

NOTES:

- 1) ALL SIGNAL WIRING ON THIS SHEET TO BE #10 AWG UNLESS OTHERWISE NOTED.
- 2)  = TWISTED PAIR 2 TURNS PER FOOT.
- 3) FIELD SUPPLIED

				Designed By:	BPC	TTCI TTT HOUSE T-2 POWER DISTRIBUTION CIRCUITS	Scale:	NTS
				Drawn By:	BPC		CADD File Name:	T2005.DWG
				Checked By:	BDW		Submitted Date:	03/06/15
				Approved By:	AEB			
1	03/06/15	AS DESIGNED						
REV	DATE	DESCRIPTION						Sheet No.


VT-2S
PERSONALITY
MODULE
(SLOT 1)

TK 1+	2TB	X	1
TK 1-	2TN	X	2
			3
TK 2+	3TB	X	4
TK 2-	3TN	X	5
			6
			7





J3

CAB1+	2-100CEN	X	1
CAB1-			2
			3
CAB2+	3-100CEN	X	4
CAB2-			5
			6
IN 1+	B12	X	7
IN 1-	N12	X	8
			9
IN 2+	B12	X	10
IN 2-	N12	X	11

J4

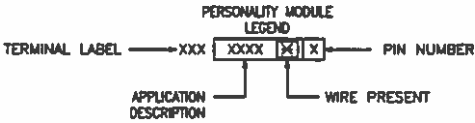

					Designed By: BPC	TTCI TTT HOUSE T-2 ELECTROLOGIXS 4-SLOT MODULE CONNECTOR USAGE	Scale: NTS
					Drawn By: BPC		CADD File Name: T2006.DWG
					Checked By: BDW		Submitted Date: 03/06/15
					Approved By: AEB		
1	03/06/15	AS DESIGNED		 GETS Global Signaling			Sheet No. 006
REV	DATE	DESCRIPTION					

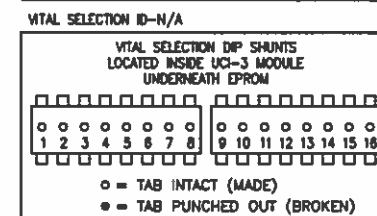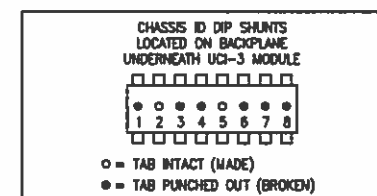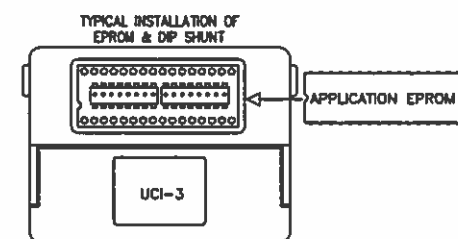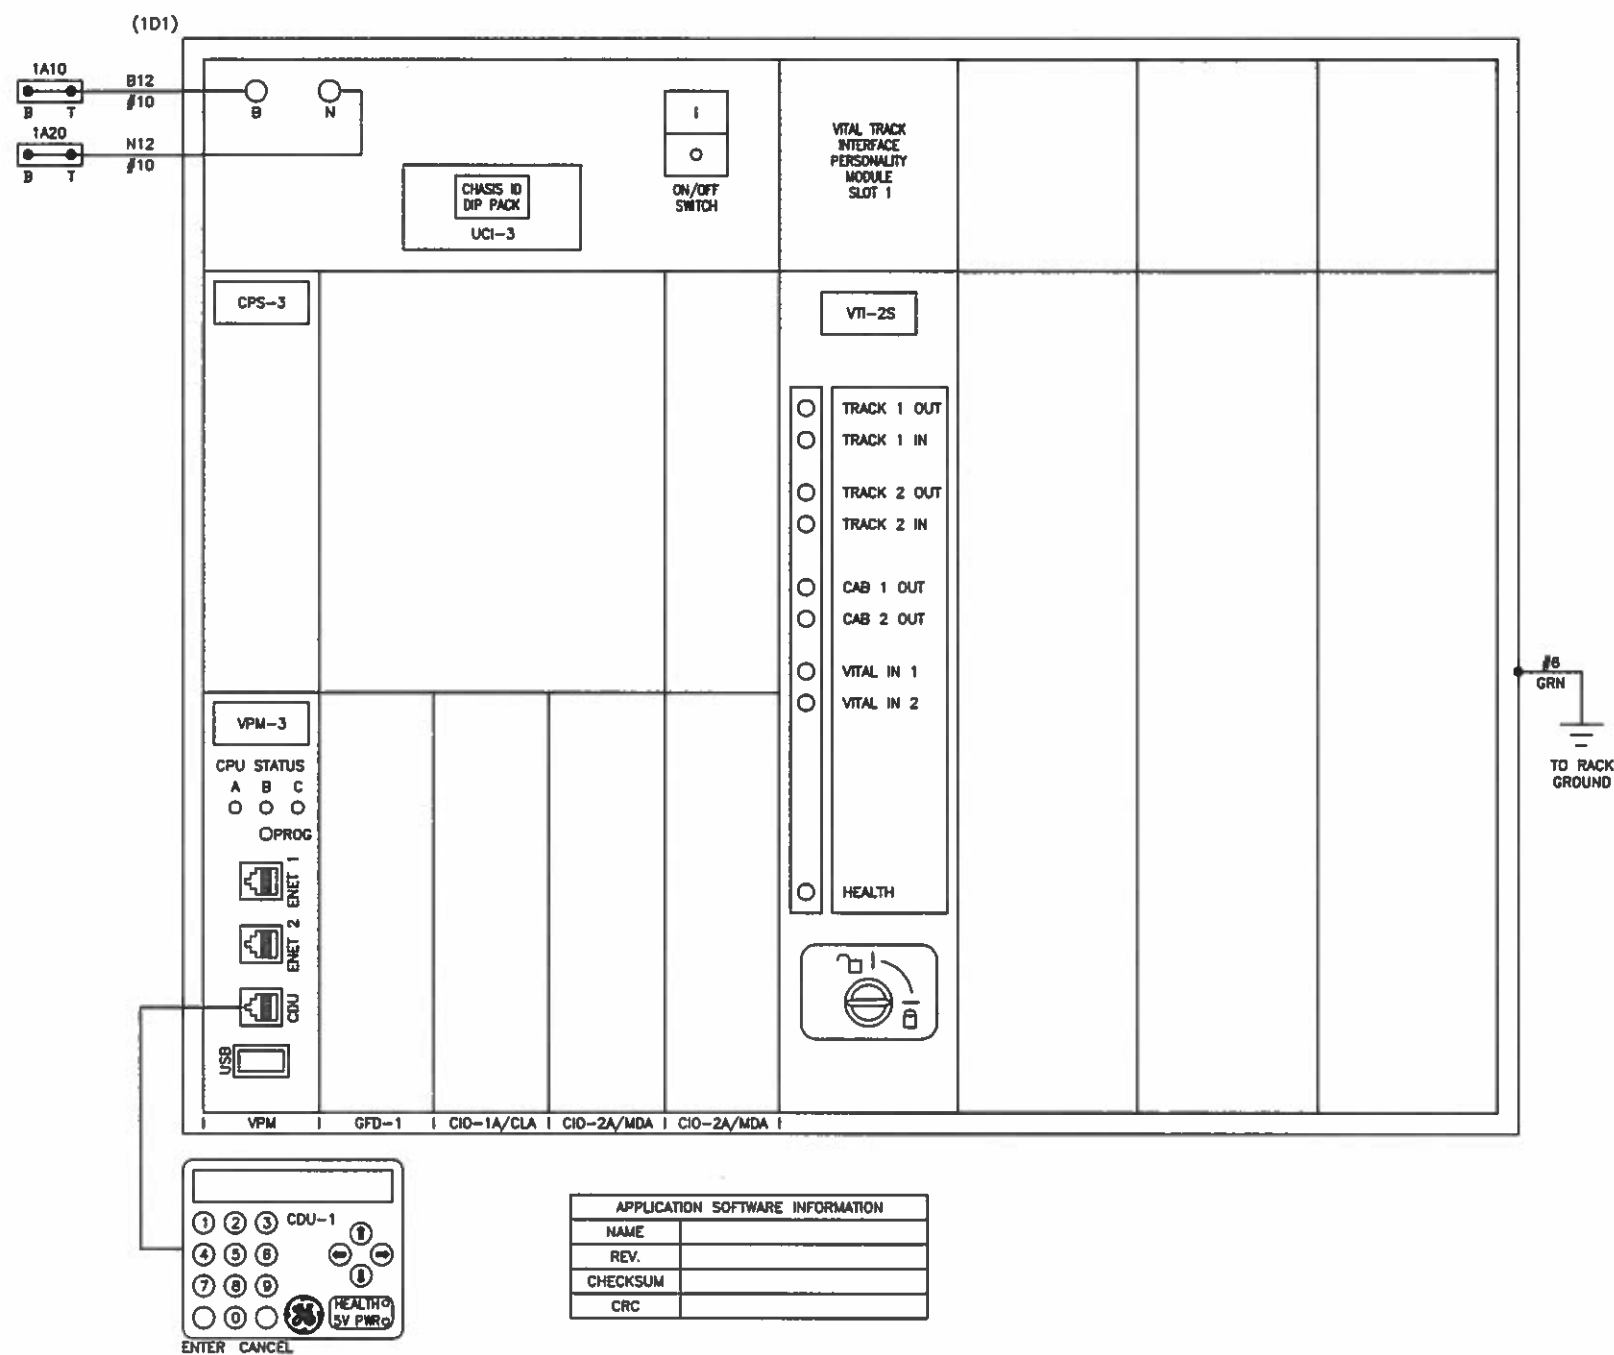

NOTES:

- CDU-1 = CONTROL DISPLAY UNIT
- CPS-3 = CENTRAL POWER SUPPLY
- VPM-3 = VITAL PERIPHERAL MASTER MODULE
- UCI-3 = CHASSIS INFORMATION MODULE
- VTI-2S = VITAL TRACK INTERFACE
- VLD-R16S = VITAL LAMP DRIVER MODULE
- VD-B6S = VITAL INPUTS/OUTPUTS
- CIO-CLA = COMMUNICATION INPUT/OUTPUT CURRENT LOOP ADAPTER

REV	DATE	DESCRIPTION
1	03/06/15	AS DESIGNED

GETS
Global Signaling

Designed By: BPC
Drawn By: BPC
Checked By: BDW
Approved By: AEB


TTCI
TIT HOUSE T-2
ELECTROLOGIXS 4-SLOT
HARDWARE CONFIGURATION

Scale: NTS
CADD File Name: T2007.DWG
Submitted Date: 03/06/15
Sheet No. 007


SYSTEM CONFIGURATION				
DATE/TIME	SETTING MADE WHEN USING PTC CONFIGURATION			
DIAGNOSTIC PORT				
ETHERNET CONFIG.				
OFFICE CONFIG	NA			
LCP CONFIG	ENABLED	TRUE		
VITAL REMOTE CONFIG	LOCAL PORT	REMOTE PORT	REMOTE PORT CONFIG	
	ETHERNET PORT 1 192.168.40.72	NA	NA	NA
	ETHERNET PORT 2 192.168.1.12	NA	NA	NA
	SERIAL PORT 2	NA		
	SERIAL PORT 3	NA		
TRACK CONFIG	SLOT	TRACK	CONFIGURATION	
	SLOT 1: 2T_711	1	TRANSMITTER	4V
			RECEIVER	0.5A
			CODE 5 TYPE	ALT 5
	SLOT 1: 3T_711	2	TRANSMITTER	4V
			RECEIVER	0.5A
			CODE 5 TYPE	ALT 5

NOTES:
1. FINAL VITAL CONFIGURATION SETTINGS ARE SUBJECT TO CHANGE IN ACCORDANCE WITH SOFTWARE UPGRADES. FINAL VITAL CONFIGURATION SETTINGS TO BE UPDATED ON AS-IN-SERVICE.

				Designed By:	BPC	TTCI TTT HOUSE T-2 ELECTROLOGIXS 4-SLOT CONFIGURATION SETTINGS	Sealer:	NTS
				Drawn By:	BPC		CADD File Name:	T2008.DWG
				Checked By:	BDW		Submitted Date:	03/06/15
				Approved By:	AEB			
							Sheet No.	008
1	03/06/15	AS DESIGNED						
REV	DATE	DESCRIPTION						

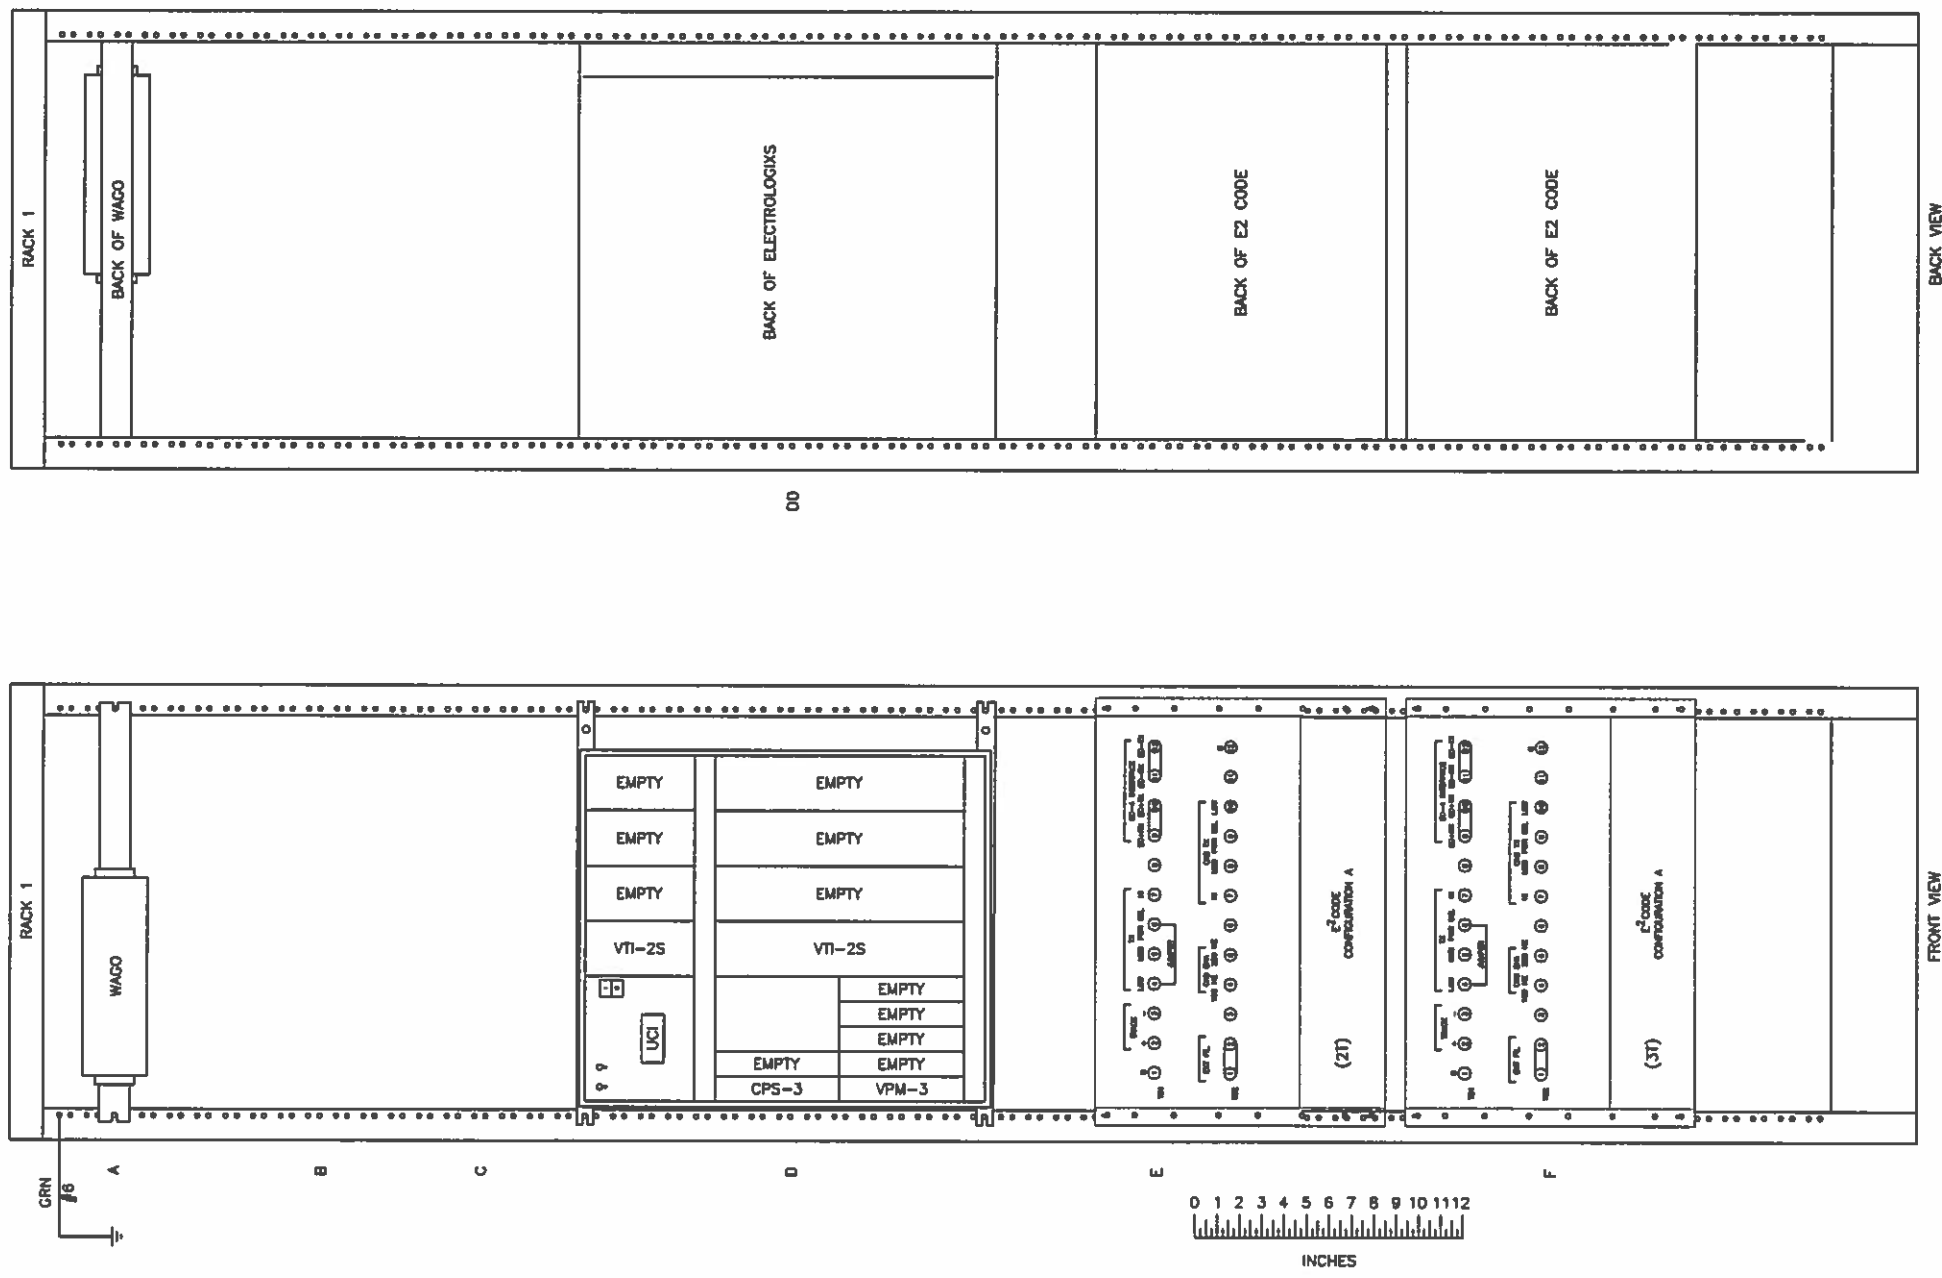

				Designed By:	BPC	TTCI TTT HOUSE T-2 RACK 1 LAYOUT	Scale:	NTS	
				Drawn By:	BPC		CADD File Name:	T2009.DWG	
				Checked By:	BDW		Submitted Date:	03/06/15	
				Approved By:	AEB				
1	03/06/15	AS DESIGNED							
REV	DATE	DESCRIPTION						Sheet No.	009

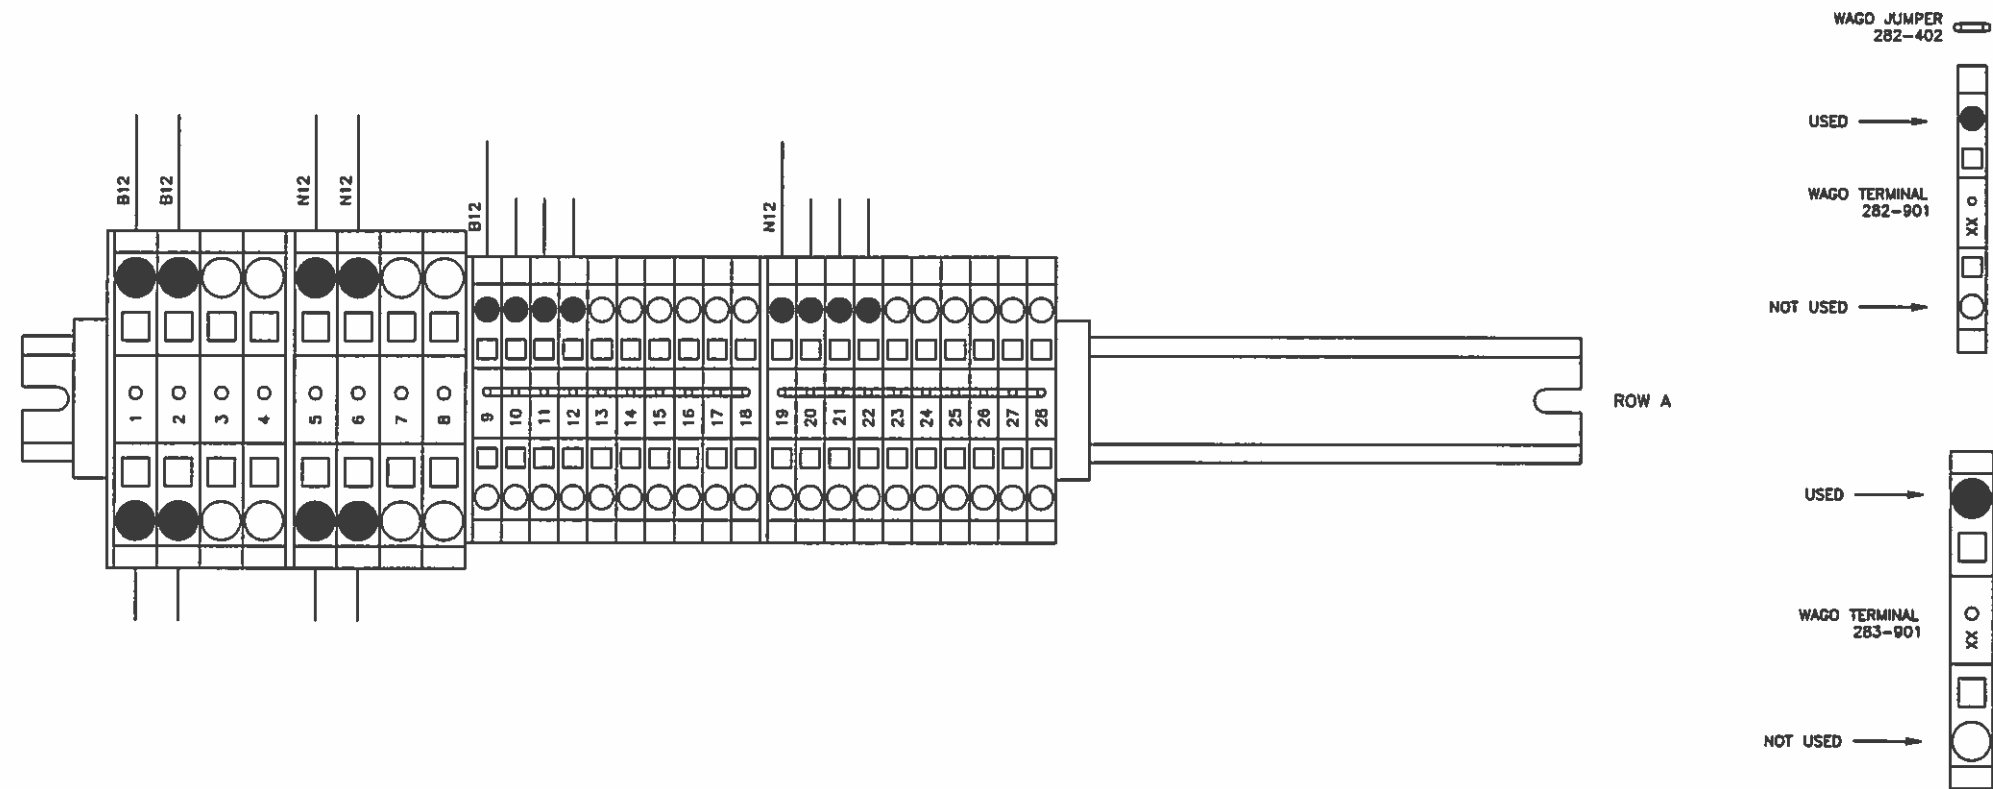

				Designed By:	BPC	TTCI	Scale:	NTS
				Drawn By:	BPC		CADD File Name:	T2010.DWG
				Checked By:	BDW		Submitted Date:	03/06/15
				Approved By:	AEB			
1	03/06/15	AS DESIGNED		TTT HOUSE T-2				
REV	DATE	DESCRIPTION		WAGO & RELAY LAYOUT RACK 1, ROW A & B				Sheet No. 010


HOUSE T-3

				Designed By:	BPC	TTCI TTT HOUSE T-3 COVER SHEET	Scale: NTS	
				Drawn By:	BPC		CADD File Name: T3000.DWG	
				Checked By:	BDW		Submitted Date: 03/06/15	
				Approved By:	AEB			
							Sheet No. 000	
1	03/06/15	AS DESIGNED						
REV	DATE	DESCRIPTION						

INDEX OF DRAWINGS			
SHT. NO.	DWG. NO.	REV.	DESCRIPTION
000	T3000.DWG	1	COVER SHEET
001	T3001.DWG	1	INDEX
002	T3002.DWG	1	TRACK & SIGNAL PLAN
003	T3003.DWG	1	CODE & ASPECT CHART
004	T3004.DWG	1	TRACK CIRCUITS
005	T3005.DWG	1	POWER DISTRIBUTION CIRCUITS
006	T3006.DWG	1	ELECTROLOGIXS 4-SLOT MODULE CONNECTOR USAGE
007	T3007.DWG	1	ELECTROLOGIXS 4-SLOT HARDWARE CONFIGURATION
008	T3008.DWG	1	ELECTROLOGIXS 4-SLOT CONFIGURATION SETTINGS
009	T3009.DWG	1	RACK 1 LAYOUT
010	T3010.DWG	1	WAGO & RELAY LAYOUT RACK 1, ROW A & B

					Designed By:	BPC	TTCI TTT HOUSE T-3 INDEX	Scale:	NTS
					Drawn By:	BPC		CADD File Name:	T3001.DWG
					Checked By:	BDW		Submitted Date:	03/06/15
					Approved By:	AEB			
1	03/06/15	AS DESIGNED							Sheet No.
REV	DATE	DESCRIPTION							001



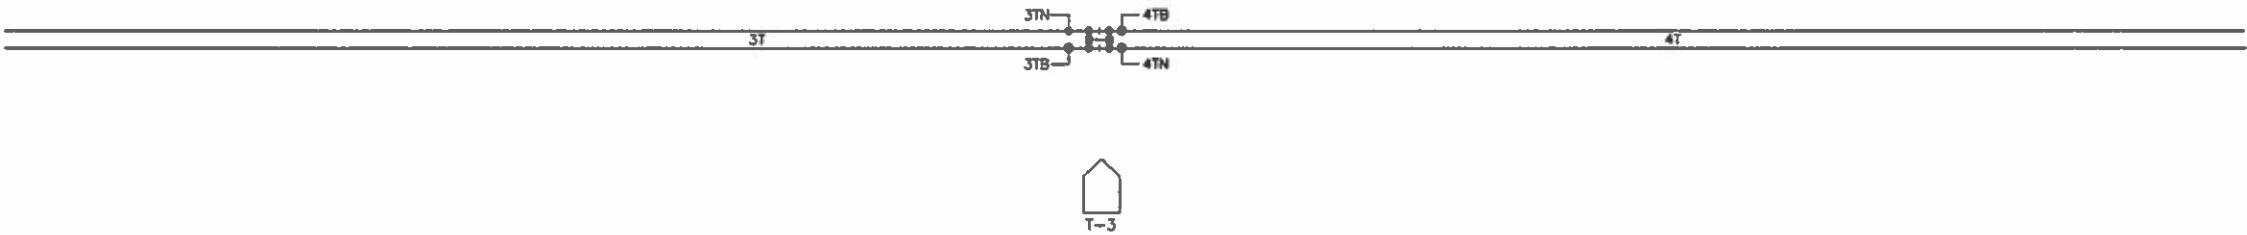

				Designed By:	BPC	TTCI TTT HOUSE T-3 TRACK & SIGNAL PLAN	Scale: NTS	
				Drawn By:	BPC		CADD File Name: T3002.DWG	
				Checked By:	BDW		Submitted Date: 03/06/15	
				Approved By:	AEB			Sheet No.
								002
1	03/06/15	AS DESIGNED						
REV	DATE	DESCRIPTION						

CAB RATE	CODE	CODE
180	7	7
180	7	4
270	4	8
75	8	2
NO CAB	2	CW STICK
75	8	

CODE	CODE	CAB RATE
7	7	180
4	7	180
8	4	270
2	8	75
CW STICK	2	NO CAB
	8	75

TTT CAB RATE TABLE		
NAME	DESIGNATOR	RATE
CLEAR	C	180
CAB SPEED	CS	270
APPROACH LIMITED	AL?	120
APPROACH	A	75
RESTRICTING	R	NO CAB



1	03/06/15	AS DESIGNED
REV	DATE	DESCRIPTION



Designed By:	BPC
Drawn By:	BPC
Checked By:	BDW
Approved By:	AEB



TTCI
TTT HOUSE T-3
CODE & ASPECT CHART

Scale:	NTS
CADD File Name:	T3003.DWG
Submitted Date:	03/06/15
Sheet No.	003

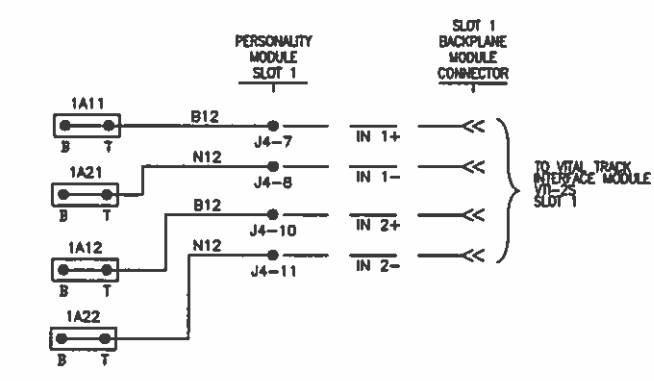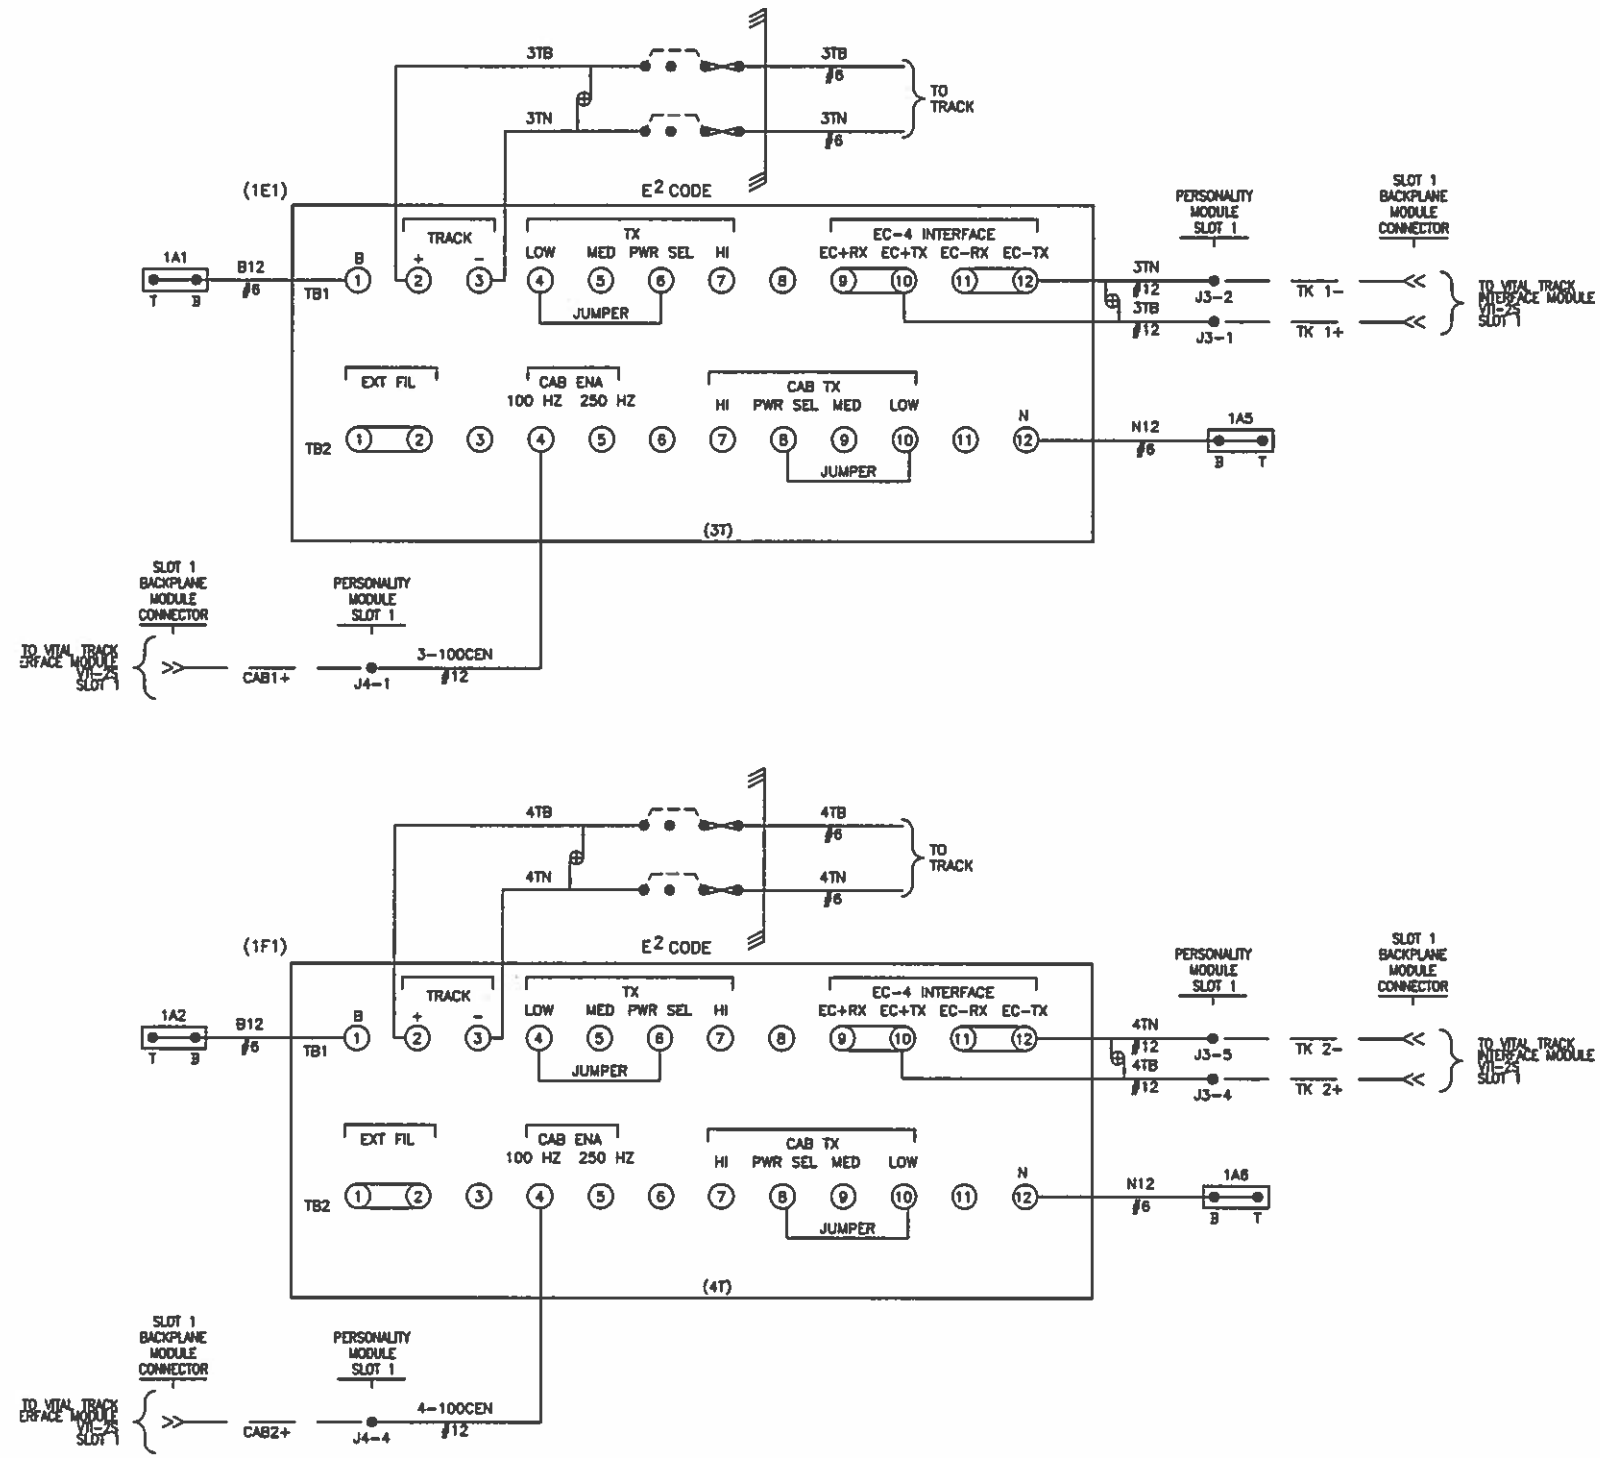

- NOTES:**
- 1) ALL WIRING ON THIS SHEET TO BE #10 AWG UNLESS OTHERWISE NOTED.
 - 2) TP = TWISTED PAIR 2 TURNS PER FOOT.
 - 3) ----- = INTERNAL CONNECTION

				Designed By:	BPC	TTCI TTT HOUSE T-3 TRACK CIRCUITS	Sealer:	NTS
				Drawn By:	BPC		CADD File Name:	T3004.DWG
				Checked By:	BDW		Submitted Date:	03/06/15
				Approved By:	AEB			
1	03/06/15	AS DESIGNED						
REV	DATE	DESCRIPTION						Sheet No. 004

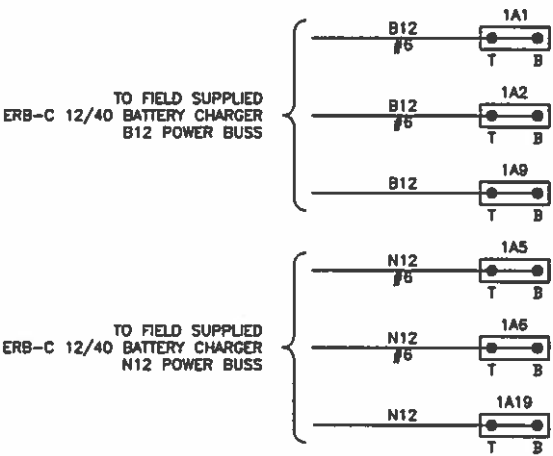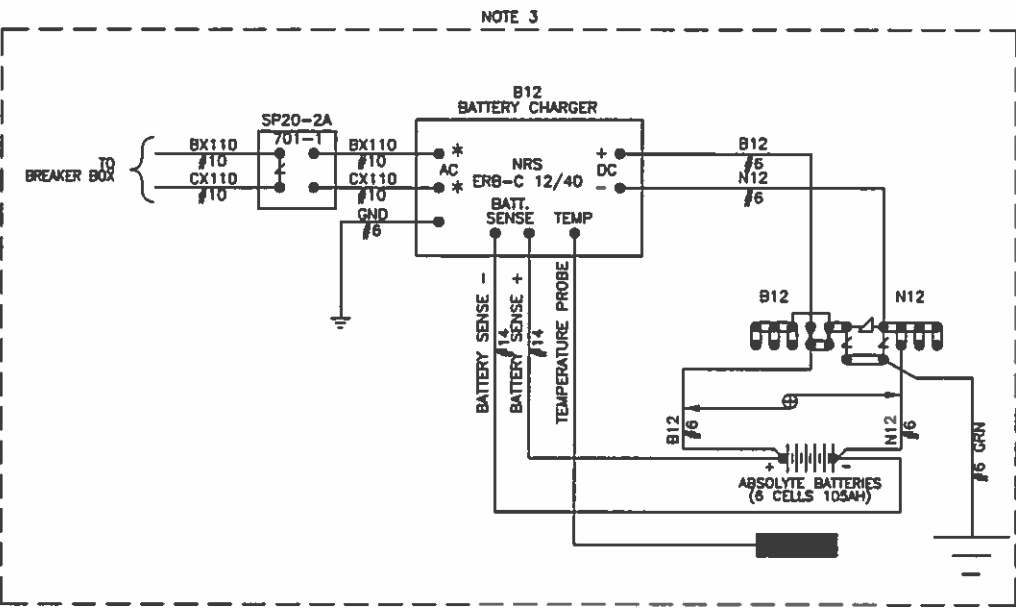

- NOTES:
- 1) ALL SIGNAL WIRING ON THIS SHEET TO BE #10 AWG UNLESS OTHERWISE NOTED.
 - 2) = TWISTED PAIR 2 TURNS PER FOOT.
 - 3) FIELD SUPPLIED

1	03/06/15	AS DESIGNED
REV	DATE	DESCRIPTION



Designed By:	BPC
Drawn By:	BPC
Checked By:	BDW
Approved By:	AEB

TTCI
TTT HOUSE T-3
POWER DISTRIBUTION CIRCUITS


Scale:	NTS
CADD File Name:	T3005.DWG
Submitted Date:	03/06/15
Sheet No.	005

VII-2S PERSONALITY MODULE (SLOT 1)				
TK 1+	3TB	X		1
TK 1-	3TN	X		2
				3
TK 2+	4TB	X		4
TK 2-	4TN	X		5
				6
				7

J3





CAB1+	3-100CEN	X		1
CAB1-				2
				3
CAB2+	4-100CEN	X		4
CAB2-				5
				6
IN 1+	B12	X		7
IN 1-	N12	X		8
				9
IN 2+	B12	X		10
IN 2-	N12	X		11

J4

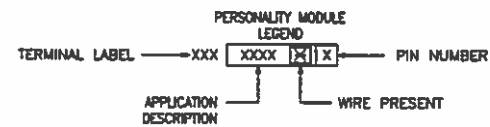


					Designed By:	BPC	TTCI	Scale:	NTS
					Drawn By:	BPC		CADD File Name:	T3006.DWG
					Checked By:	BDW	TTT HOUSE T-3	Submitted Date:	03/06/15
					Approved By:	AEB	ELECTROLOGIXS 4-SLOT MODULE CONNECTOR USAGE		Sheet No.
									006
1	03/06/15	AS DESIGNED							
REV	DATE	DESCRIPTION							



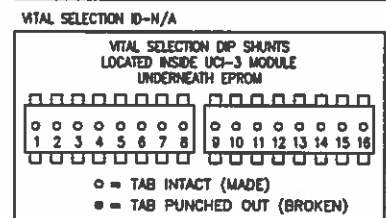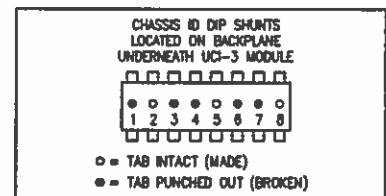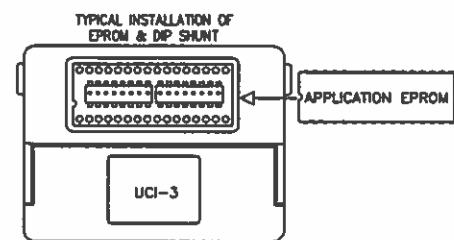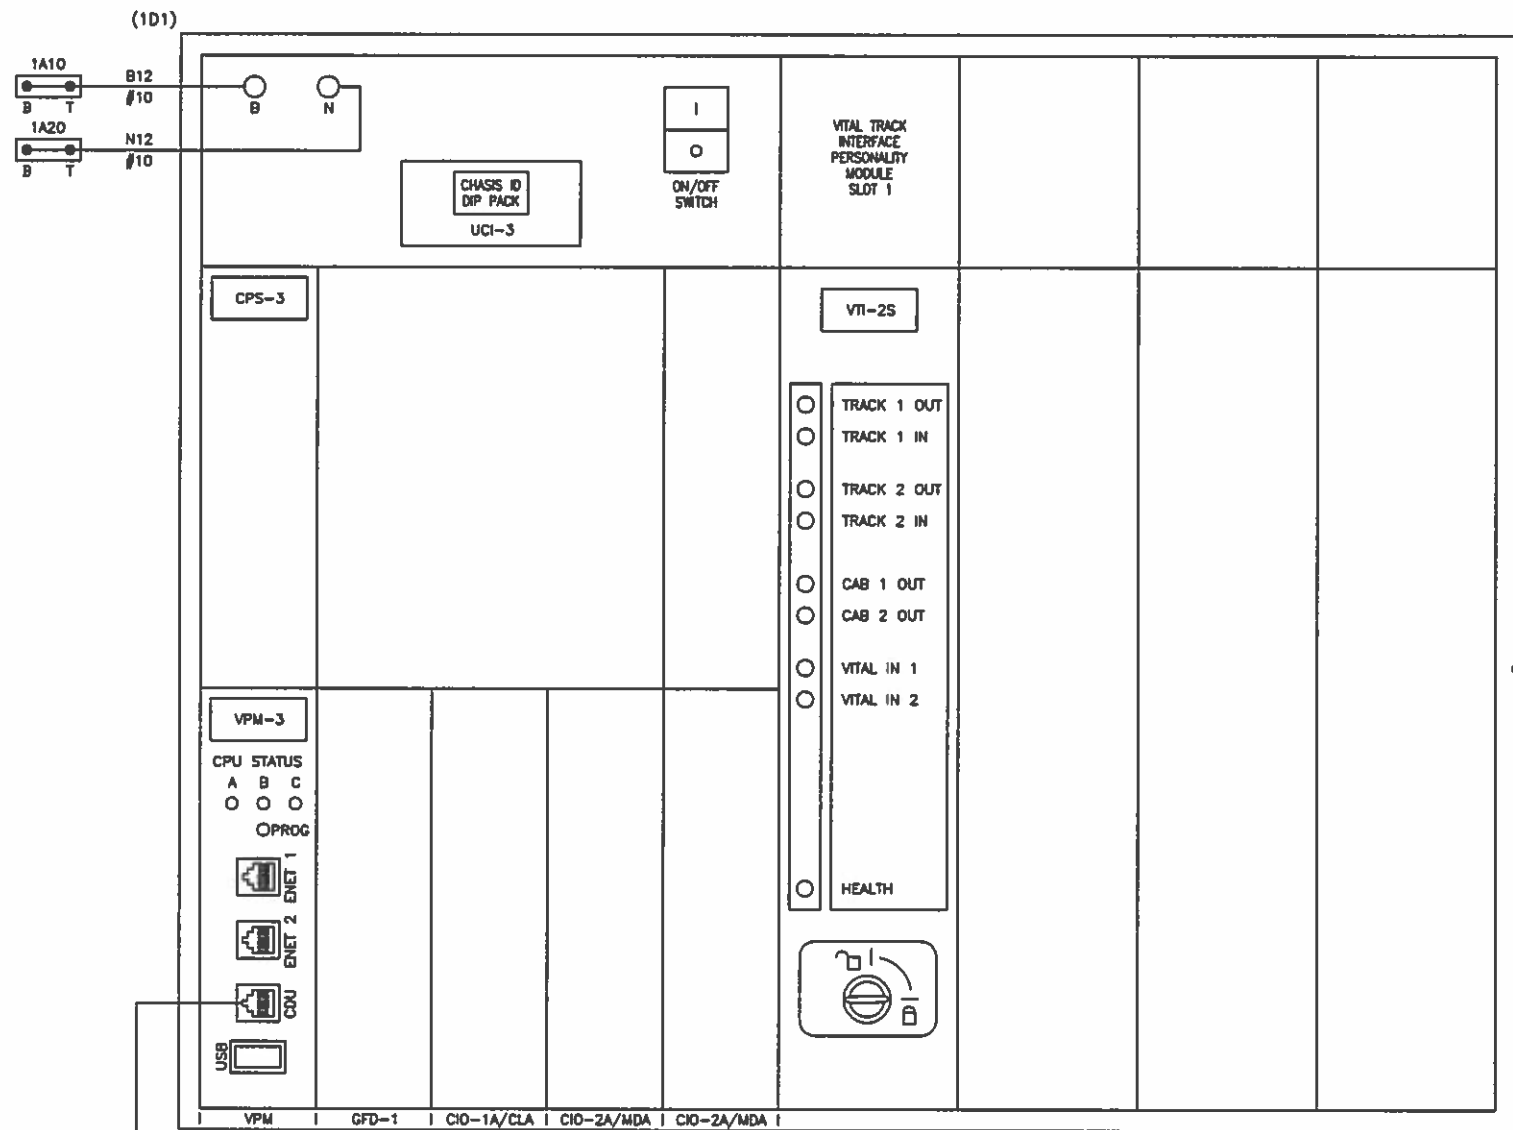

NOTES:

- CDU-1 = CONTROL DISPLAY UNIT
- CPS-3 = CENTRAL POWER SUPPLY
- VPM-3 = VITAL PERIPHERAL MASTER MODULE
- UCI-3 = CHASSIS INFORMATION MODULE
- VTI-25 = VITAL TRACK INTERFACE
- VLD-16S = VITAL LAMP DRIVER MODULE
- VI-86S = VITAL INPUTS/OUTPUTS
- CIO-CLA = COMMUNICATION INPUT/OUTPUT CURRENT LOOP ADAPTER

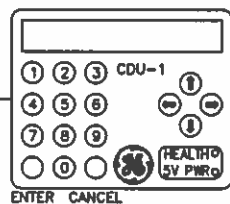

APPLICATION SOFTWARE INFORMATION	
NAME	
REV.	
CHECKSUM	
CRC	

REV	DATE	DESCRIPTION
1	03/06/15	AS DESIGNED



Designed By:	BPC
Drawn By:	BPC
Checked By:	BDW
Approved By:	AEB


TTCI
TTT HOUSE T-3
ELECTROLOGIXS 4-SLOT
HARDWARE CONFIGURATION

Scale:	NTS
CADD File Name:	T3007.DWG
Submitted Date:	03/06/15
Sheet No.	007


SYSTEM CONFIGURATION				
DATE/TIME	SETTING MADE WHEN USING PTC CONFIGURATION			
DIAGNOSTIC PORT				
ETHERNET CONFIG.				
OFFICE CONFIG	NA			
LCP CONFIG	ENABLED	TRUE		
VITAL REMOTE CONFIG	LOCAL PORT	REMOTE PORT	REMOTE PORT CONFIG	
	ETHERNET PORT 1 192.168.40.73	NA	NA	NA
	ETHERNET PORT 2 192.168.1.12	NA	NA	NA
	SERIAL PORT 2	NA		
	SERIAL PORT 3	NA		
TRACK CONFIG	SLOT	TRACK	CONFIGURATION	
	SLOT 1: 3T_T11	1	TRANSMITTER	4V
			RECEIVER	0.5A
			CODE 5 TYPE	ALT 5
	SLOT 1: 4T_T11	2	TRANSMITTER	4V
			RECEIVER	0.5A
			CODE 5 TYPE	ALT 5

NOTES:
1. FINAL VITAL CONFIGURATION SETTINGS ARE SUBJECT TO CHANGE IN ACCORDANCE WITH SOFTWARE UPGRADES. FINAL VITAL CONFIGURATION SETTINGS TO BE UPDATED ON AS-IN-SERVICE.

				Designed By:	BPC	TTCI TTT HOUSE T-3 ELECTROLOGIXS 4-SLOT CONFIGURATION SETTINGS	Scale:	NTS
				Drawn By:	BPC		CADD File Name:	T3008.DWG
				Checked By:	BDW		Submitted Date:	03/06/15
				Approved By:	AEB			
								Sheet No.
1	03/06/15	AS DESIGNED						008
REV	DATE	DESCRIPTION						

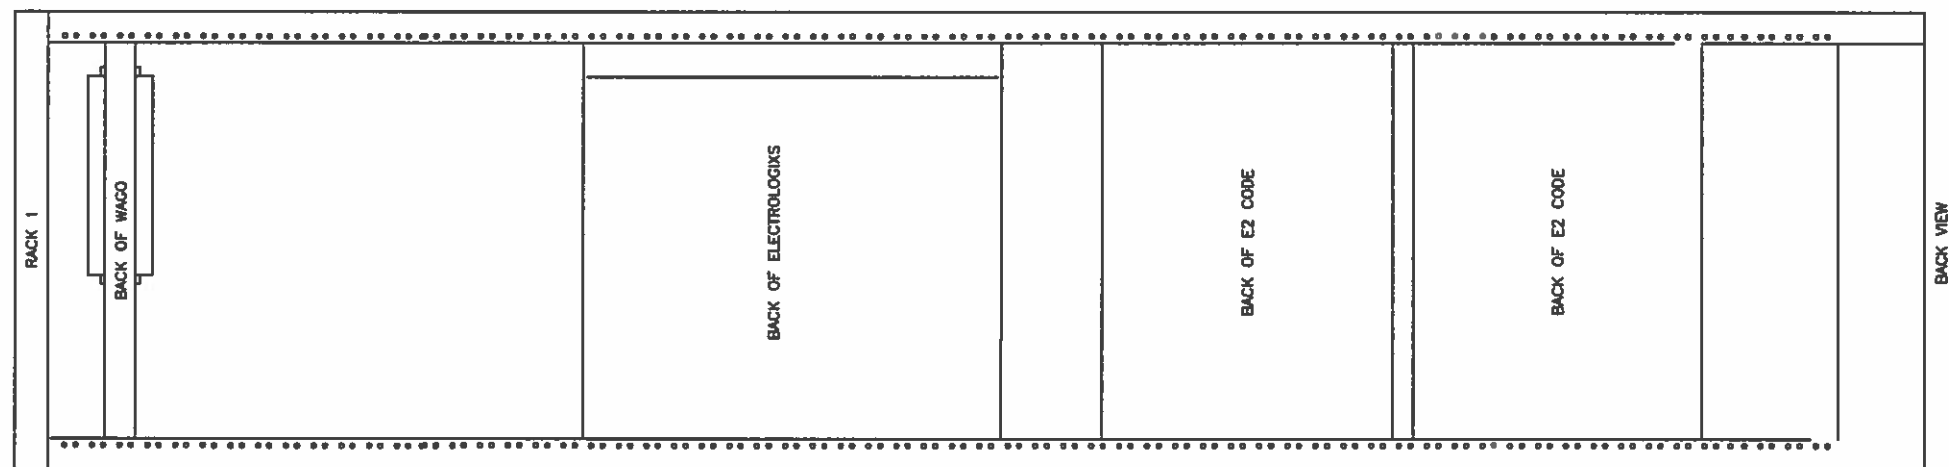

D0

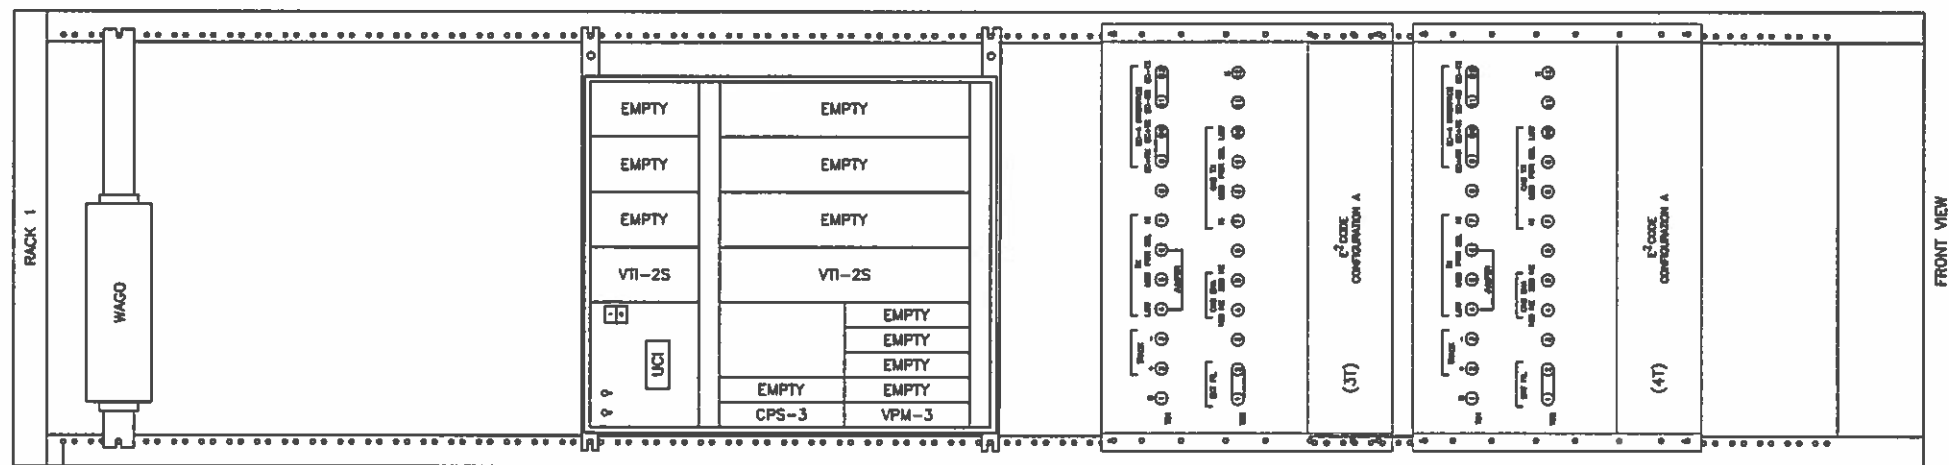

GRN
7/8
A

B

C

D

E

F

0 1 2 3 4 5 6 7 8 9 10 11 12
INCHES


REV	DATE	DESCRIPTION
1	03/06/15	AS DESIGNED




Designed By:	BPC
Drawn By:	BPC
Checked By:	BDW
Approved By:	AEB

TTCI
TTT HOUSE T-3
RACK 1 LAYOUT

Scale:	NTS
CADD File Name:	T3009.DWG
Submitted Date:	03/06/15
Sheet No.	009

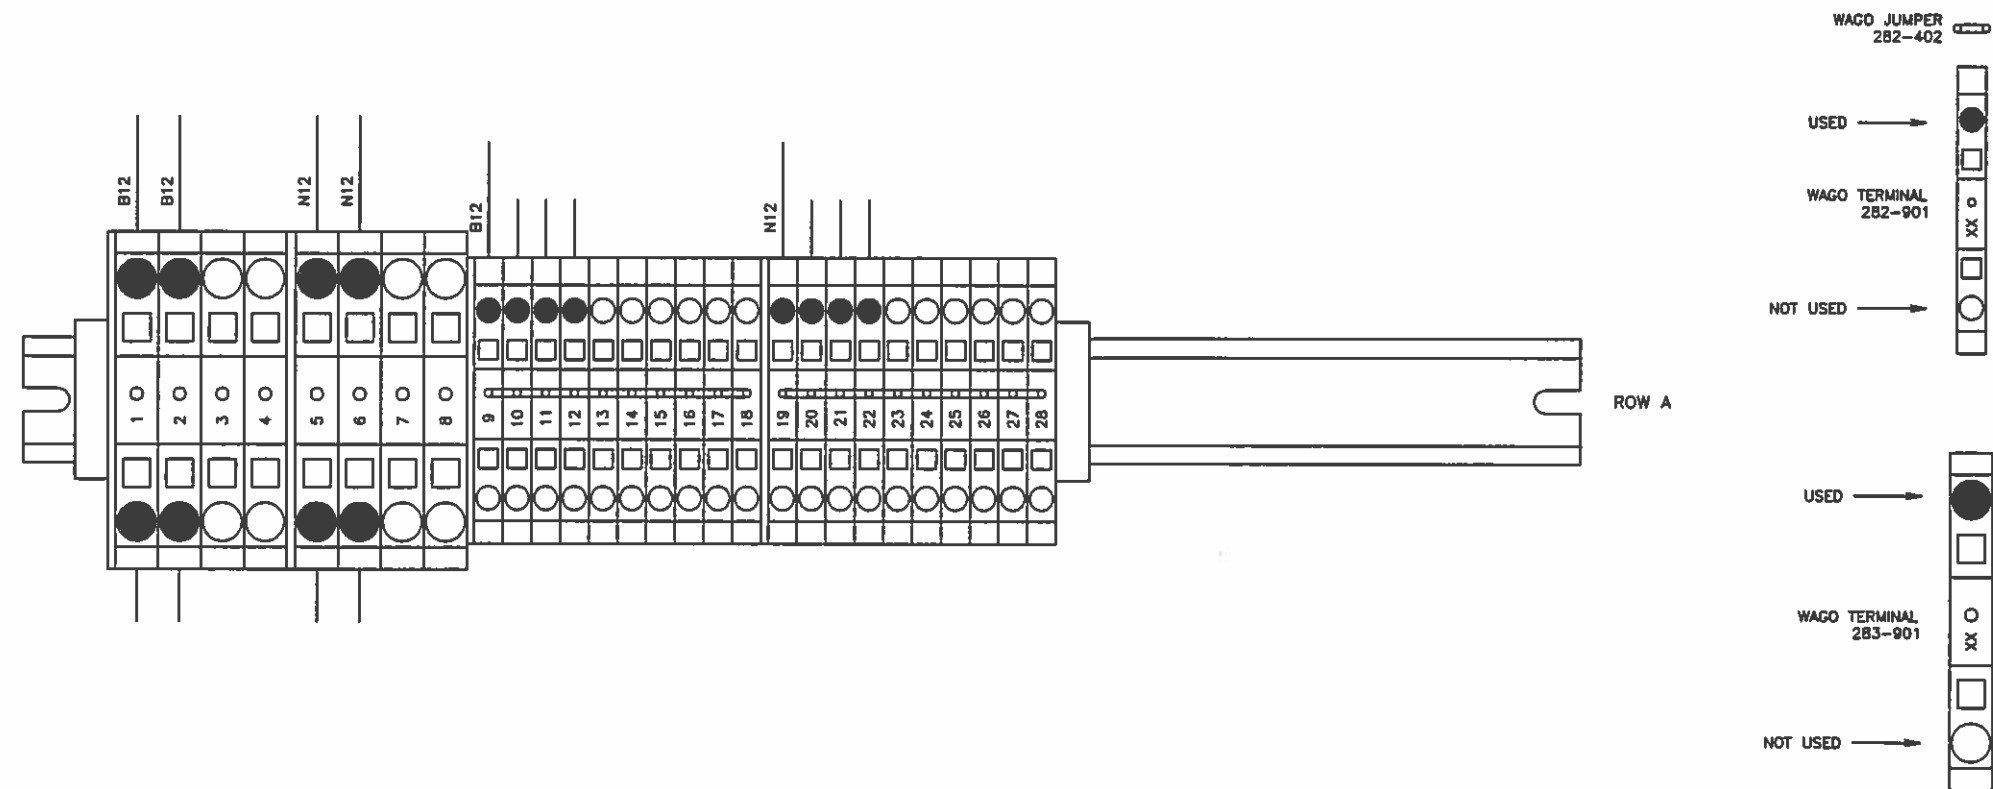

				Designed By:	BPC	NTCI TTT HOUSE T-3 WAGO & RELAY LAYOUT RACK 1, ROW A & B	Scale:	NTS
				Drawn By:	BPC		CADD File Name:	T3010.DWG
				Checked By:	BDW		Submitted Date:	03/06/15
				Approved By:	AEB			
1	03/06/15	AS DESIGNED						
REV	DATE	DESCRIPTION						Sheet No. 010

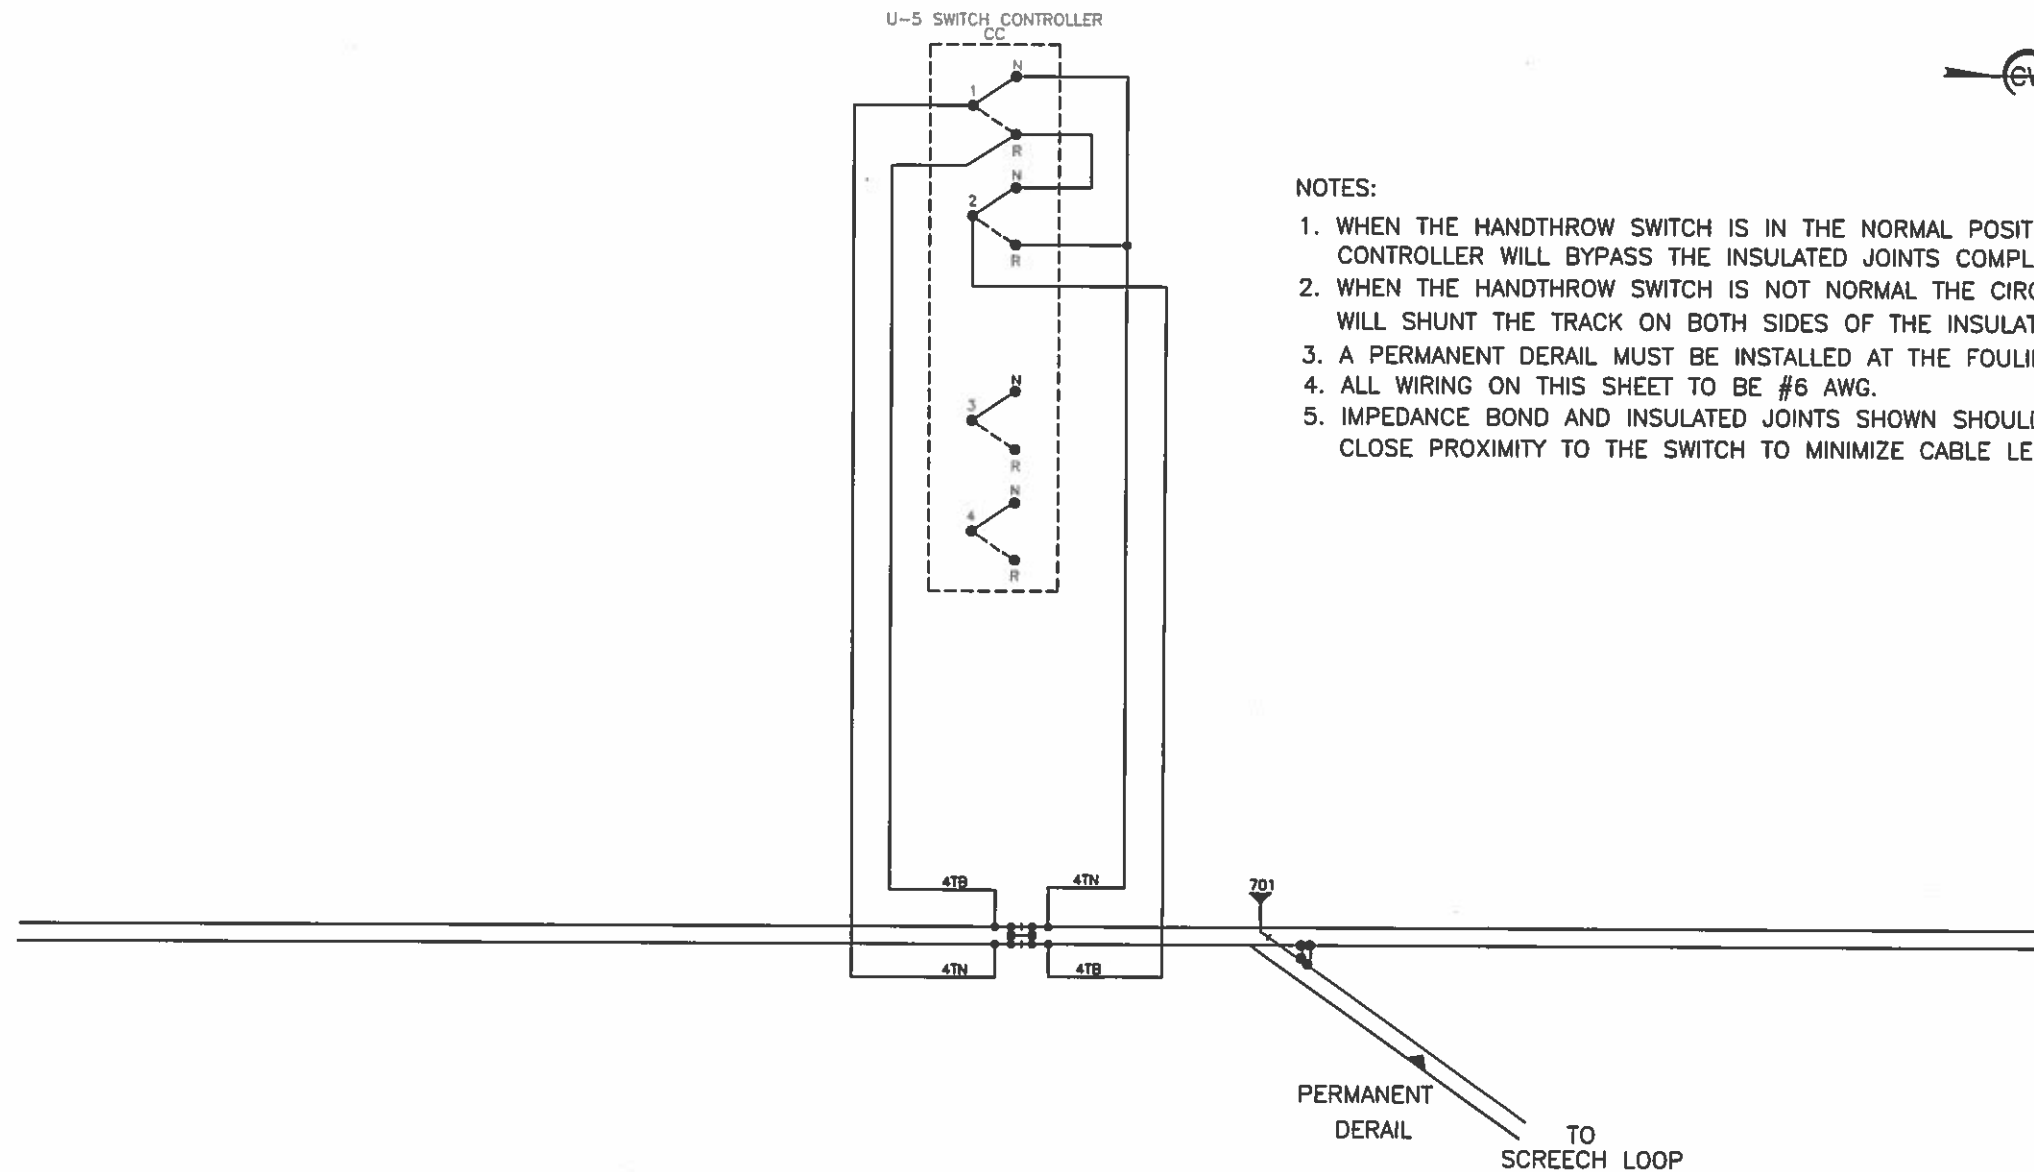

NOTES:

1. WHEN THE HANDTHROW SWITCH IS IN THE NORMAL POSITION THE CIRCUIT CONTROLLER WILL BYPASS THE INSULATED JOINTS COMPLETING THE TRACK CIRCUIT.
2. WHEN THE HANDTHROW SWITCH IS NOT NORMAL THE CIRCUIT CONTROLLER WILL SHUNT THE TRACK ON BOTH SIDES OF THE INSULATED JOINT.
3. A PERMANENT DERAIL MUST BE INSTALLED AT THE FOULING POINT.
4. ALL WIRING ON THIS SHEET TO BE #6 AWG.
5. IMPEDANCE BOND AND INSULATED JOINTS SHOWN SHOULD BE ADDED IN CLOSE PROXIMITY TO THE SWITCH TO MINIMIZE CABLE LENGTH.

				Designed By:	BPC	TTCI TTT HANDTHROW SWITCH 701	Scale:	NTS
				Drawn By:	BPC		CADD File Name:	TSW701.DWG
				Checked By:	BDW		Submitted Date:	03/11/15
				Approved By:	AEB			
								Sheet No.
2	03/30/15	UPDATES FROM SITE SURVEY/PLAN REVIEWS						
1	03/11/15	AS DESIGNED						
REV	DATE	DESCRIPTION						


HOUSE T-4

--	--	
INDEX OF DRAWINGS			
SHT. NO.	DWG. NO.	REV.	DESCRIPTION
000	T4000.DWG	1	COVER SHEET
001	T4001.DWG	1	INDEX
002	T4002.DWG	1	TRACK & SIGNAL PLAN
003	T4003.DWG	1	CODE & ASPECT CHART
004	T4004.DWG	1	TRACK CIRCUITS
005	T4005.DWG	1	POWER DISTRIBUTION CIRCUITS
006	T4006.DWG	1	ELECTROLOGIXS 4-SLOT MODULE CONNECTOR USAGE
007	T4007.DWG	1	ELECTROLOGIXS 4-SLOT HARDWARE CONFIGURATION
008	T4008.DWG	1	ELECTROLOGIXS 4-SLOT CONFIGURATION SETTINGS
009	T4009.DWG	1	RACK 1 LAYOUT
010	T4010.DWG	1	WAGO & RELAY LAYOUT RACK 1, ROW A & B

					Designed By:	BPC	TTCI TTT HOUSE T-4 INDEX	Scale:	NTS
					Drawn By:	BPC		CADD File Name:	T4001.DWG
					Checked By:	BDW		Submitted Date:	03/11/15
					Approved By:	AEB			
1	03/11/15	AS DESIGNED							
REV	DATE	DESCRIPTION							Sheet No. 001



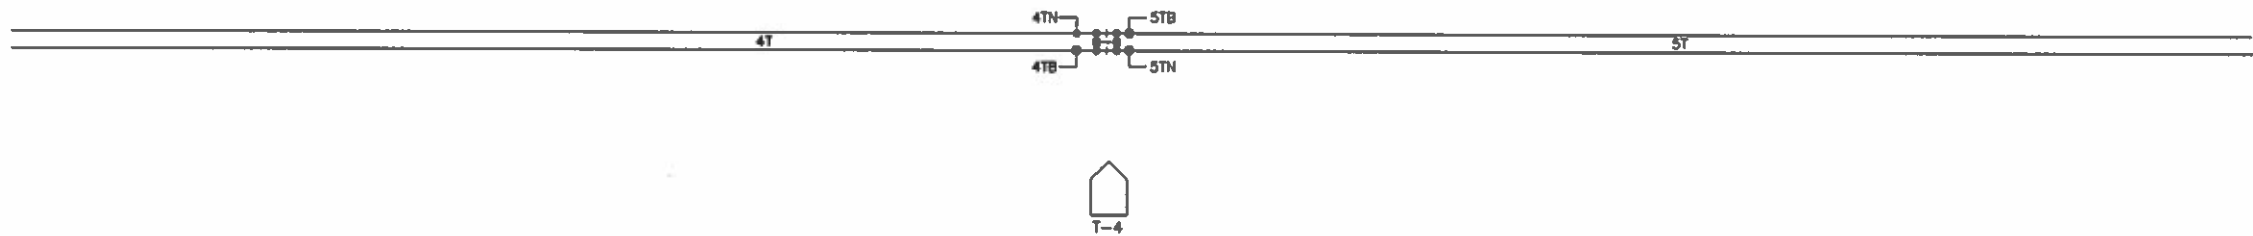



				Designed By:	BPC	TTCI TTT HOUSE T-4 TRACK & SIGNAL PLAN	Scale:	NTS	
				Drawn By:	BPC		CADD File Name:	T4002.DWG	
				Checked By:	BDW		Submitted Date:	03/11/15	
				Approved By:	AEB				
1	03/11/15	AS DESIGNED							
REV	DATE	DESCRIPTION						Sheet No.	002

CAB RATE	CODE	CODE
180	7	7
180	7	4
270	4	8
75	8	2
NO CAB	2	CW STICK
75	8	

CODE	CODE	CAB RATE
7	7	180
4	7	180
8	4	270
2	8	75
CW STICK	2	NO CAB
	8	75



TTT CAB RATE TABLE		
NAME	DESIGNATOR	RATE
CLEAR	C	180
CAB SPEED	CS	270
APPROACH LIMITED	AL?	120
APPROACH	A	75
RESTRICTING	R	NO CAB

					Designed By: BPC	TTCI TTT HOUSE T-4 CODE & ASPECT CHART	Scale: NTS
					Drawn By: BPC		CADD File Name: T4003.DWG
					Checked By: BDW		Submitted Date: 03/11/15
					Approved By: AEB		
1	03/11/15	AS DESIGNED					Sheet No. 003
REV	DATE	DESCRIPTION					

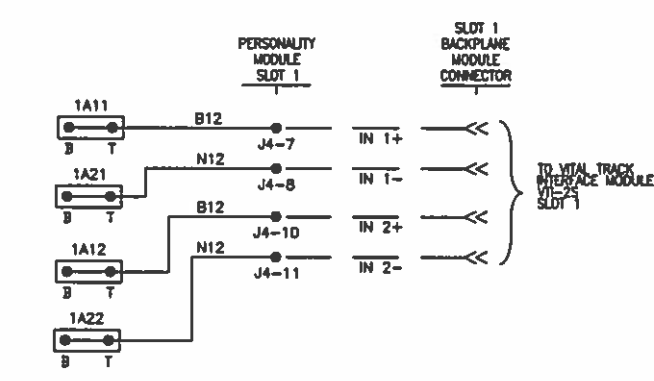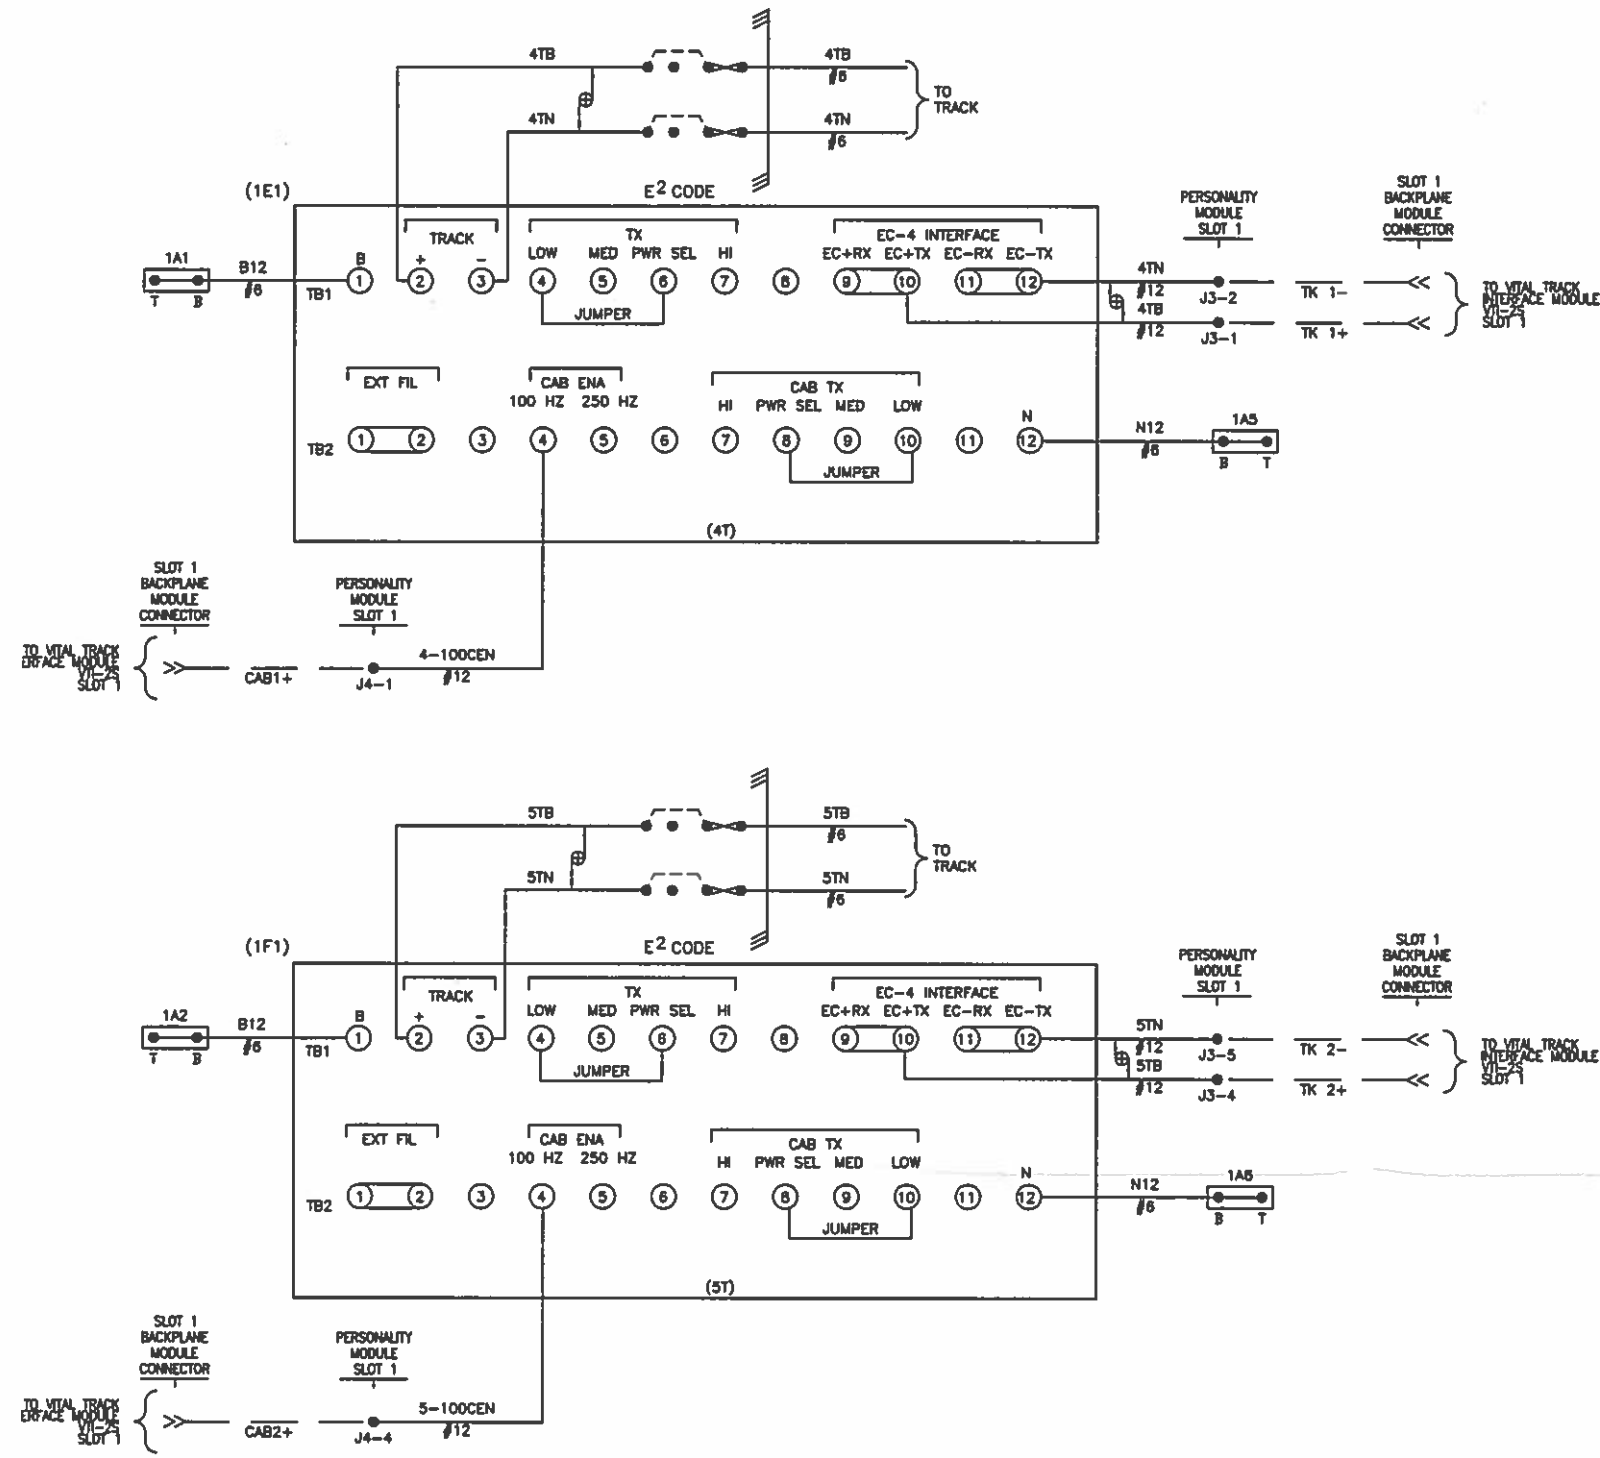

- NOTES:
- 1) ALL WIRING ON THIS SHEET TO BE #10 AWG UNLESS OTHERWISE NOTED.
 - 2) = TWISTED PAIR 2 TURNS PER FOOT.
 - 3) = INTERNAL CONNECTION

						Designed By:	BPC	TTCI	TTT HOUSE T-4	TRACK CIRCUITS	Scale:	NTS
						Drawn By:	BPC				CADD File Name:	T4004.DWG
						Checked By:	BDW				Submitted Date:	03/11/15
						Approved By:	AEB					
1	03/11/15	AS DESIGNED										
REV	DATE	DESCRIPTION										Sheet No. 004

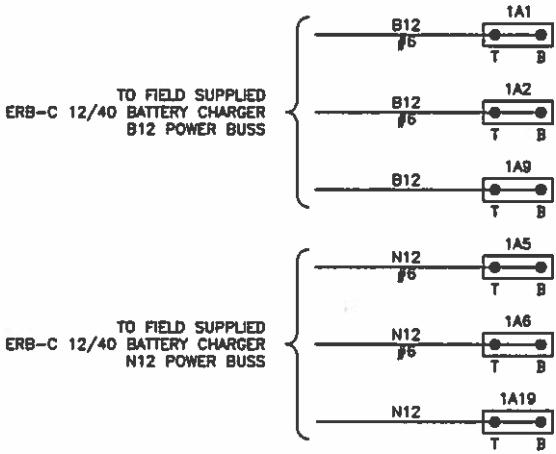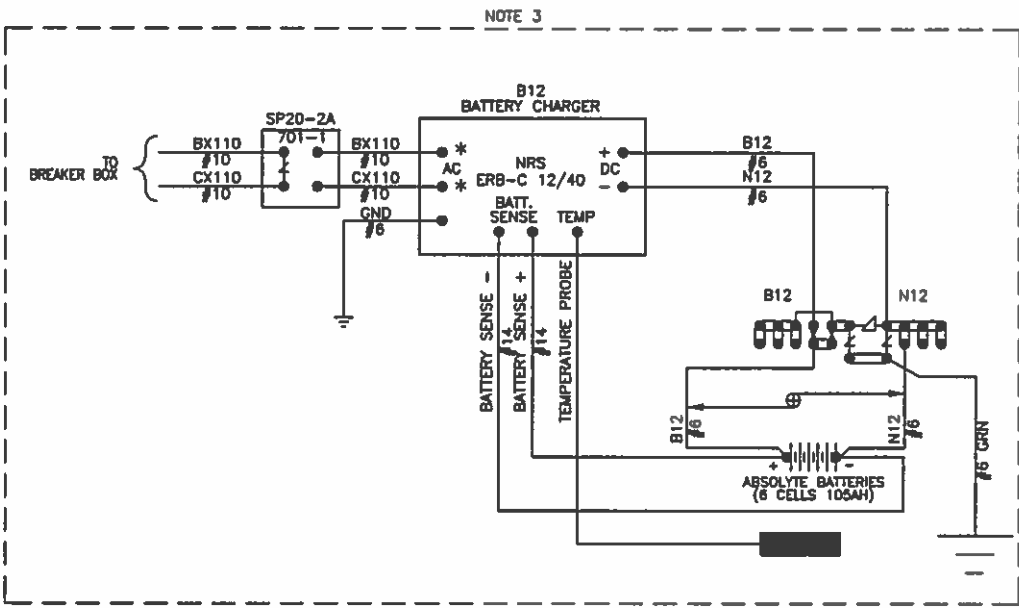

- NOTES:
- 1) ALL SIGNAL WIRING ON THIS SHEET TO BE #10 AWG UNLESS OTHERWISE NOTED.
 - 2) = TWISTED PAIR 2 TURNS PER FOOT.
 - 3) FIELD SUPPLIED

REV	DATE	DESCRIPTION
1	03/11/15	AS DESIGNED



Designed By:	BPC
Drawn By:	BPC
Checked By:	BDW
Approved By:	AEB

TTCI
TTT HOUSE T-4
POWER DISTRIBUTION CIRCUITS

Scale:	NTS
CADD File Name:	T4005.DWG
Submitted Date:	03/11/15
Sheet No.	005


VT-2S
PERSONALITY
MODULE
(SLOT 1)

TK 1+	4TB	X	1
TK 1-	4TN	X	2
			3
TK 2+	5TB	X	4
TK 2-	5TN	X	5
			6
			7

J3

CAB1+	4-100CEN	X	1
CAB1-			2
			3
CAB2+	5-100CEN	X	4
CAB2-			5
			6
IN 1+	B12	X	7
IN 1-	N12	X	8
			9
IN 2+	B12	X	10
IN 2-	N12	X	11






J4

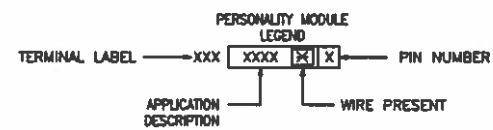

Designed By:	BPC	TTCI	Scale:	NTS
Drawn By:	BPC		CADD File Name:	T4006.DWG
Checked By:	BDW	TTT HOUSE T-4	Submitted Date:	03/11/15
Approved By:	AEB	ELECTROLOGIXS 4-SLOT MODULE CONNECTOR USAGE		Sheet No. 006

1	03/06/15	AS DESIGNED		
REV	DATE	DESCRIPTION		



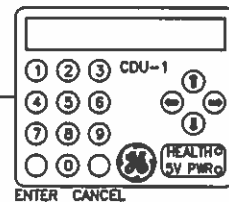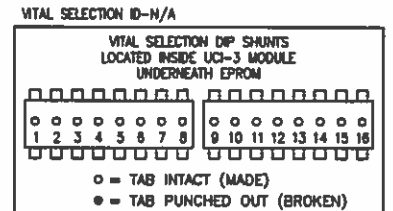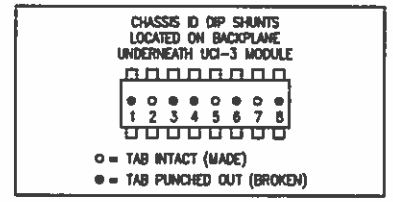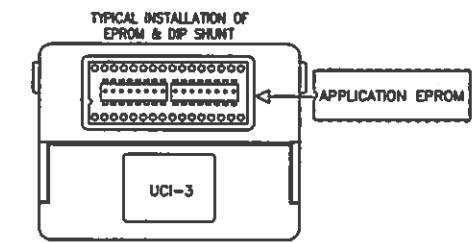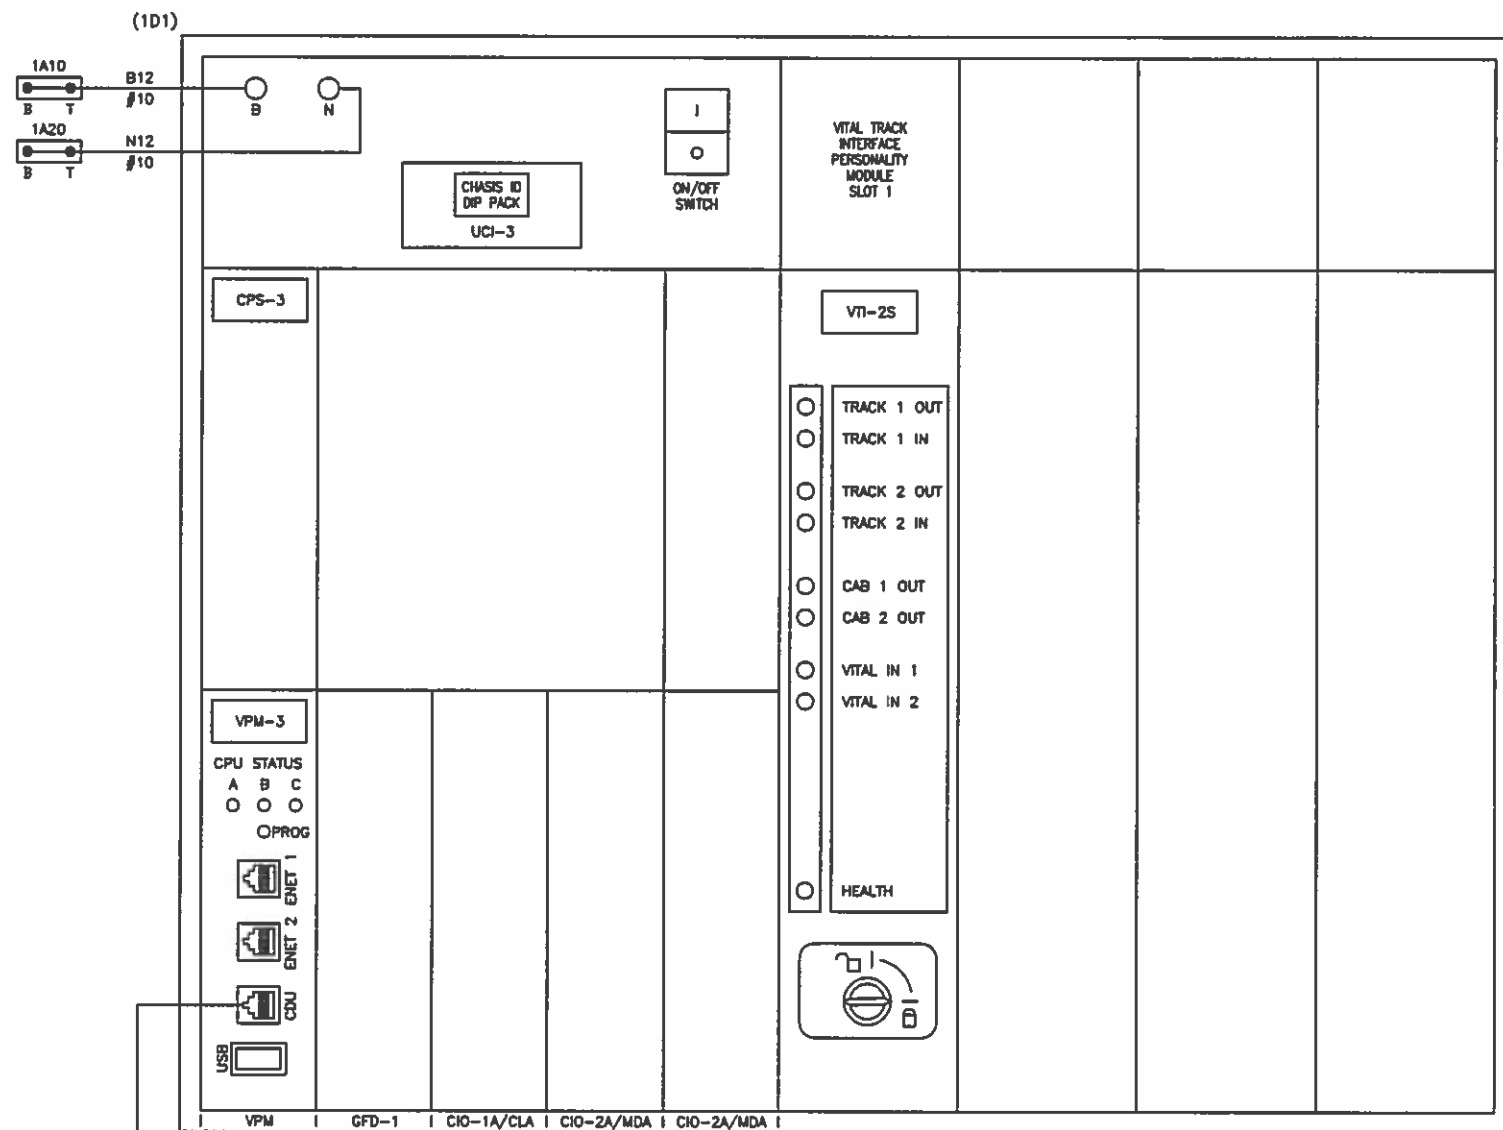


APPLICATION SOFTWARE INFORMATION	
NAME	
REV.	
CHECKSUM	
CRC	

- NOTES:
- CDU-1 = CONTROL DISPLAY UNIT
 - CPS-3 = CENTRAL POWER SUPPLY
 - VPM-3 = VITAL PERIPHERAL MASTER MODULE
 - UCI-3 = CHASSIS INFORMATION MODULE
 - VTI-2S = VITAL TRACK INTERFACE
 - VLD-R18S = VITAL LAMP DRIVER MODULE
 - VI0-86S = VITAL INPUTS/OUTPUTS
 - CIO-CLA = COMMUNICATION INPUT/OUTPUT CURRENT LOOP ADAPTER


SYSTEM CONFIGURATION				
DATE/TIME	SETTING MADE WHEN USING PTC CONFIGURATION			
DIAGNOSTIC PORT				
ETHERNET CONFIG.				
OFFICE CONFIG	NA			
LCP CONFIG	ENABLED	TRUE		
VITAL REMOTE CONFIG	LOCAL PORT	REMOTE PORT	REMOTE PORT CONFIG	
	ETHERNET PORT 1 192.168.40.74	NA	NA	NA
	ETHERNET PORT 2 192.168.1.12	NA	NA	NA
	SERIAL PORT 2	NA		
	SERIAL PORT 3	NA		
TRACK CONFIG	SLOT	TRACK	CONFIGURATION	
	SLOT 1: 4T_T11	1	TRANSMITTER	4V
			RECEIVER	0.5A
			CODE 5 TYPE	ALT 5
	SLOT 1: 5T_T11	2	TRANSMITTER	4V
			RECEIVER	0.5A
			CODE 5 TYPE	ALT 5

NOTES:
1. FINAL VITAL CONFIGURATION SETTINGS ARE SUBJECT TO CHANGE IN ACCORDANCE WITH SOFTWARE UPGRADES. FINAL VITAL CONFIGURATION SETTINGS TO BE UPDATED ON AS-IN-SERVICE.

				Designed By:	BPC	TTCI TTT HOUSE T-4 ELECTROLOGIXS 4-SLOT CONFIGURATION SETTINGS	Scale:	NTS
				Drawn By:	BPC		CADD File Name:	T4008.DWG
				Checked By:	BDW		Submitted Date:	03/11/15
				Approved By:	AEB			
							Sheet No.	008
1	03/11/15	AS DESIGNED						
REV	DATE	DESCRIPTION						

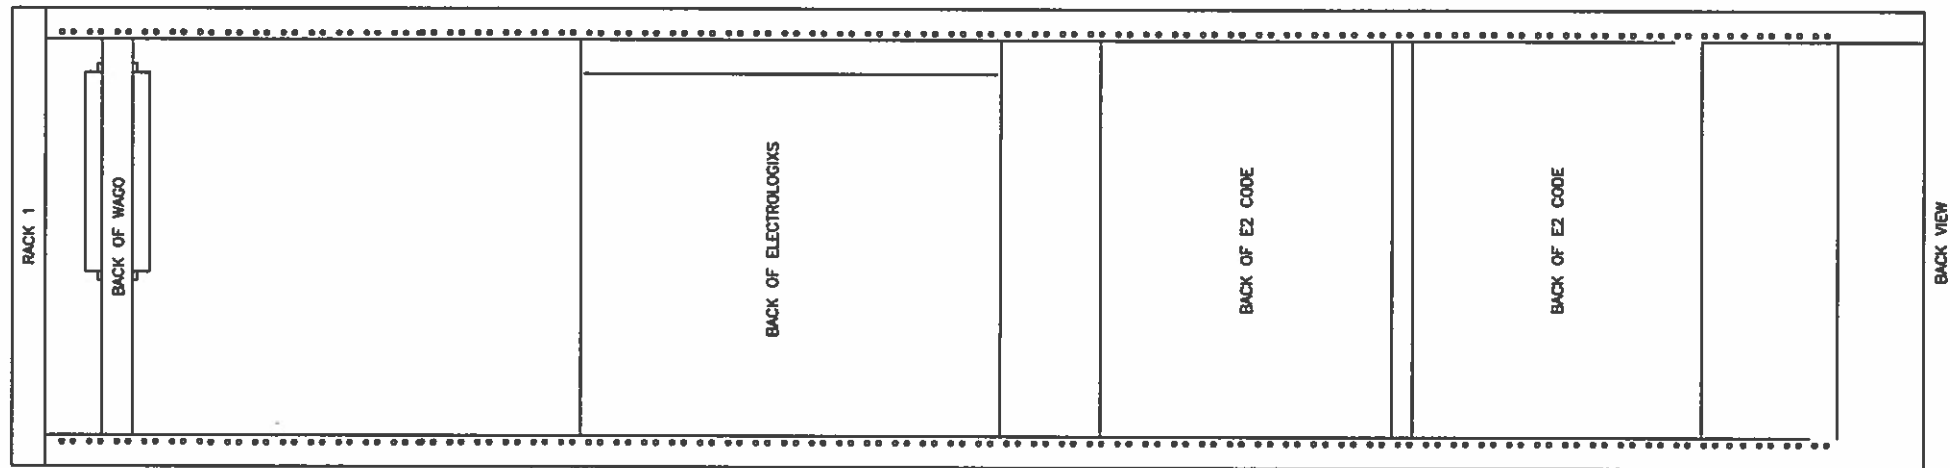

DD

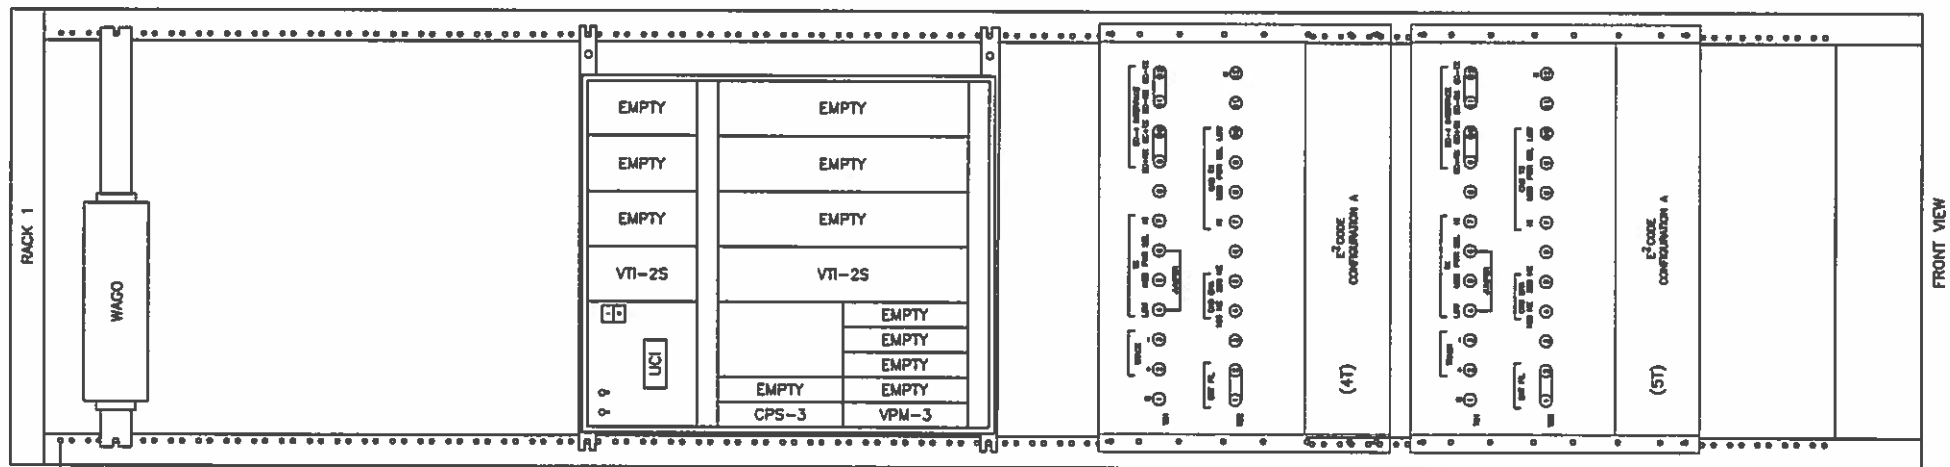

GRN
7/6

A

B

C

D


E

F

0 1 2 3 4 5 6 7 8 9 10 11 12

INCHES

				Designed By:	BPC	TTCI TTT HOUSE T-4 RACK 1 LAYOUT	Scale:	NTS	
				Drawn By:	BPC		CADD File Name:	T4009.DWG	
				Checked By:	BDW		Submitted Date:	03/11/15	
				Approved By:	AEB				
1	03/11/15	AS DESIGNED							
REV	DATE	DESCRIPTION							Sheet No.

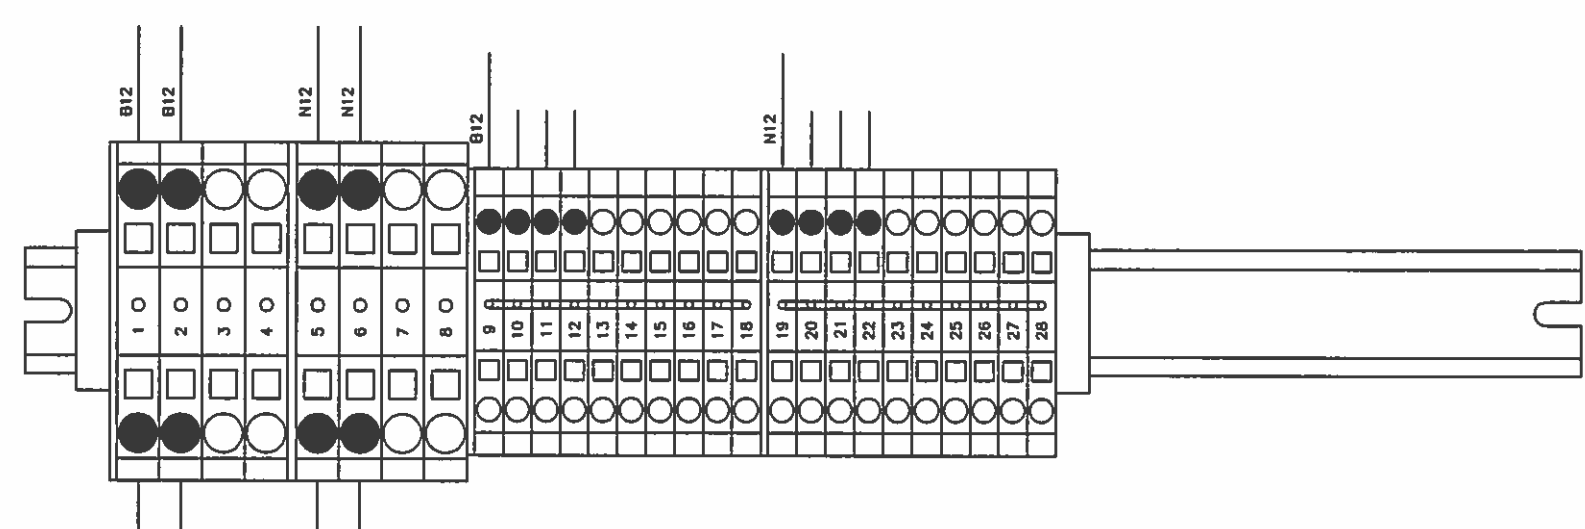[illegible]


HOUSE T-5

				Designed By:	BPC	TTCI TTT HOUSE T-5 COVER SHEET	Scale:	NTS	
				Drawn By:	BPC		CADD File Name:	T5000.DWG	
				Checked By:	BDW		Submitted Date:	03/11/15	
				Approved By:	AEB				
1	03/11/15	AS DESIGNED						Sheet No.	000
REV	DATE	DESCRIPTION							


INDEX OF DRAWINGS			
SHT. NO.	DWG. NO.	REV.	DESCRIPTION
000	T5000.DWG	1	COVER SHEET
001	T5001.DWG	1	INDEX
002	T5002.DWG	1	TRACK & SIGNAL PLAN
003	T5003.DWG	1	CODE & ASPECT CHART
004	T5004.DWG	1	TRACK CIRCUITS
005	T5005.DWG	1	POWER DISTRIBUTION CIRCUITS
006	T5006.DWG	1	ELECTROLOGIXS 4-SLOT MODULE CONNECTOR USAGE
007	T5007.DWG	1	ELECTROLOGIXS 4-SLOT HARDWARE CONFIGURATION
008	T5008.DWG	1	ELECTROLOGIXS 4-SLOT CONFIGURATION SETTINGS
009	T5009.DWG	1	RACK 1 LAYOUT
010	T5010.DWG	1	WAGO & RELAY LAYOUT RACK 1, ROW A & B

					Designed By:	BPC	TTCI	Scale:	NTS
					Drawn By:	BPC		CADD File Name:	T5001.DWG
					Checked By:	BDW	TTT HOUSE T-5	Submitted Date:	03/11/15
					Approved By:	AEB	INDEX		
									Sheet No.
									001
1	03/11/15	AS DESIGNED							
REV	DATE	DESCRIPTION							




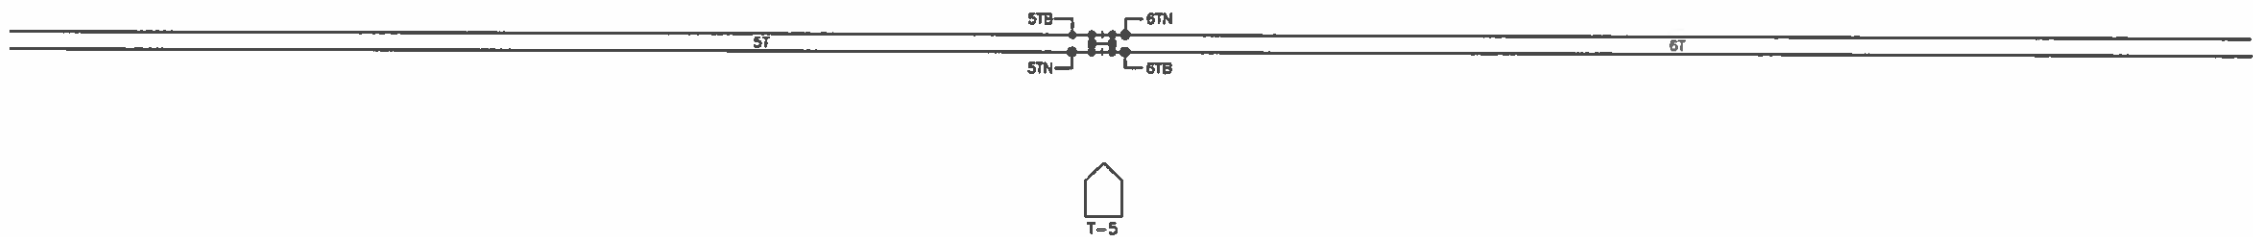


				Designed By:	BPC	TTCI TTT HOUSE T-5 TRACK & SIGNAL PLAN	Scale:	NTS
				Drawn By:	BPC		CADD File Name:	T5002.DWG
				Checked By:	BDW		Submitted Date:	03/11/15
				Approved By:	AEB			
1	03/11/15	AS DESIGNED						
REV	DATE	DESCRIPTION						Sheet No. 002

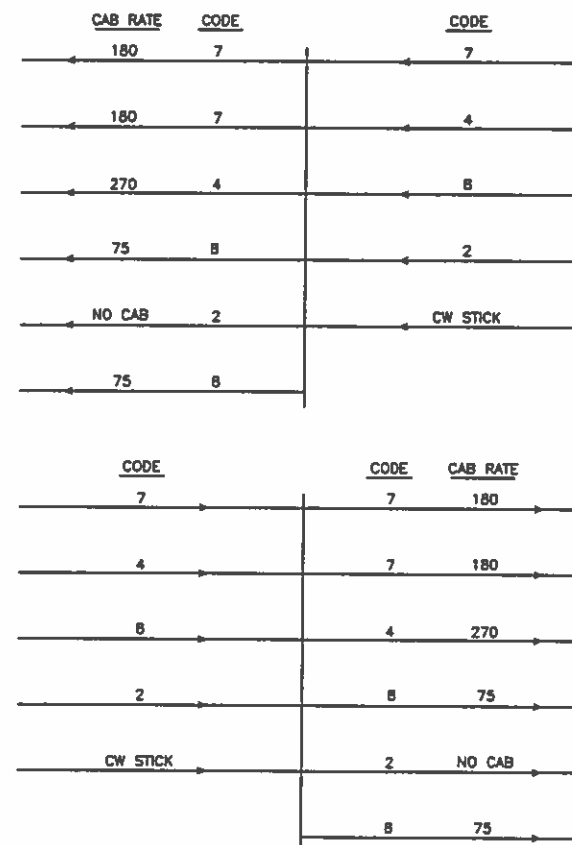



TTT CAB RATE TABLE		
NAME	DESIGNATOR	RATE
CLEAR	C	180
CAB SPEED	CS	270
APPROACH LIMITED	AL?	120
APPROACH	A	75
RESTRICTING	R	NO CAB

					Designed By: BPC	TTCI TTT HOUSE T-5 CODE & ASPECT CHART	Scale: NTS
				Drawn By: BPC	CADD File Name: T5003.DWG		
				Checked By: BDW	Submitted Date: 03/11/15		
				Approved By: AEB			
					Sheet No. 003		
1	03/11/15	AS DESIGNED					
REV	DATE	DESCRIPTION					

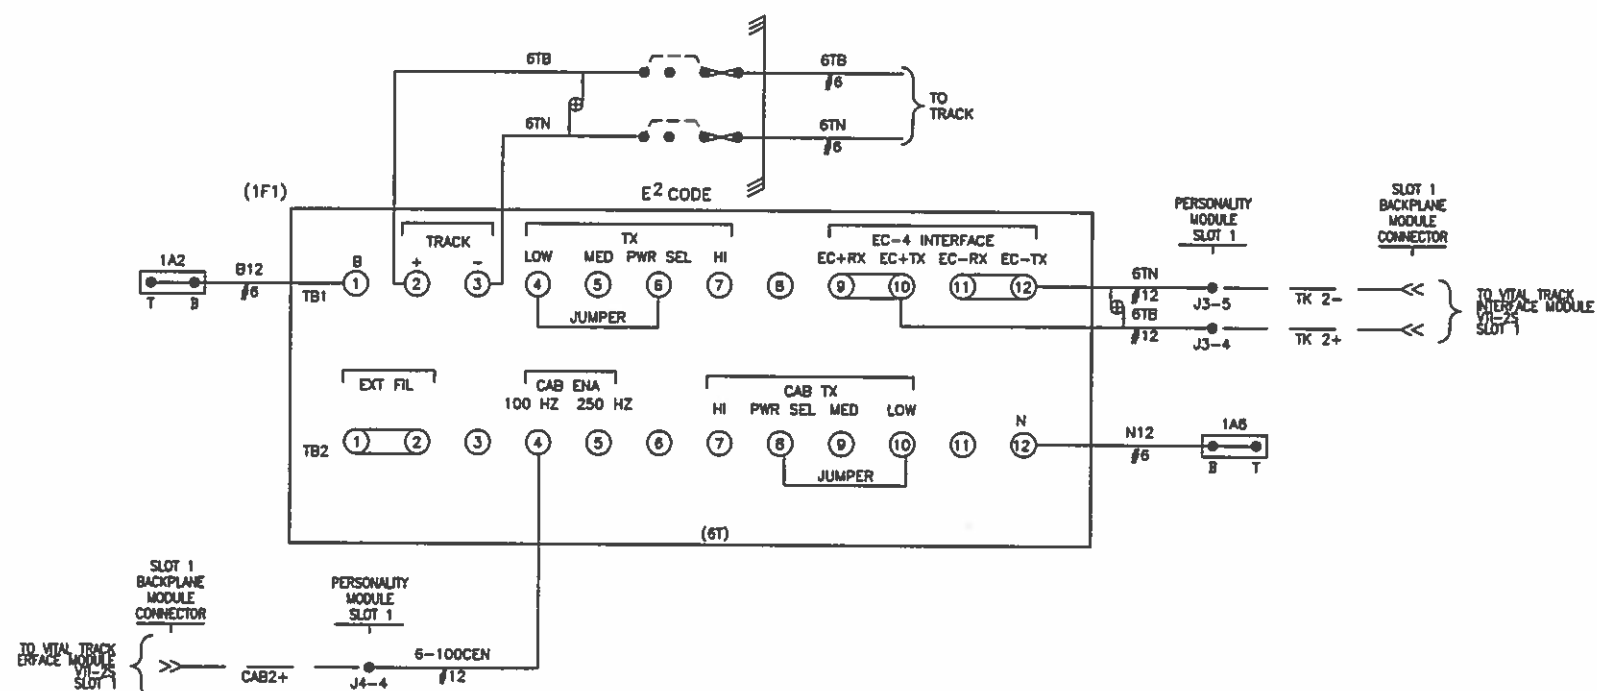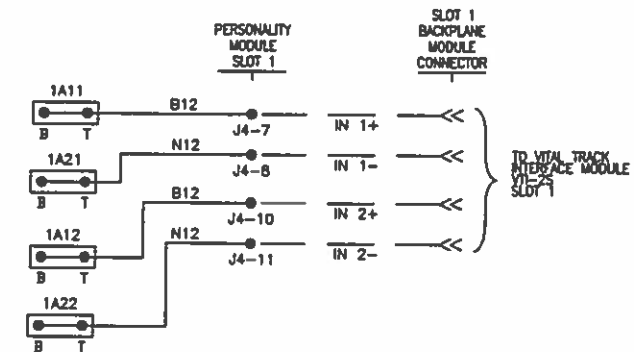

1) ALL WIRING ON THIS SHEET TO BE #10 AWG
UNLESS OTHERWISE NOTED.
2) = TWISTED PAIR 2 TURNS PER FOOT.
3)  = INTERNAL CONNECTION

[illegible]

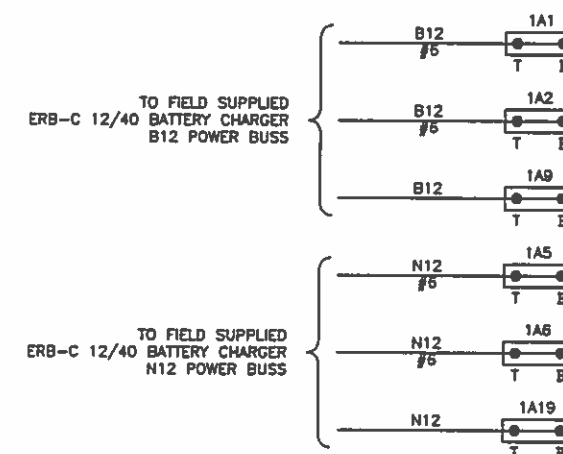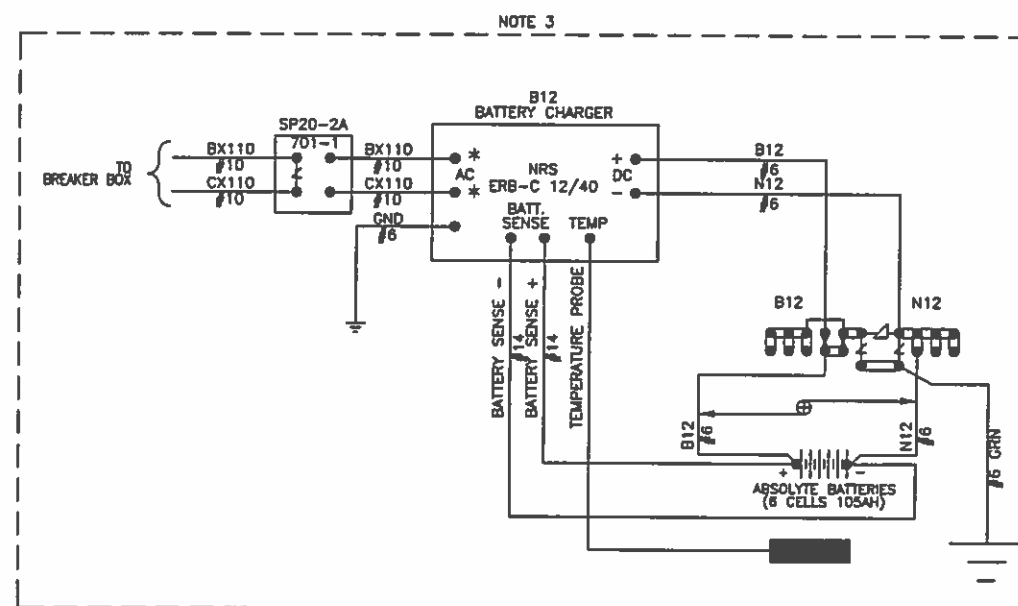

NOTES:

- 1) ALL SIGNAL WIRING ON THIS SHEET TO BE #10 AWG
UNLESS OTHERWISE NOTED.
- 2) = TWISTED PAIR 2 TURNS PER FOOT.
- 3) FIELD SUPPLIED

[illegible]


VR-25
PERSONALITY
MODULE
(SLOT 1)

TK 1+	5TB	X	1
TK 1-	5TN	X	2
			3
TK 2+	6TB	X	4
TK 2-	6TN	X	5
			6
			7

J3






CAB1+	5-100CEN	X	1
CAB1-			2
			3
CAB2+	6-100CEN	X	4
CAB2-			5
			6
IN 1+	B12	X	7
IN 1-	N12	X	8
			9
IN 2+	B12	X	10
IN 2-	N12	X	11

J4

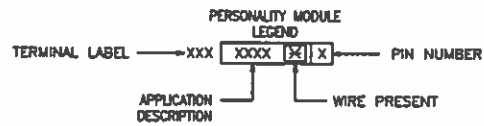

					Designed By:	BPC	TTCI	Scale:	NTS
					Drawn By:	BPC		CADD File Name:	T5006.DWG
					Checked By:	BDW	TTT HOUSE T-5	Submitted Date:	03/11/15
					Approved By:	AEB	ELECTROLOGIXS 4-SLOT MODULE CONNECTOR USAGE		Sheet No. 006
1	03/06/15	AS DESIGNED							
REV	DATE	DESCRIPTION							



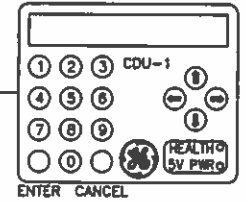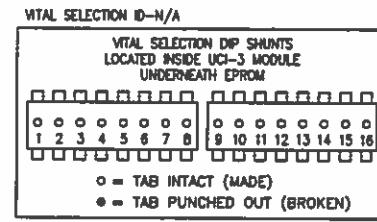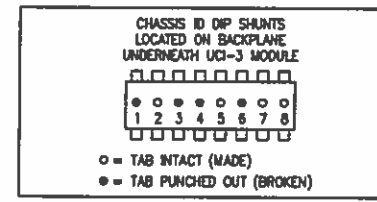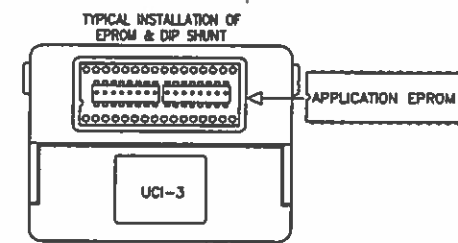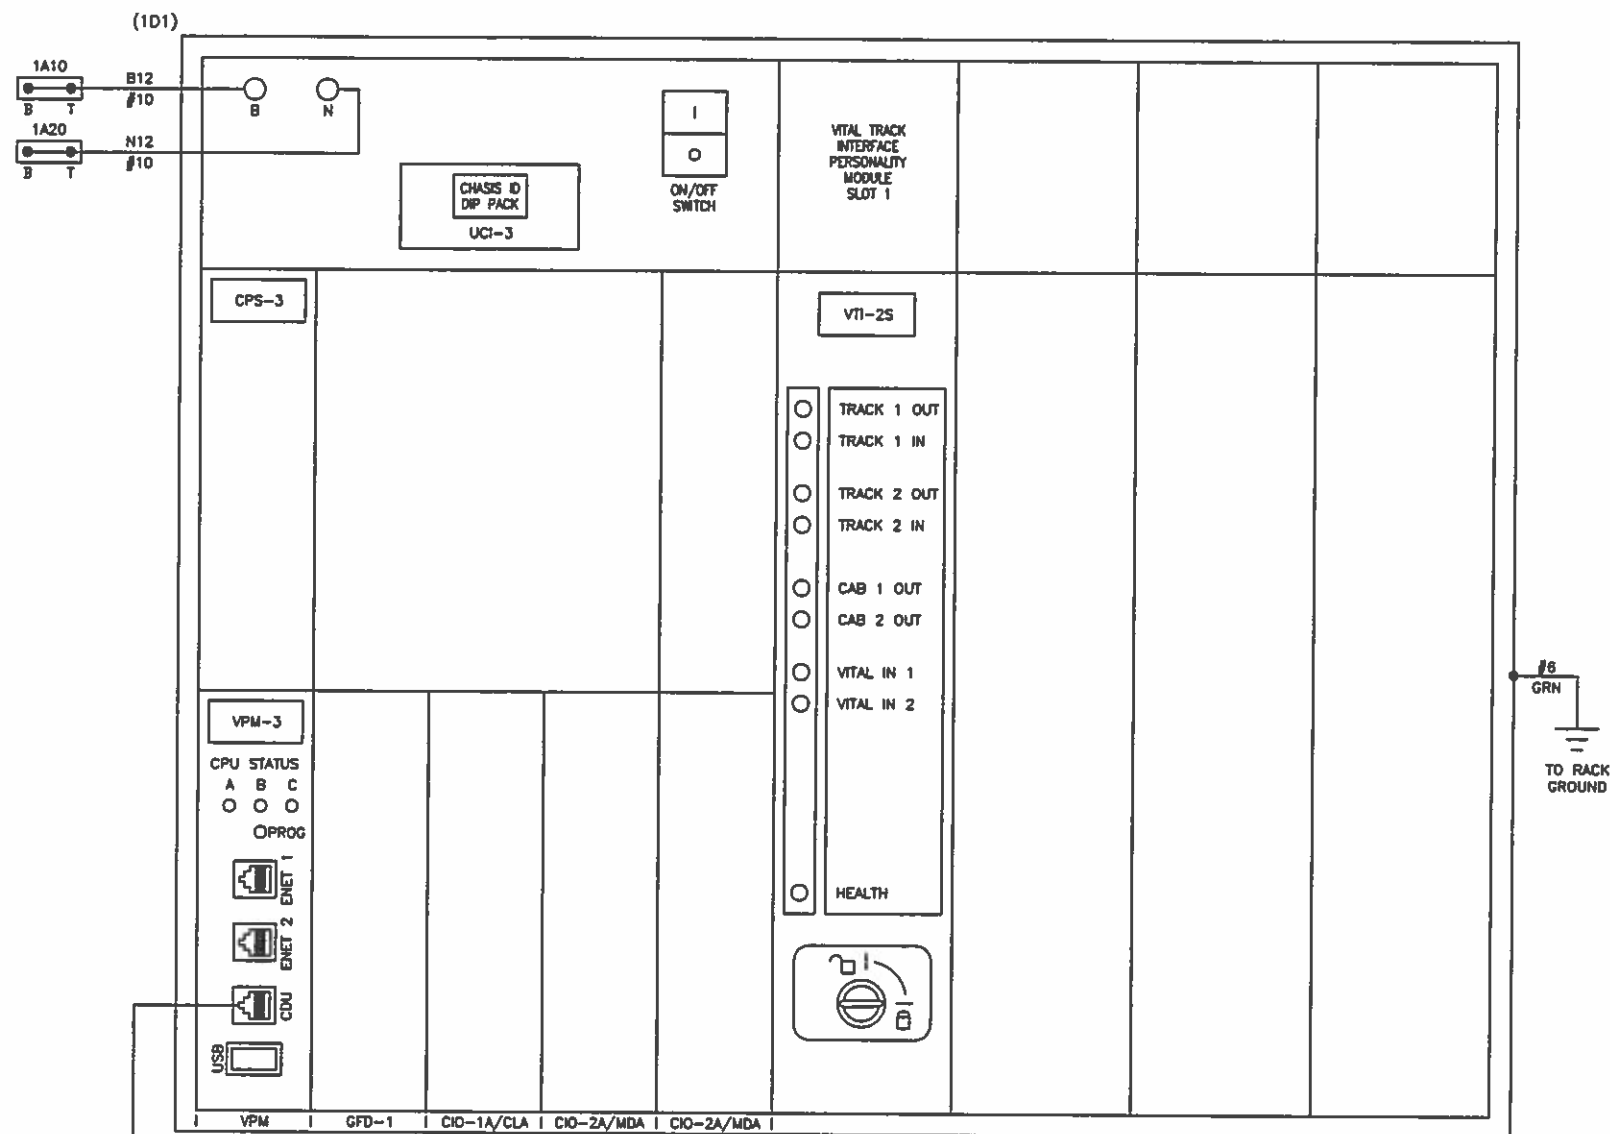


APPLICATION SOFTWARE INFORMATION	
NAME	
REV.	
CHECKSUM	
CRC	

- NOTES:
- CDU-1 = CONTROL DISPLAY UNIT
 - CPS-3 = CENTRAL POWER SUPPLY
 - VPM-3 = VITAL PERIPHERAL MASTER MODULE
 - UCI-3 = CHASSIS INFORMATION MODULE
 - VTI-2S = VITAL TRACK INTERFACE
 - VLD-R16S = VITAL LAMP DRIVER MODULE
 - VIO-B6S = VITAL INPUTS/OUTPUTS
 - CIO-CLA = COMMUNICATION INPUT/OUTPUT CURRENT LOOP ADAPTER

SYSTEM CONFIGURATION				
DATE/TIME	SETTING MADE WHEN USING PTC CONFIGURATION			
DIAGNOSTIC PORT				
ETHERNET CONFIG.				
OFFICE CONFIG	NA			
LCP CONFIG	ENABLED	TRUE		
VITAL REMOTE CONFIG	LOCAL PORT	REMOTE PORT	REMOTE PORT CONFIG	
	ETHERNET PORT 1 192.168.40.75	NA	NA	NA
	ETHERNET PORT 2 192.168.1.12	NA	NA	NA
	SERIAL PORT 2	NA		
	SERIAL PORT 3	NA		
TRACK CONFIG	SLOT	TRACK	CONFIGURATION	
	SLOT 1: 5T_T11	1	TRANSMITTER	4V
			RECEIVER	0.5A
			CODE 5 TYPE	ALT 5
	SLOT 1: 6T_T11	2	TRANSMITTER	4V
			RECEIVER	0.5A
			CODE 5 TYPE	ALT 5

NOTES:
1. FINAL VITAL CONFIGURATION SETTINGS ARE SUBJECT TO CHANGE IN ACCORDANCE WITH SOFTWARE UPGRADES. FINAL VITAL CONFIGURATION SETTINGS TO BE UPDATED ON AS-IN-SERVICE.

					Designed By: BPC	TTCI TTT HOUSE T-5 ELECTROLOGIXS 4-SLOT CONFIGURATION SETTINGS	Scale: NTS
					Drawn By: BPC		CADD File Name: T5008.DWG
					Checked By: BDW		Submitted Date: 03/11/15
					Approved By: AEB		
							Sheet No. 008
1	03/11/15	AS DESIGNED					
REV	DATE	DESCRIPTION					

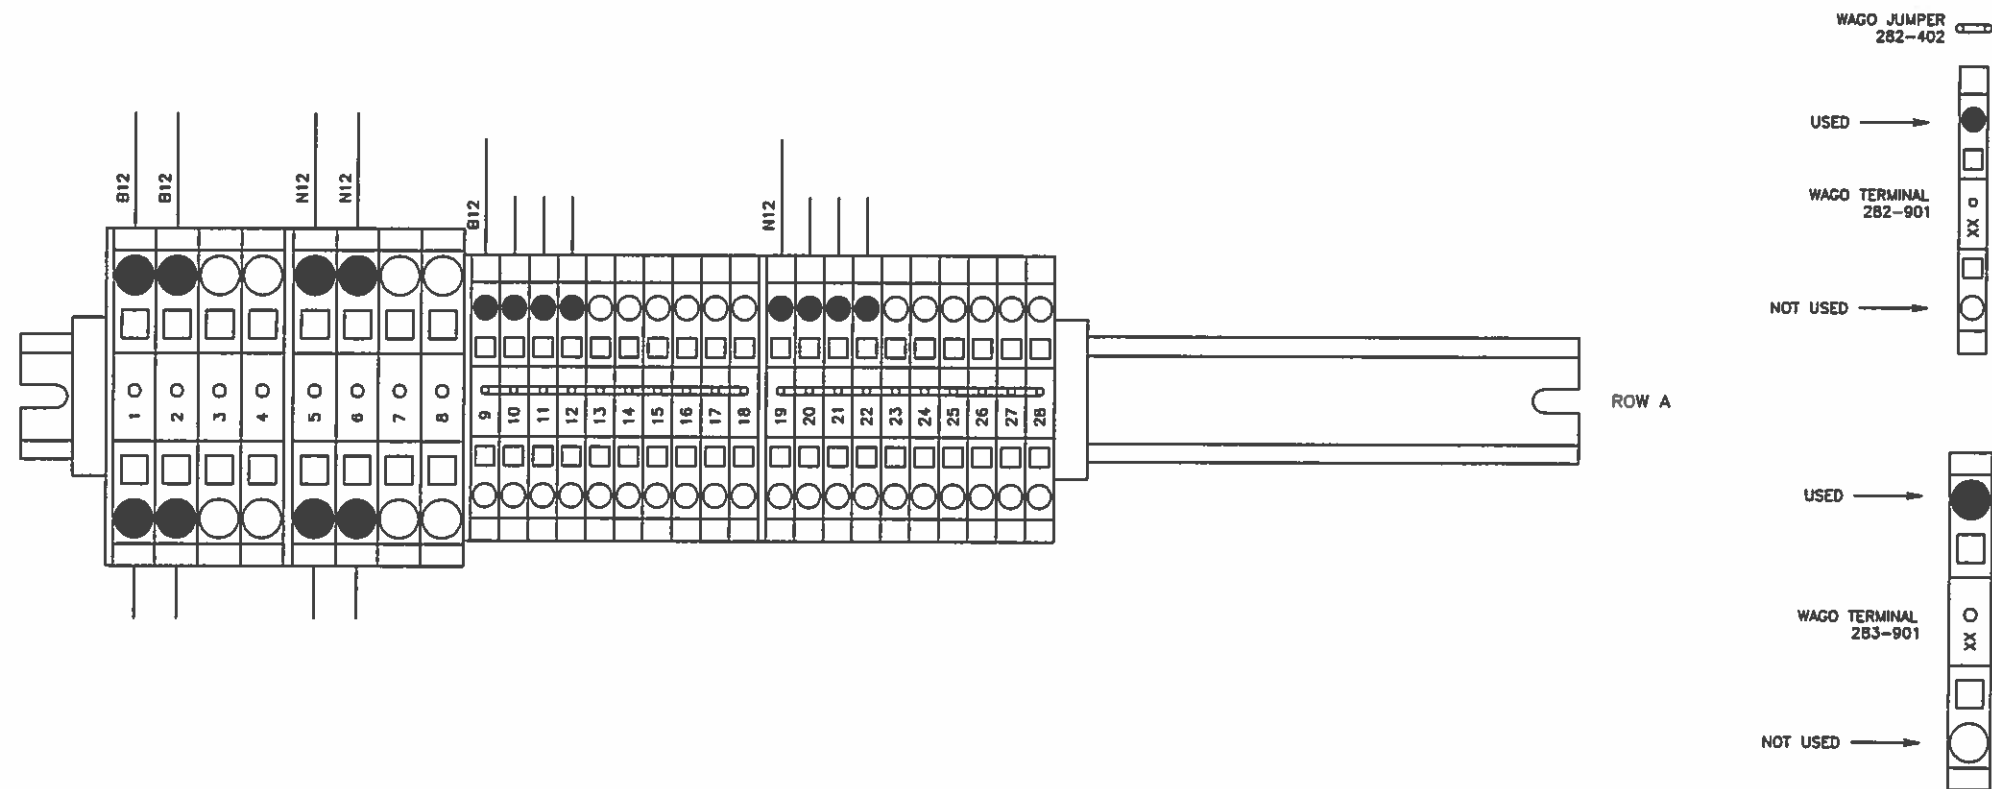


--	--	
HOUSE T-R



					Designed By:	BPC	TTCI	Scale:	NTS
					Drawn By:	BPC		CADD File Name:	TR000.DWG
					Checked By:	BDW		Submitted Date:	03/11/15
					Approved By:	AEB			Sheet No.
1	03/11/15	AS DESIGNED					COVER SHEET		000
REV	DATE	DESCRIPTION							

INDEX OF DRAWINGS			
SHT. NO.	DWG. NO.	REV.	DESCRIPTION
000	TR000.DWG	1	COVER SHEET
001	TR001.DWG	1	INDEX
002	TR002.DWG	1	TRACK & SIGNAL PLAN
003	TR003.DWG	1	CODE & ASPECT CHART
004	TR004.DWG	1	TRACK CIRCUITS
005	TR005.DWG	1	POWER DISTRIBUTION CIRCUITS
006	TR006.DWG	1	ELECTROLOGIXS 4-SLOT MODULE CONNECTOR USAGE
007	TR007.DWG	1	ELECTROLOGIXS 4-SLOT HARDWARE CONFIGURATION
008	TR008.DWG	1	ELECTROLOGIXS 4-SLOT CONFIGURATION SETTINGS
009	TR009.DWG	1	RACK 1 LAYOUT
010	TR010.DWG	1	WAGO & RELAY LAYOUT RACK 1, ROW A & B

					Designed By: BPC	TTCI TTT HOUSE T-R INDEX	Scale NTS
					Drawn By: BPC		CADD File Name: TR001.DWG
					Checked By: BDW		Submitted Date: 03/11/15
					Approved By: AEB		Sheet No. 001
1	03/11/15	AS DESIGNED					
REV	DATE	DESCRIPTION					


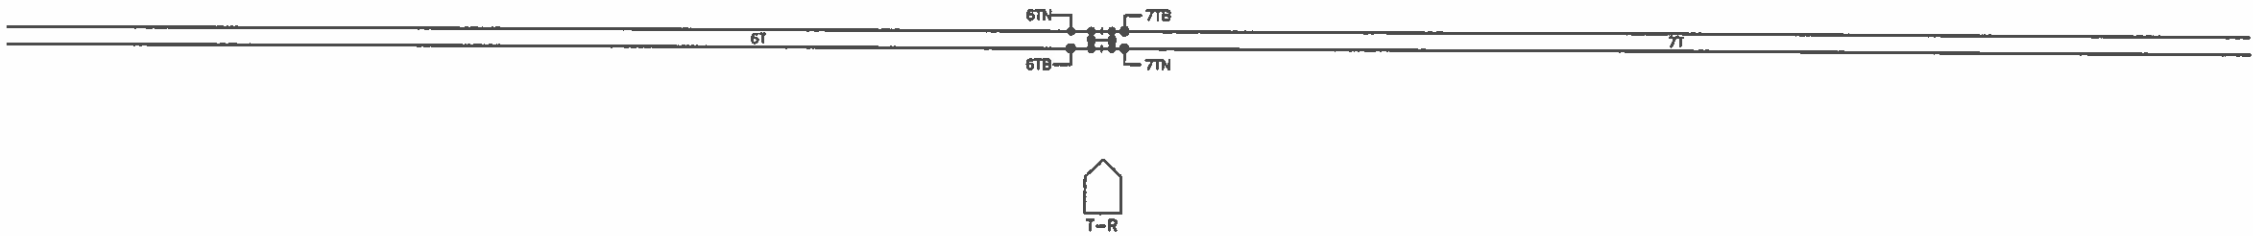


				Designed By:	BPC	TTCI TTT HOUSE T-R TRACK & SIGNAL PLAN	Scale:	NTS
				Drawn By:	BPC		CADD File Name:	TR002.DWG
				Checked By:	BDW		Submitted Date:	03/11/15
				Approved By:	AEB			Sheet No.
								002
1	03/11/15	AS DESIGNED						
REV	DATE	DESCRIPTION						

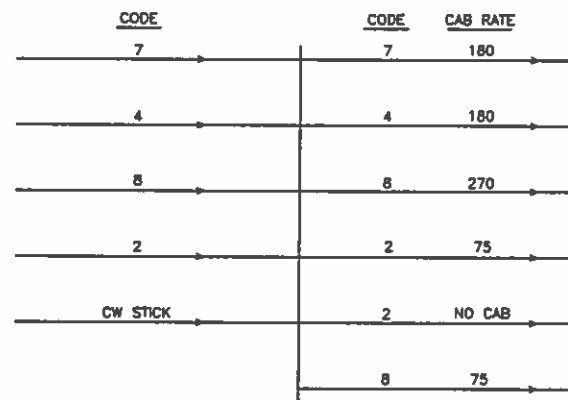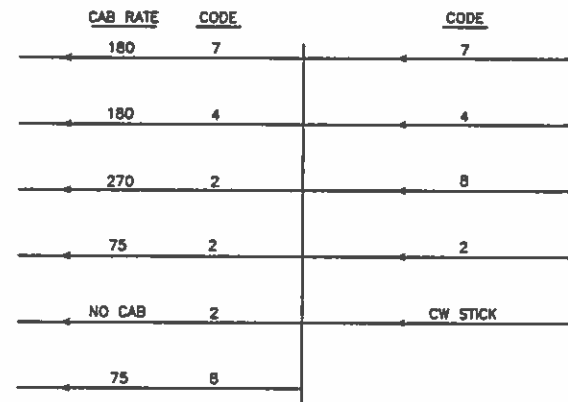

TTT CAB RATE TABLE		
NAME	DESIGNATOR	RATE
CLEAR	C	180
CAB SPEED	CS	270
APPROACH LIMITED	AL?	120
APPROACH	A	75
RESTRICTING	R	NO CAB

					Designed By: BPC	TTCI TTT HOUSE T-R CODE & ASPECT CHART	Scale: NTS
				Drawn By: BPC	CADD File Name: TR003.DWG		
				Checked By: BDW	Submitted Date: 03/11/15		
				Approved By: AEB			
1	03/11/15	AS DESIGNED					
REV	DATE	DESCRIPTION					Sheet No. 003

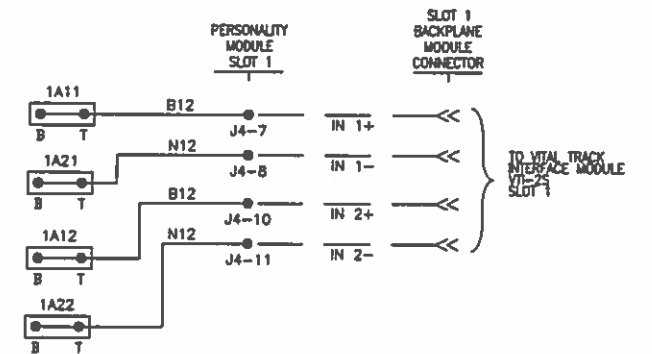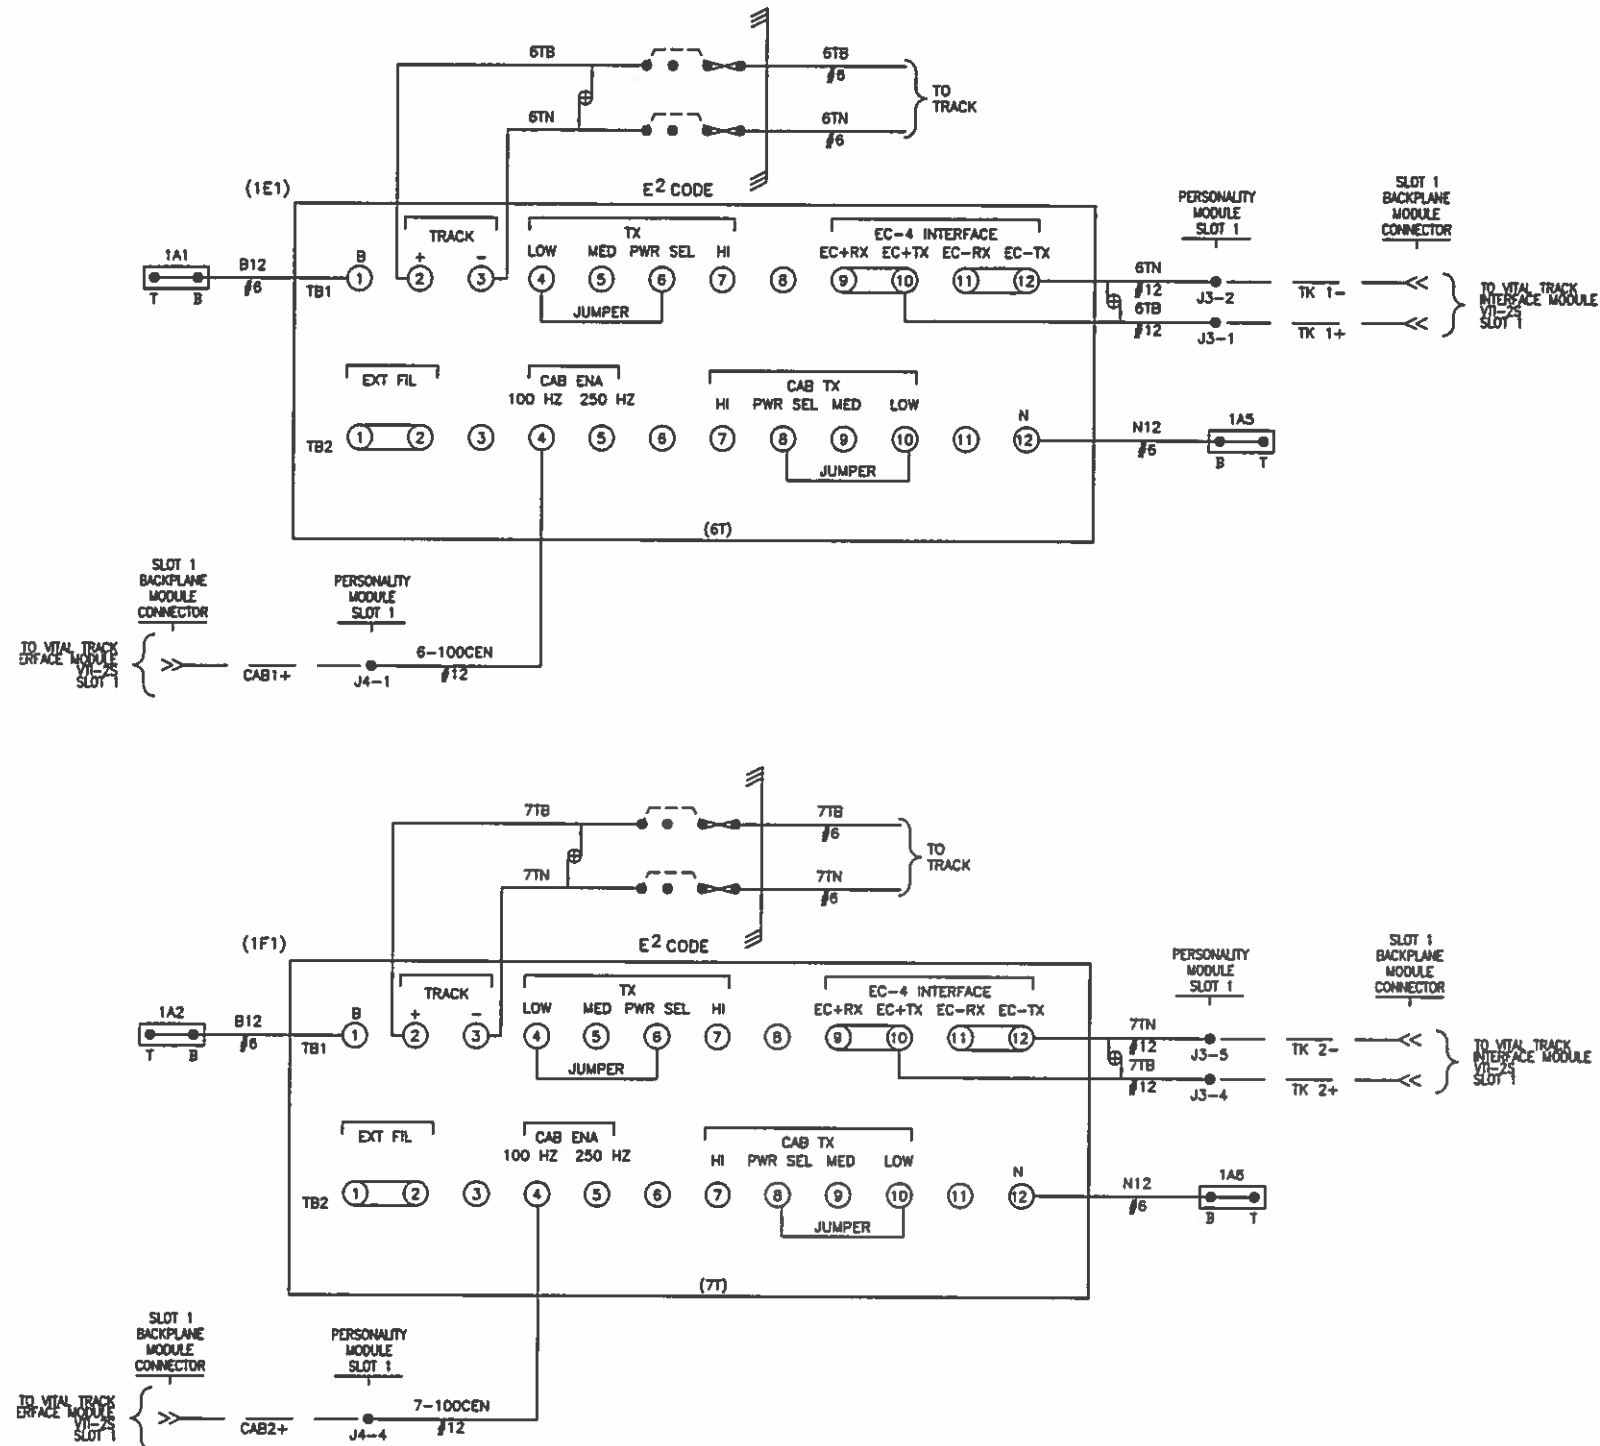

NOTES:

- 1) ALL WIRING ON THIS SHEET TO BE #10 AWG UNLESS OTHERWISE NOTED.
- 2) = TWISTED PAIR 2 TURNS PER FOOT.
- 3) ----- = INTERNAL CONNECTION



REV	DATE	DESCRIPTION
1	03/11/15	AS DESIGNED



Designed By:	BPC
Drawn By:	BPC
Checked By:	BDW
Approved By:	AEB

TTCI
TTT HOUSE T-R
TRACK CIRCUITS

Scale:	NTS
CADD File Name:	TR004.DWG
Submitted Date:	03/11/15
Sheet No.:	004

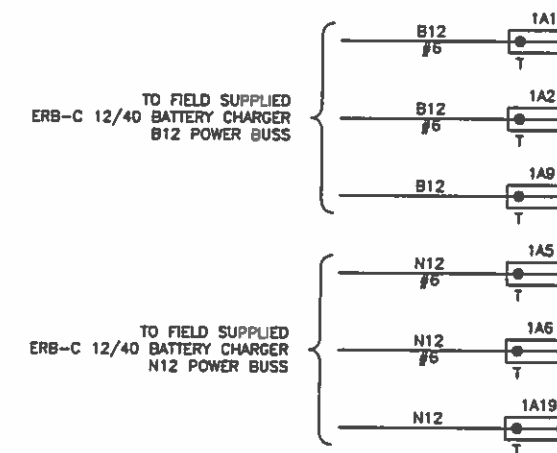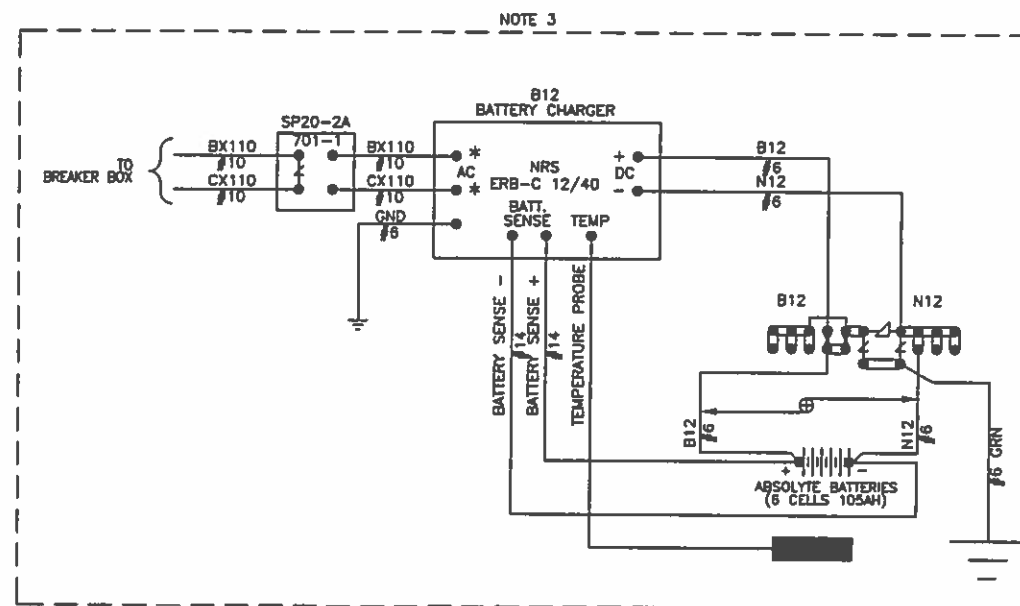

NOTES:

- 1) ALL SIGNAL WIRING ON THIS SHEET TO BE #10 AWG UNLESS OTHERWISE NOTED.
- 2) TW = TWISTED PAIR 2 TURNS PER FOOT.
- 3) FIELD SUPPLIED

--	--	

VR-2S
PERSONALITY
MODULE
(SLOT 1)

TK 1+	6TB	X	1
TK 1-	6TN	X	2
			3
TK 2+	7TB	X	4
TK 2-	7TN	X	5
			6
			7

J3





CAB1+	6-100CEN	X	1
CAB1-			2
			3
CAB2+	7-100CEN	X	4
CAB2-			5
			6
IN 1+	B12	X	7
IN 1-	N12	X	8
			9
IN 2+	B12	X	10
IN 2-	N12	X	11

J4

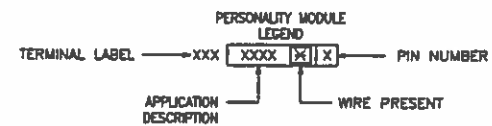

					Designed By: BPC	TTCI	Scale: NTS
					Drawn By: BPC		CADD File Name: TR006.DWG
					Checked By: BDW	TIT HOUSE T-R	Submitted Date: 03/11/15
					Approved By: AEB	ELECTROLOGIXS 4-SLOT MODULE CONNECTOR USAGE	Sheet No. 006
1	03/06/15	AS DESIGNED					
REV	DATE	DESCRIPTION					



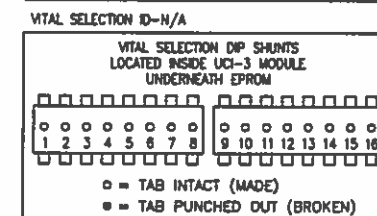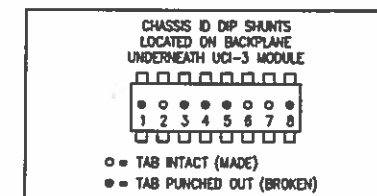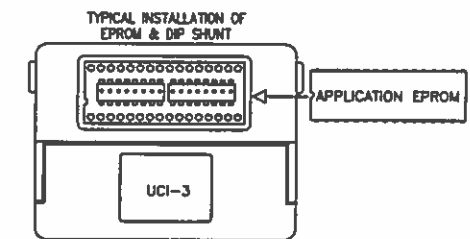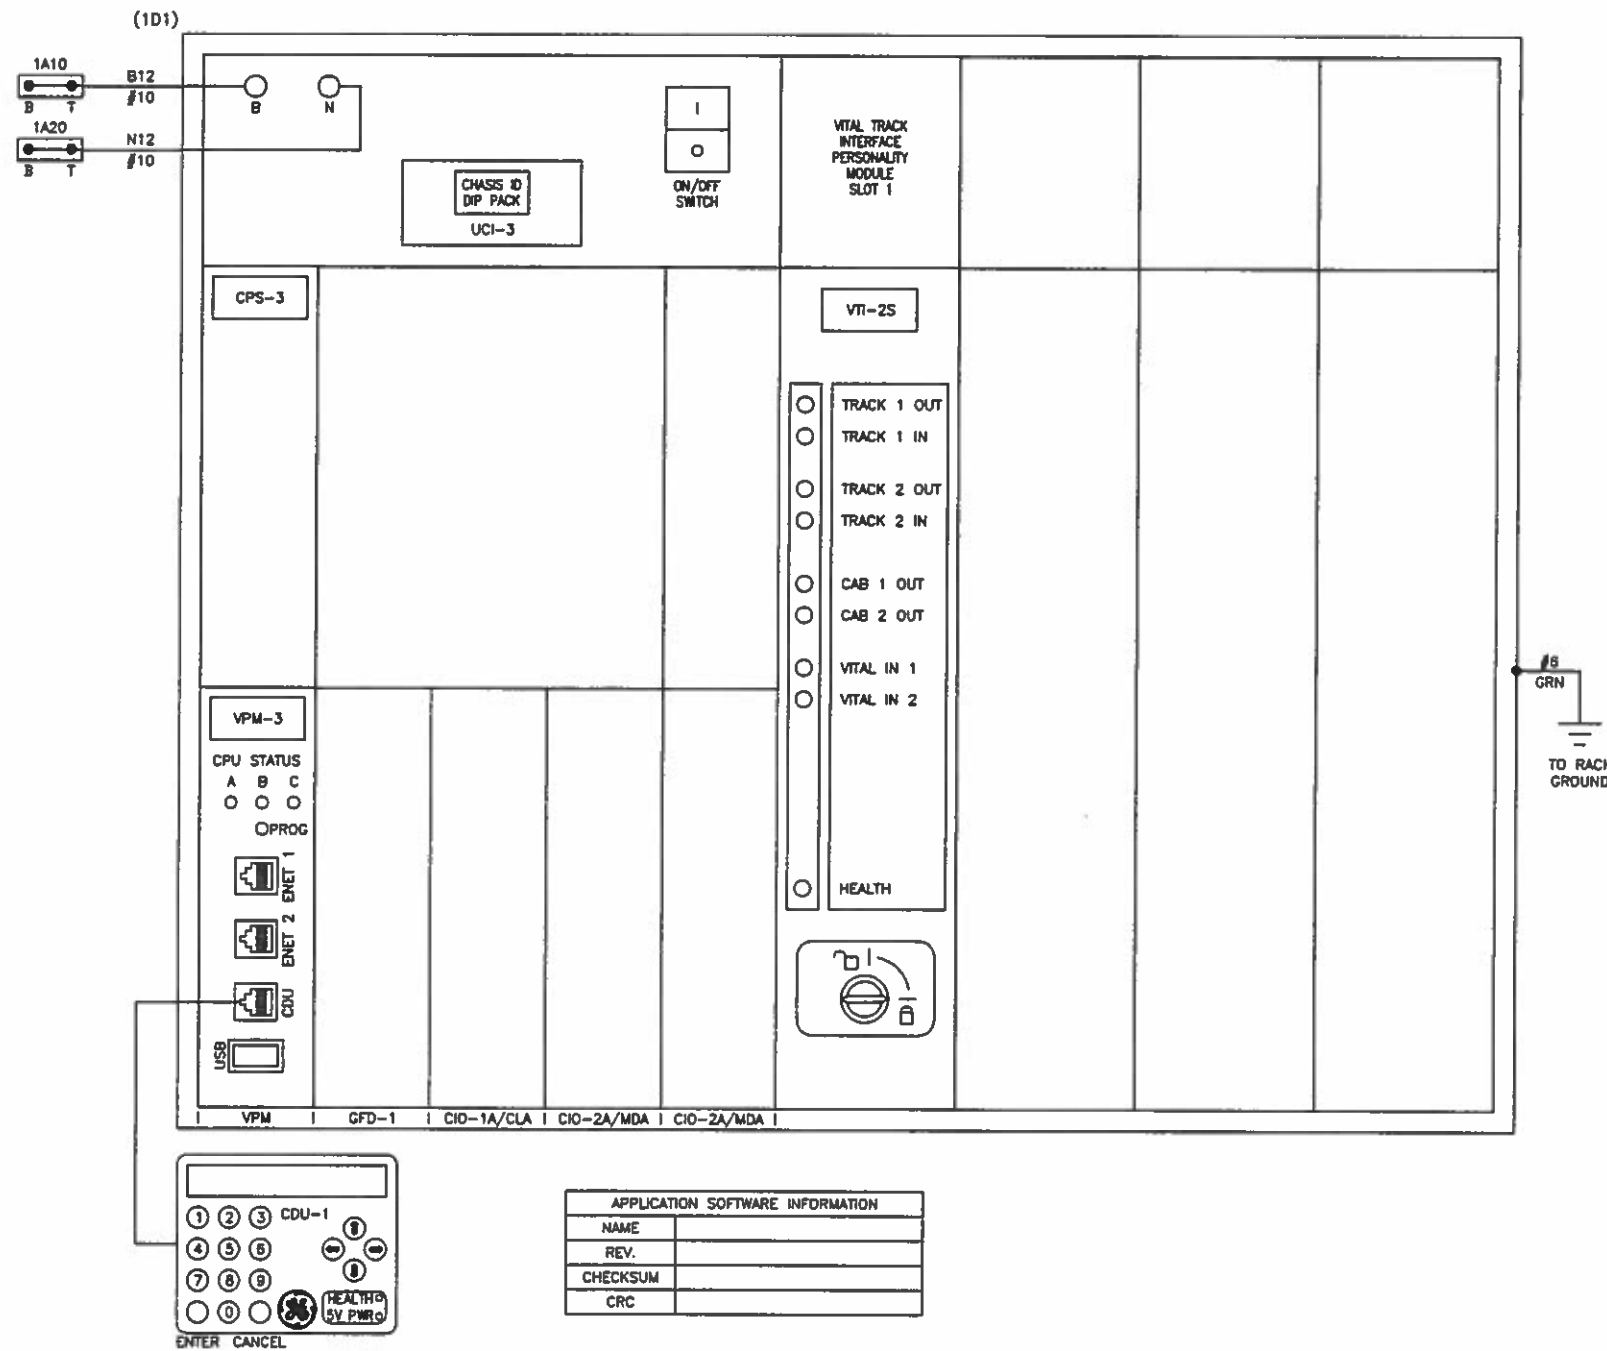

NOTES:

CDU-1 = CONTROL DISPLAY UNIT
CPS-3 = CENTRAL POWER SUPPLY
VPM-3 = VITAL PERIPHERAL MASTER MODULE
UCI-3 = CHASSIS INFORMATION MODULE
VTI-2S = VITAL TRACK INTERFACE
VLD-R16S = VITAL LAMP DRIVER MODULE
VIO-B6S = VITAL INPUTS/OUTPUTS
CIO-CLA = COMMUNICATION INPUT/OUTPUT CURRENT LOOP ADAPTER

1	03/11/15	AS DESIGNED
REV	DATE	DESCRIPTION

GETS
Global Signaling

Designed By: BPC
Drawn By: BPC
Checked By: BDW
Approved By: AEB


TTTI
TTT HOUSE T-R
ELECTROLOGIXS 4-SLOT
HARDWARE CONFIGURATION

Scale: NTS
CADD File Name: TR007.DWG
Submitted Date: 03/11/15
Sheet No. 007


SYSTEM CONFIGURATION				
DATE/TIME	SETTING MADE WHEN USING PTC CONFIGURATION			
DIAGNOSTIC PORT				
ETHERNET CONFIG.				
OFFICE CONFIG	NA			
LCP CONFIG	ENABLED	TRUE		
VITAL REMOTE CONFIG	LOCAL PORT	REMOTE PORT	REMOTE PORT CONFIG	
	ETHERNET PORT 1 192.168.40.70	NA	NA	NA
	ETHERNET PORT 2 192.168.1.12	NA	NA	NA
	SERIAL PORT 2	NA		
	SERIAL PORT 3	NA		
TRACK CONFIG	SLOT	TRACK	CONFIGURATION	
	SLOT 1: 6T_711	1	TRANSMITTER	4V
			RECEIVER	0.5A
			CODE 5 TYPE	ALT 5
	SLOT 1: 7T_711	2	TRANSMITTER	4V
			RECEIVER	0.5A
			CODE 5 TYPE	ALT 5

NOTES:
1. FINAL VITAL CONFIGURATION SETTINGS ARE SUBJECT TO CHANGE IN ACCORDANCE WITH SOFTWARE UPGRADES. FINAL VITAL CONFIGURATION SETTINGS TO BE UPDATED ON AS-IN-SERVICE.

					Designed By:	BPC	TTCI	Sealer	NTS
					Drawn By:	BPC		CADD File Name:	TR008.DWG
					Checked By:	BDW		Submitted Date:	03/11/15
					Approved By:	AEB			
1	03/11/15	AS DESIGNED					TTT HOUSE T-R		
REV	DATE	DESCRIPTION					ELECTROLOGIXS 4-SLOT CONFIGURATION SETTINGS		Sheet No. 008

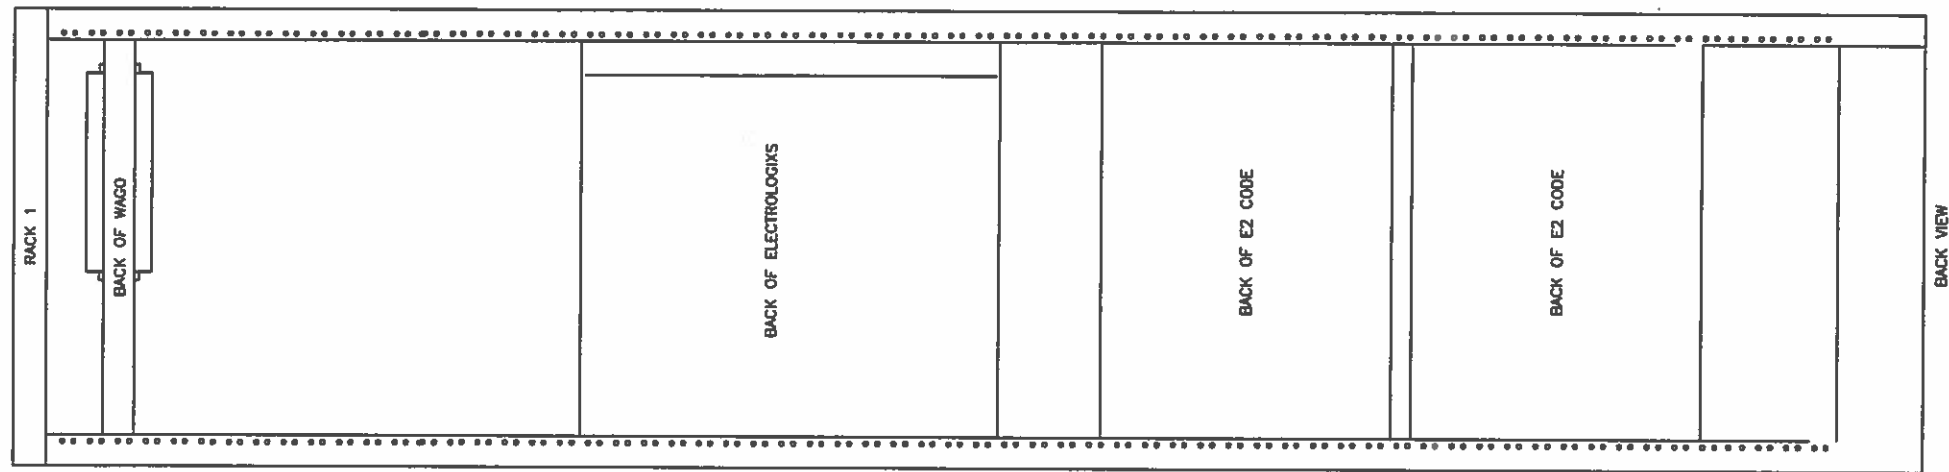


DD

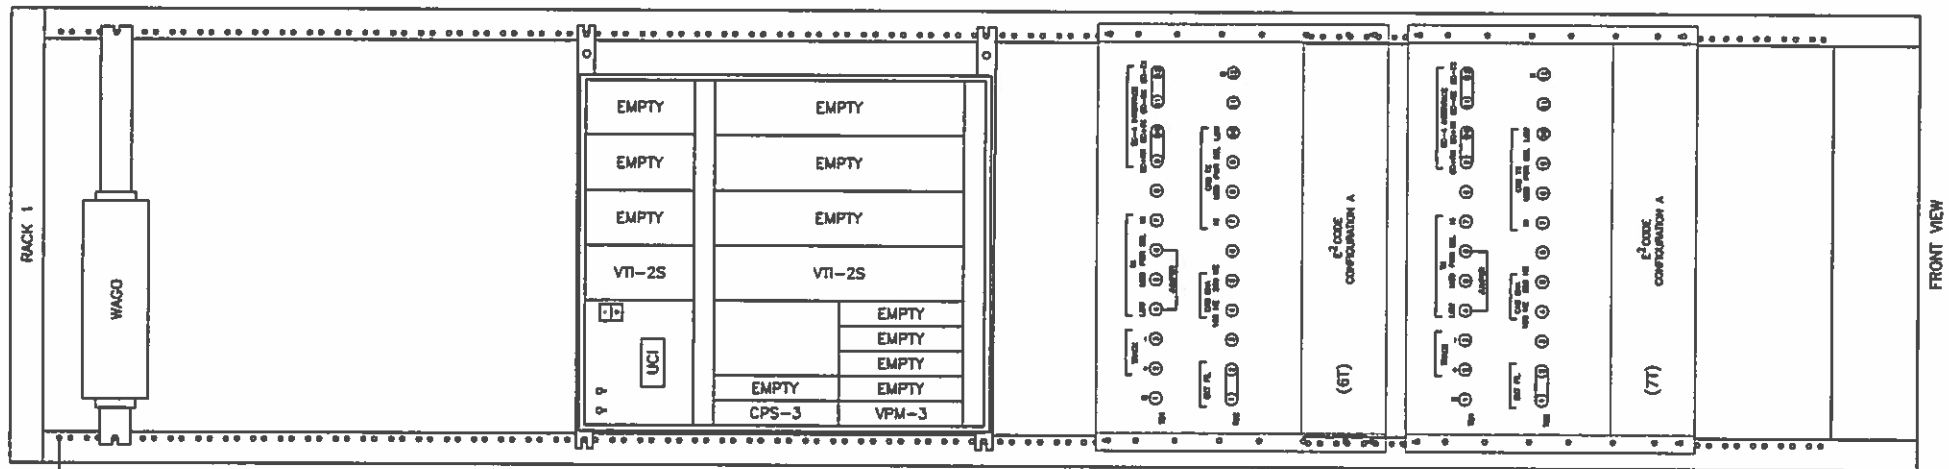

GRN 7/6

0 1 2 3 4 5 6 7 8 9 10 11 12
INCHES


					Designed By: BPC Drawn By: BPC Checked By: BDW Approved By: AEB	TTCI TTT HOUSE T-R RACK 1 LAYOUT	Scales: NTS CADD File Name: TR009.DWG Submitted Date: 03/11/15
1 03/11/15 AS DESIGNED	REV DATE DESCRIPTION						Sheet No. 009

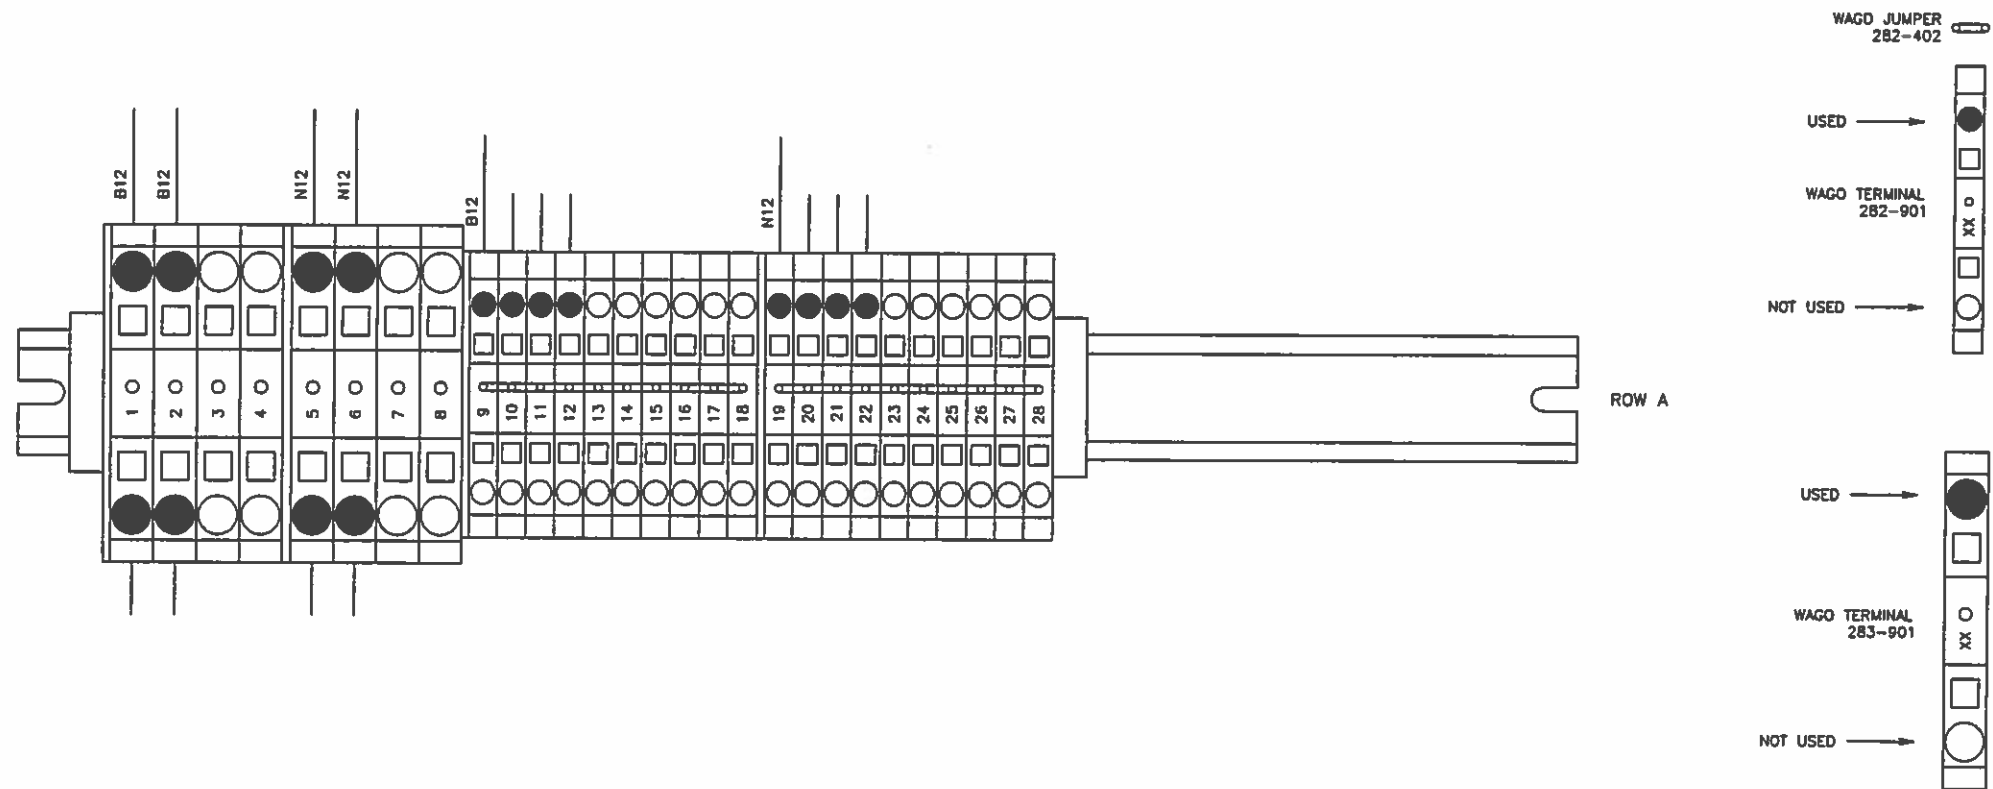

				Designed By:	BPC	TTCI TTT HOUSE T-R WAGO & RELAY LAYOUT RACK 1, ROW A & B	Scale:	NTS
				Drawn By:	BPC		CADD File Name:	TR010.DWG
				Checked By:	BDW		Submitted Date:	03/11/15
				Approved By:	AEB			
1	03/11/15	AS DESIGNED						
REV	DATE	DESCRIPTION						Sheet No. 010

HOUSE T-6

				Designed By: BPC Drawn By: BPC Checked By: BDW Approved By: AEB	TTCI TTT HOUSE T-6 COVER SHEET	Scale: NTS	
						CADD File Name: T6000.DWG	
						Submitted Date: 03/06/15	
							Sheet No. 000
2	03/30/15	UPDATES FROM SITE SURVEY/PLAN REVIEWS					
1	03/06/15	AS DESIGNED					
REV	DATE	DESCRIPTION					

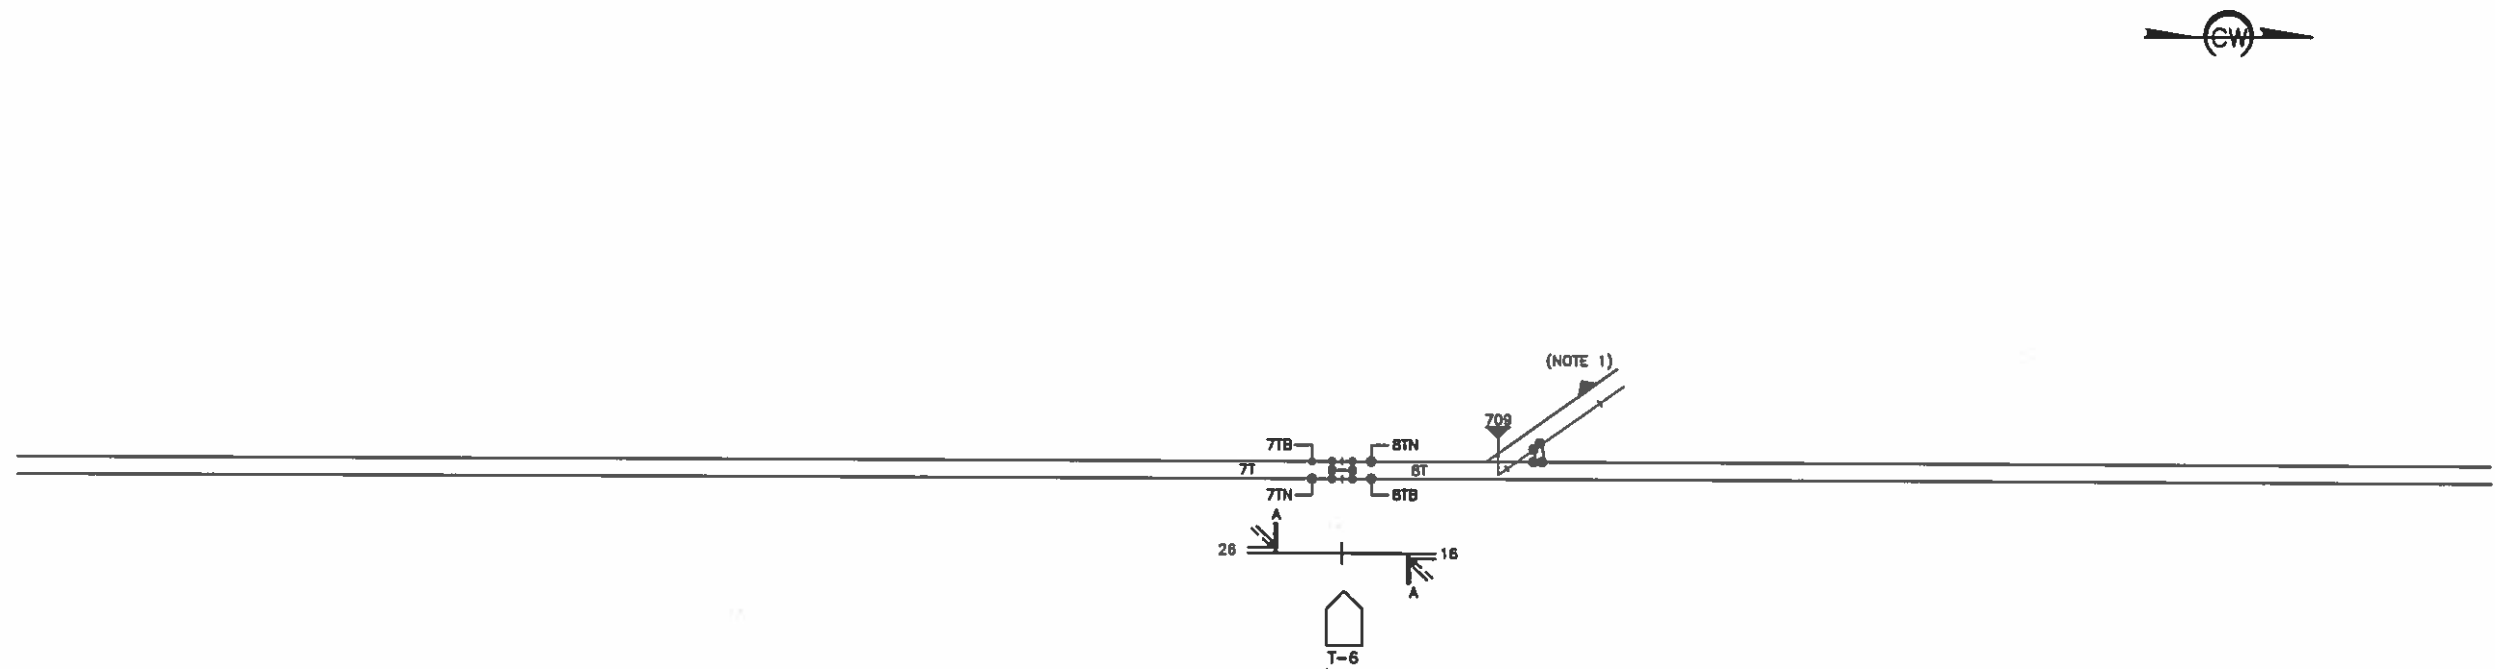


NOTES

1. PERMANENT DERAIL REQUIRED AT FOULING POINT

				Designed By:	BPC	TTCI	Scale:	NTS	
				Drawn By:	BPC		CADD File Name:	T6002.DWG	
				Checked By:			Submitted Date:	03/06/15	
				Approved By:					
2	03/30/15	ADDED INSULATED JOINTS AND JUMPERS TO 709 TURNOUT				TTT HOUSE T-6			
1	03/06/15	AS DESIGNED					TRACK & SIGNAL PLAN		
REV	DATE	DESCRIPTION							

CODE ASSIGNMENTS								
CONTROLS								
	BIT 1	BIT 2	BIT 3	BIT 4	BIT 5	BIT 6	BIT 7	BIT 8
BYTE 1	WSGZ	ENGZ	STOP					
INDICATIONS								
	BIT 1	BIT 2	BIT 3	BIT 4	BIT 5	BIT 6	BIT 7	BIT 8
BYTE 1	WSGK	WSTENK	ENGK	ENTENK	CCWK	CWK	7BK	7TK
BYTE 2	8BK	8TK	LOCALK					

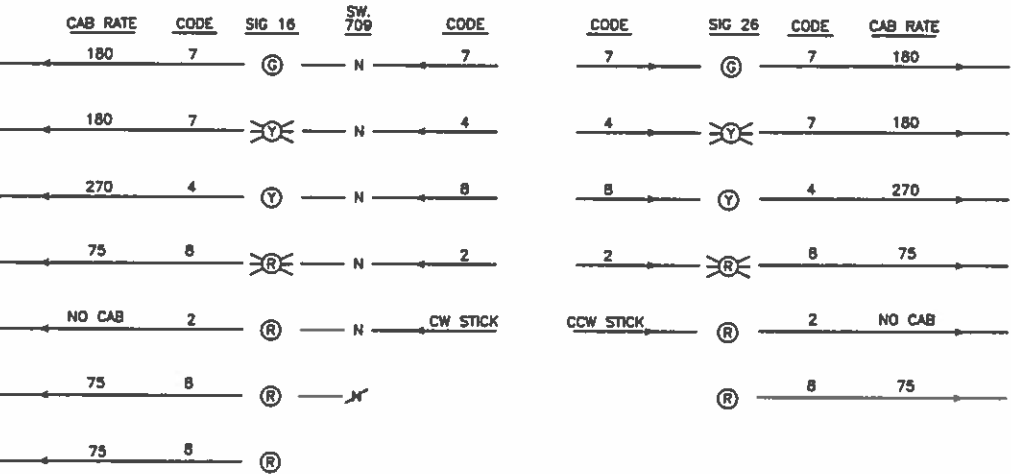

LAMP OUT DOWNGRADES FOR SIG 16				
CODE IN	LAMP OUT	ASPECT	CODE OUT	CAB RATE
7	G	FY	7	180
4,8	Y	FR	8	75
*NO CODE	R	D	8	75
ALL CODES	ALL	D	8	75

LAMP OUT DOWNGRADES FOR SIG 26				
CODE IN	LAMP OUT	ASPECT	CODE OUT	CAB RATE
7	G	FY	7	180
4,8	Y	FR	8	75
*NO CODE	R	D	8	75
ALL CODES	ALL	D	8	75

TTT CAB RATE TABLE		
NAME	DESIGNATOR	RATE
CLEAR	C	180
CAB SPEED	CS	270
APPROACH LIMITED	AL7	120
APPROACH	A	75
RESTRICTING	R	NO CAB




1	03/06/15	AS DESIGNED
REV	DATE	DESCRIPTION



Designed By:	BPC
Drawn By:	BPC
Checked By:	BDW
Approved By:	AEB

TTCI
TTT HOUSE T-6
CODE & ASPECT CHART

Scale:	NTS
CADD File Name:	T6003.DWG
Submitted Date:	03/06/15
Sheet No.	003

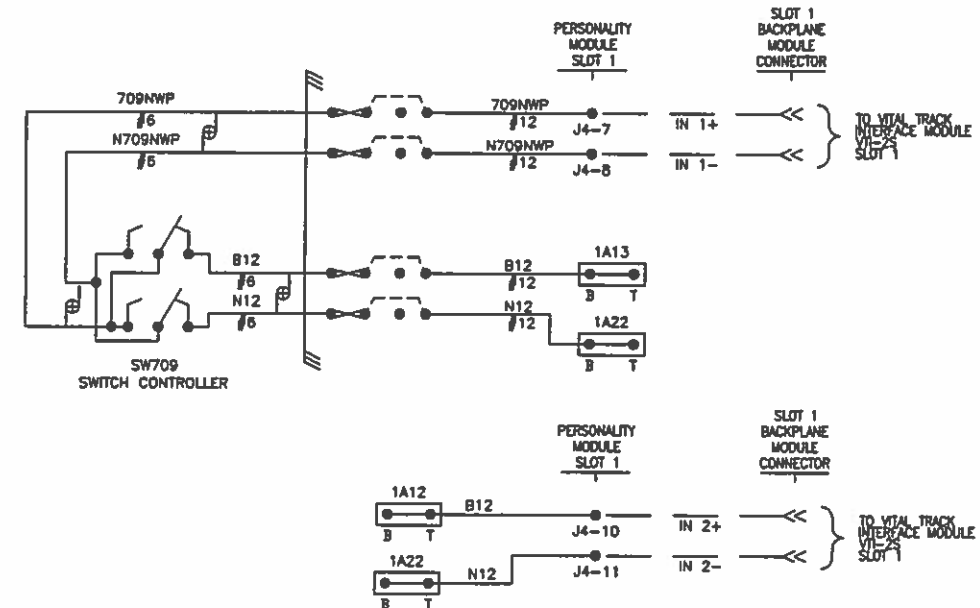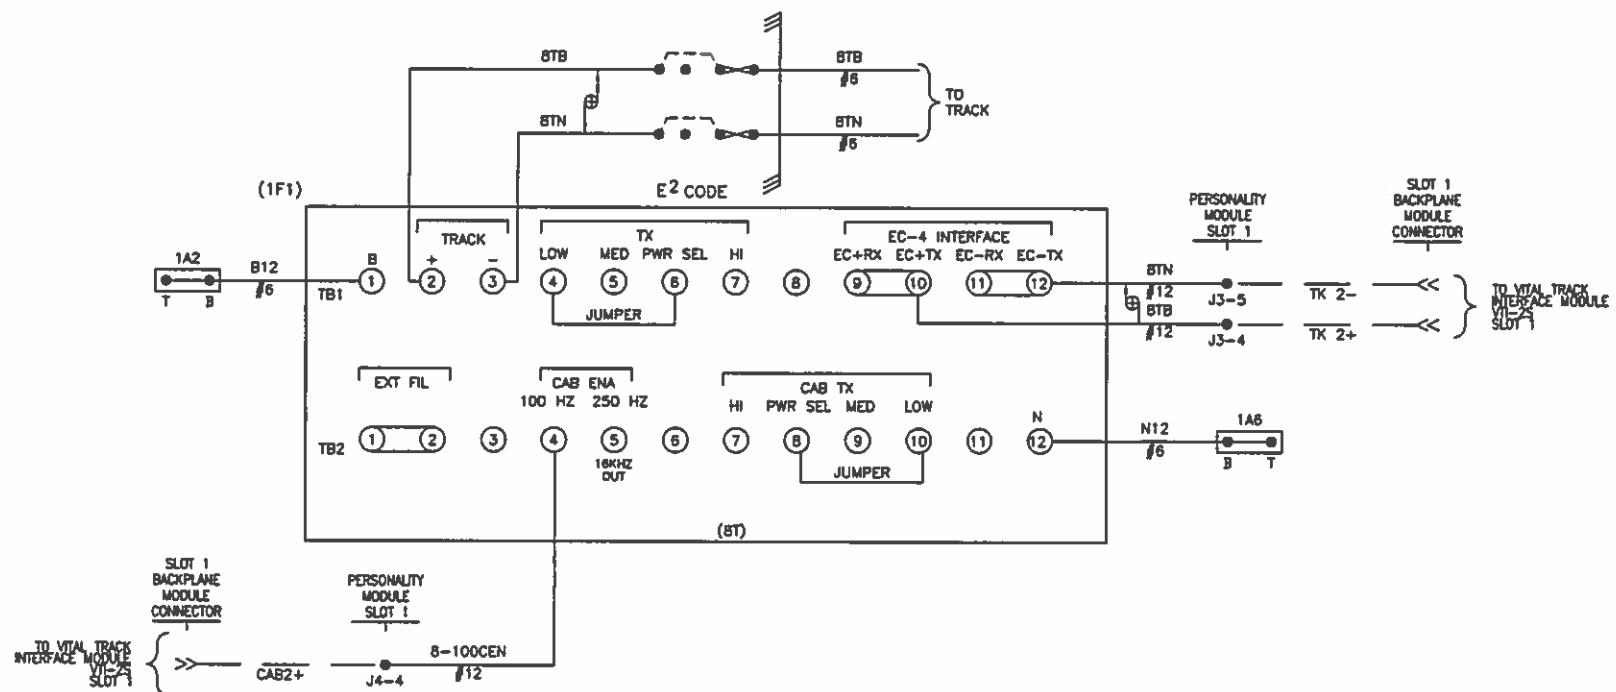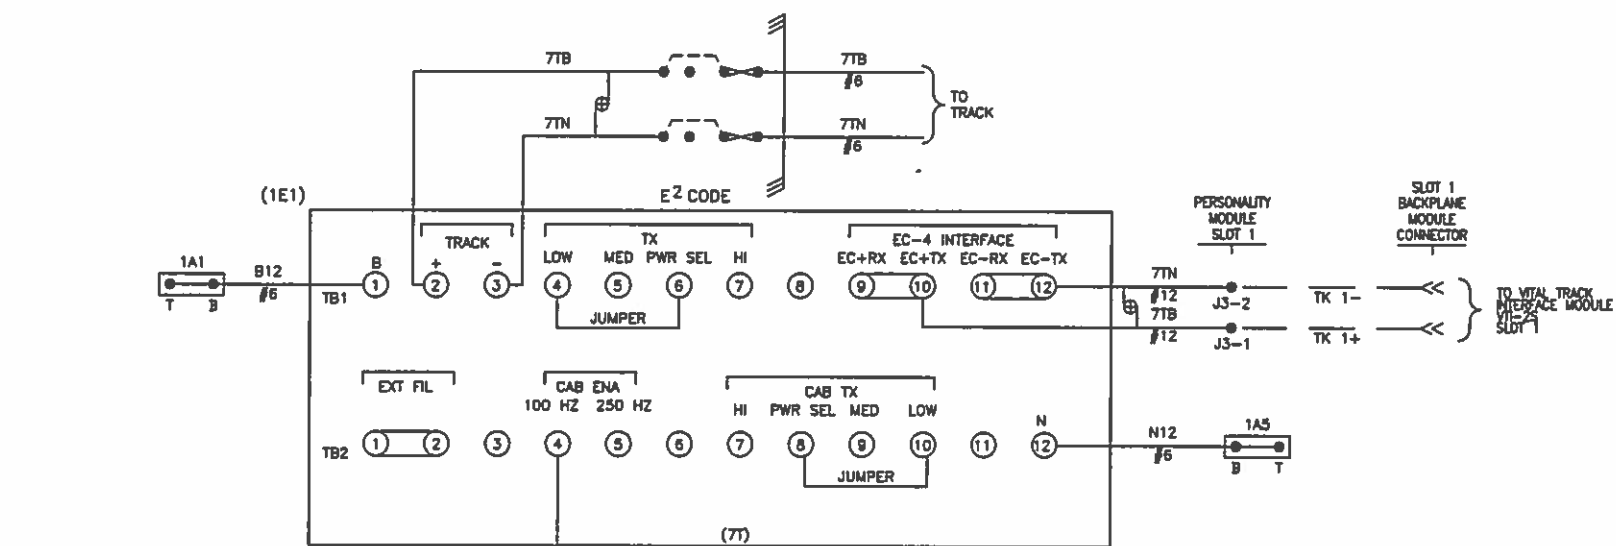

- NOTES:
- 1) ALL WIRING ON THIS SHEET TO BE #10 A UNLESS OTHERWISE NOTED.
 - 2) = TWISTED PAIR 2 TURNS PER FOX
 - 3) = INTERNAL CONNECTION


REV	DATE	DESCRIPTION
1	03/06/15	AS DESIGNED



Designed By:	BPC
Drawn By:	BPC
Checked By:	BDW
Approved By:	AEB

TTCI
TTT HOUSE T-6
TRACK CIRCUITS

Sheet:	NTS
CADD File Name:	T6004.DWG
Submitted Date:	03/06/15
Sheet No.	004

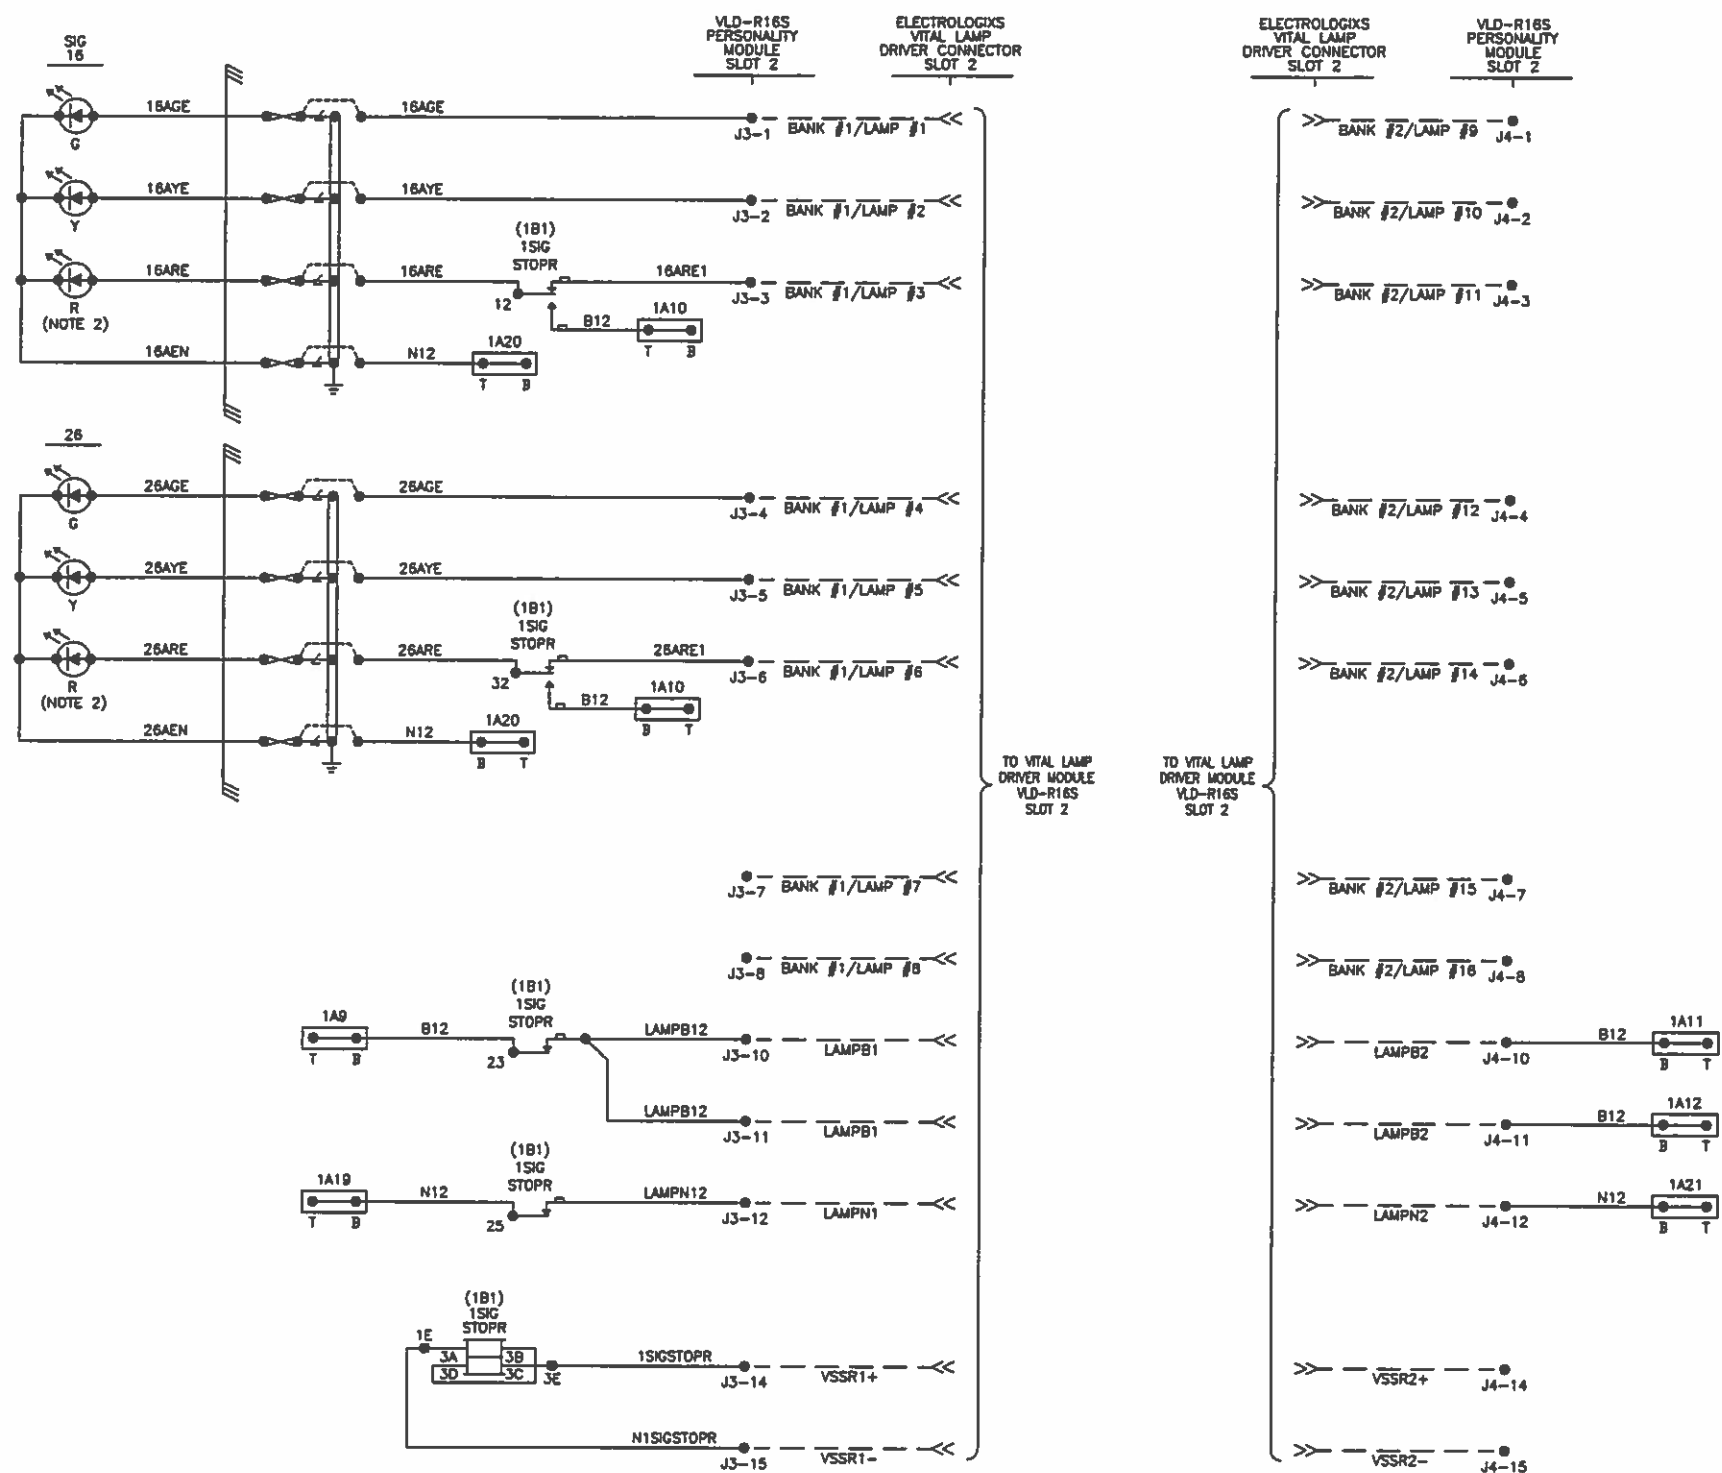

NOTES:

- 1) ALL WIRING ON THIS SHEET TO BE #12 AWG UNLESS OTHERWISE NOTED.
- 2) SIGNALS ARE GELCORE 98 SERIES


REV	DATE	DESCRIPTION
1	03/06/15	AS DESIGNED



Designed By:	BPC
Drawn By:	BPC
Checked By:	BDW
Approved By:	AEB



TTCI
TTT HOUSE T-6
SIGNAL LIGHTING CIRCUITS

Scale:	NTS
CADD File Name:	T6005.DWG
Submitted Date:	0306/2015
Sheet No.	005

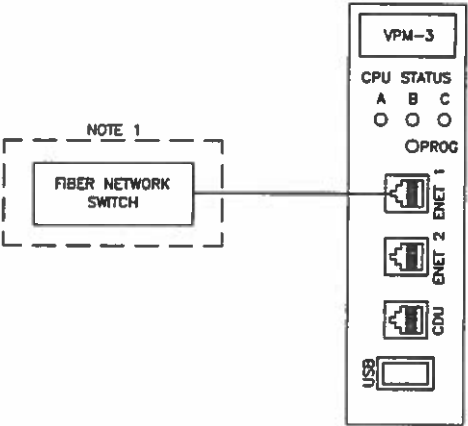

NOTES:
1) FIELD SUPPLIED

				Designed By:	BPC	TTCI TTT HOUSE T-6 COMMUNICATIONS	Scale:	NTS
				Drawn By:	BPC		CADD File Name:	T6006.DWG
				Checked By:	BDW		Submitted Date:	03/06/15
				Approved By:	AEB			
1	03/06/15	AS DESIGNED						
REV	DATE	DESCRIPTION						Sheet No. 006

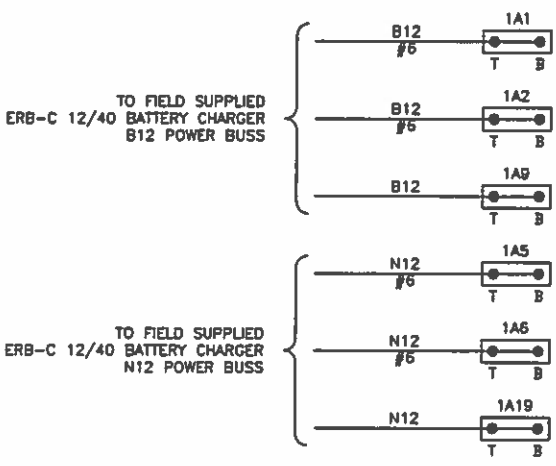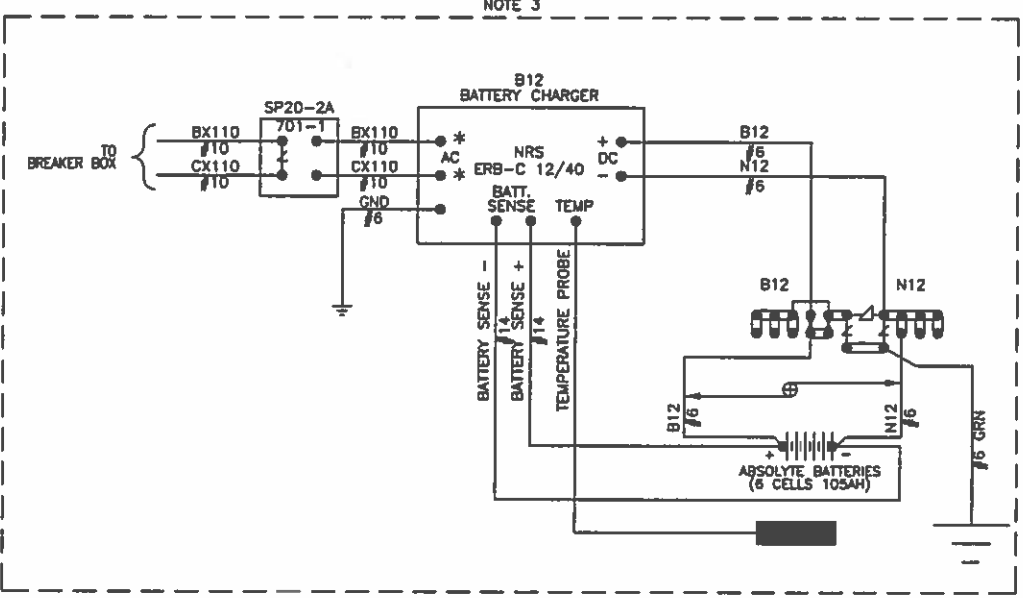

- NOTES:
- 1) ALL SIGNAL WIRING ON THIS SHEET TO BE #10 AWG UNLESS OTHERWISE NOTED.
 - 2) = TWISTED PAIR 2 TURNS PER FOOT.
 - 3) FIELD SUPPLIED


				Designed By:	BPC	TTCI TTT HOUSE T-6 POWER DISTRIBUTION CIRCUITS	Scale:	NTS
				Drawn By:	BPC		CADD File Name:	T6007.DWG
				Checked By:	BDW		Submitted Date:	03/06/15
				Approved By:	AEB			
1	03/06/15	AS DESIGNED						
REV	DATE	DESCRIPTION						Sheet No. 007

VTI-25 PERSONALITY MODULE (SLOT 1)			
TK 1+	7TB	X	1
TK 1-	7TN	X	2
			3
TK 2+	8TB	X	4
TK 2-	8TN	X	5
			6
			7
J3			

CAB1+	7-100CEN	X	1
CAB1-			2
			3
CAB2+	8-100CEN	X	4
CAB2-			5
			6
IN 1+	709NWP	X	7
IN 1-	N709NWP	X	8
			9
IN 2+	B12	X	10
IN 2-	N12	X	11
J4			

VLD-R185 PERSONALITY MODULE (SLOT 2)			
BANK 1			
LAMP1	16AGE	X	1
LAMP2	16AYE	X	2
LAMP3	16ARE1	X	3
LAMP4	26AGE	X	4
LAMP5	26AYE	X	5
LAMP6	26ARE1	X	6
LAMP7			7
LAMP8			8
			9
LAMPB1	LAMPB12	X	10
LAMPB1	LAMPB12	X	11
LAMPN1	LAMPN12	X	12
			13
VSSR1+	1SIGSTOPR	X	14
VSSR1-	N1SIGSTOPR	X	15
J3			

BANK 2			
LAMP9			1
LAMP10			2
LAMP11			3
LAMP12			4
LAMP13			5
LAMP14			6
LAMP15			7
LAMP16			8
			9
LAMPB2	B12	X	10
LAMPB2	B12	X	11
LAMPN2	N12	X	12
			13
VSSR2+			14
VSSR2-			15
J4			

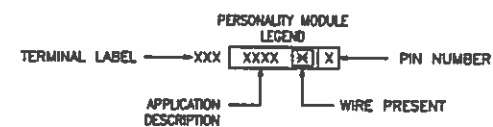

REV	DATE	DESCRIPTION
1	03/06/15	AS DESIGNED







Designed By:	BPC
Drawn By:	BPC
Checked By:	BDW
Approved By:	AEB

TTCI

TTT HOUSE T-6

ELECTROLOGIXS 9-SLOT
MODULE CONNECTOR USAGE

Scale:	NTS
CADD File Name:	T6008.DWG
Submitted Date:	03/06/15
Sheet No.	008

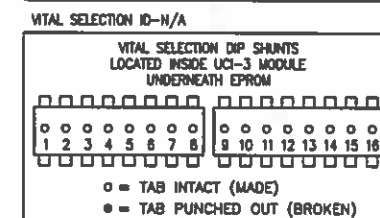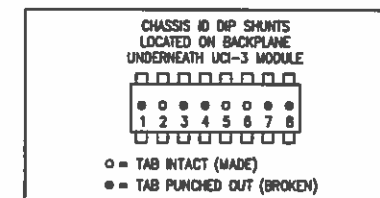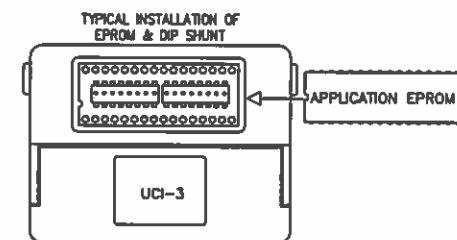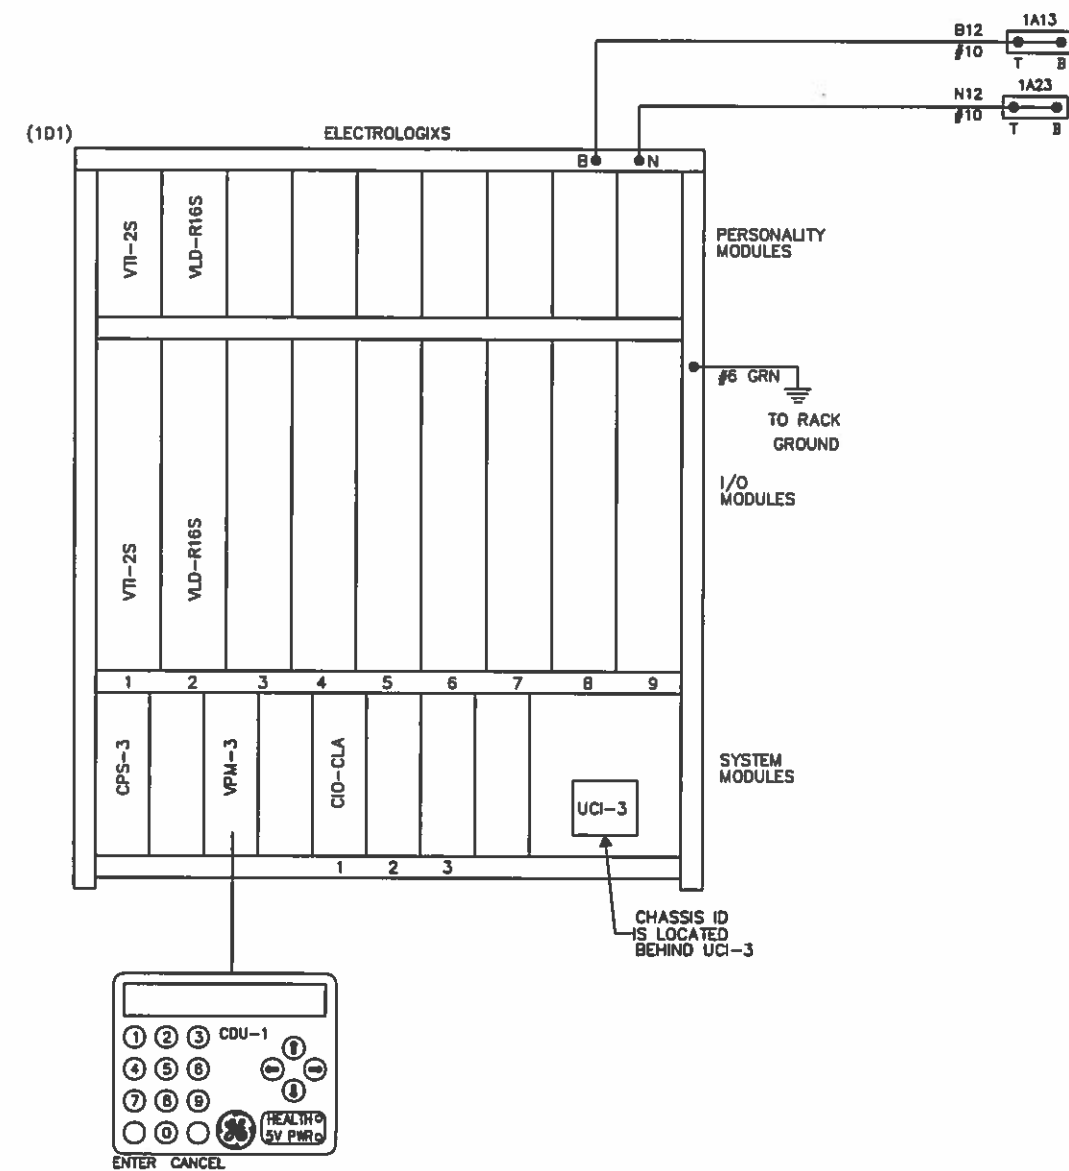

APPLICATION SOFTWARE INFORMATION	
NAME	tbd
REV.	nc
CHECKSUM	tbd
CRC	tbd

NOTES:


CDU-1 = CONTROL DISPLAY UNIT
CPS-3 = CENTRAL POWER SUPPLY
VPM-3 = VITAL PERIPHERAL MASTER MODULE
UCI-3 = CHASSIS INFORMATION MODULE
VTI-2S = VITAL TRACK INTERFACE
VLD-R16S = VITAL LAMP DRIVER MODULE
VIO-BES = VITAL INPUTS/OUTPUTS
CIO-CLA = COMMUNICATION INPUT/OUTPUT CURRENT LOOP ADAPTER

				Designed By:	BPC	TTCI TTT HOUSE T-6 ELECTROLOGIXS 9-SLOT HARDWARE CONFIGURATION	Scale:		NTS
				Drawn By:	BPC		CAD File Name:	T6009.DWG	
				Checked By:	BDW		Submitted Date:	03/06/15	
				Approved By:	AEB				
1	03/06/15	AS DESIGNED							
REV	DATE	DESCRIPTION							Sheet No. 009

SYSTEM CONFIGURATION						
DATE/TIME	SETTING MADE WHEN USING PTC CONFIGURATION					
DIAGNOSTIC PORT						
ETHERNET CONFIG.						
OFFICE CONFIG	NA					
LCP CONFIG	ENABLED		TRUE			
VITAL REMOTE CONFIG	LOCAL PORT		REMOTE PORT		REMOTE PORT CONFIG	
	ETHERNET PORT 1 192.168.40.76		1		IP	192.168.40.14
					PORT	8291
					LOCAL NETWORK ID	76
					REMOTE NETWORK ID	19
					PROTOCOL	RP2000
					DATE/TIME UPDATE	ENABLED
					MAC	DISABLED
	KEY IN USE		NO			
	ETHERNET PORT 2 192.168.1.12		NA		NA	NA
SERIAL PORT 2		NA				
SERIAL PORT 3		NA				
TRACK CONFIG	SLOT		TRACK		CONFIGURATION	
	SLOT 1: 7T_T11		1		TRANSMITTER	4V
					RECEIVER	0.5A
					CODE 5 TYPE	ALT 5
	SLOT 1: 8T_T11		2		TRANSMITTER	4V
					RECEIVER	0.5A
CODE 5 TYPE					ALT 5	



NOTES:
1. FINAL VITAL CONFIGURATION SETTINGS ARE SUBJECT TO CHANGE IN ACCORDANCE WITH SOFTWARE UPGRADES. FINAL VITAL CONFIGURATION SETTINGS TO BE UPDATED ON AS-IN-SERVICE.

					Designed By: BPC	TTCI TTT HOUSE T-6 ELECTROLOGIXS 9-SLOT CONFIGURATION SETTINGS	Scale: NTS	
					Drawn By: BPC		CADD File Name: T6D10.DWG	
					Checked By: BDW		Submitted Date: 03/06/15	
					Approved By: AEB			
1	03/06/15	AS DESIGNED						
REV	DATE	DESCRIPTION					Sheet No. 010	

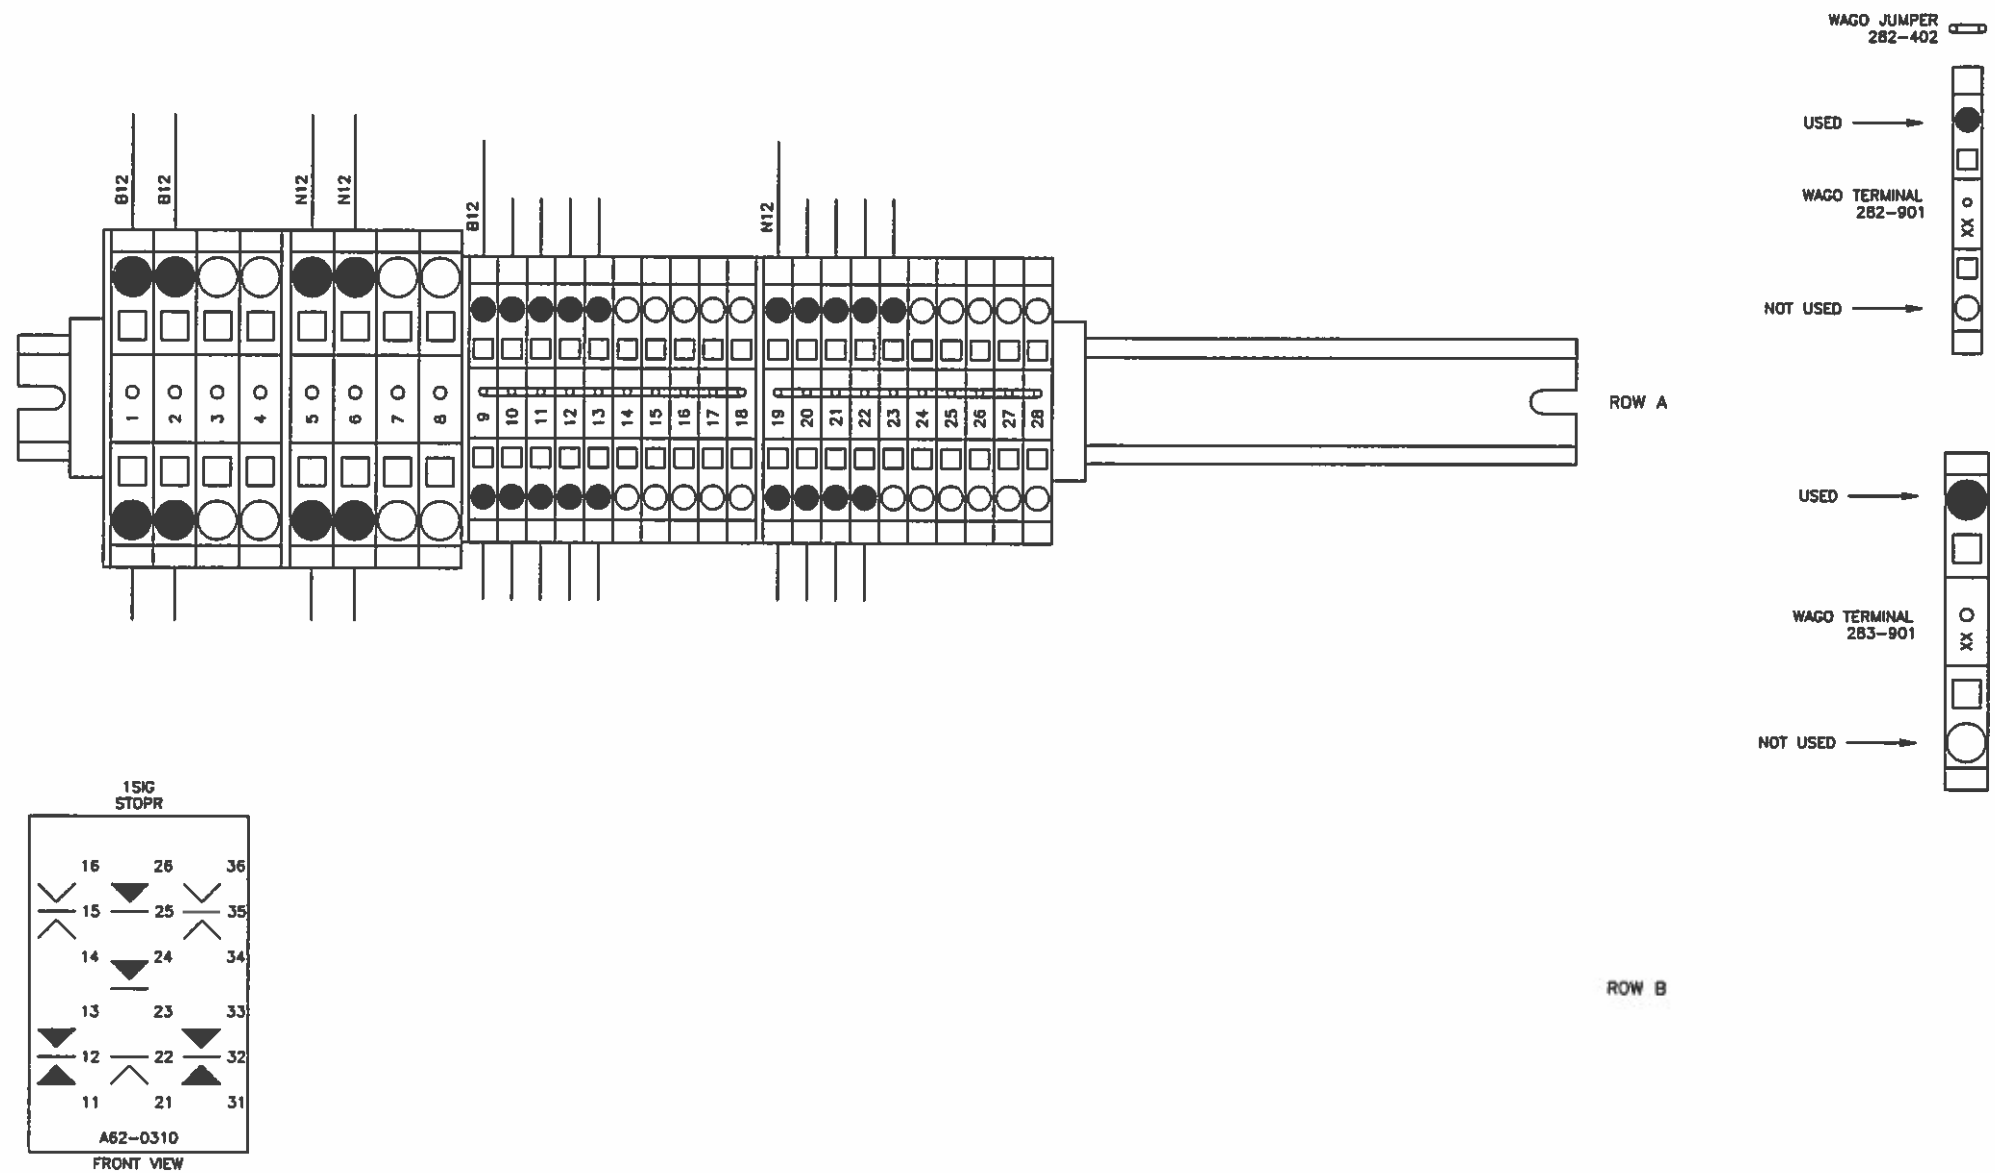


				Designed By:	BPC	NTS	Scale:	NTS
				Drawn By:	BPC		CADD File Name:	T6012.DWG
				Checked By:	BDW		Submitted Date:	03/06/15
				Approved By:	AEB			
1	03/06/15	AS DESIGNED		TTT HOUSE T-6			WAGO & RELAY LAYOUT RACK 1, ROW A & B	
REV	DATE	DESCRIPTION					Sheet No.	012

LCP DIP SWITCH SETTINGS

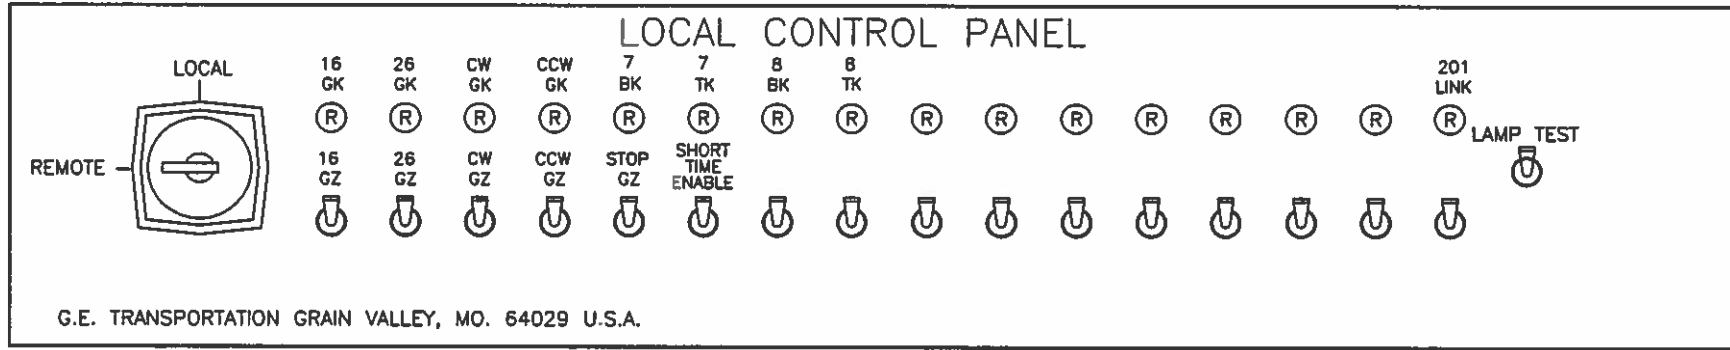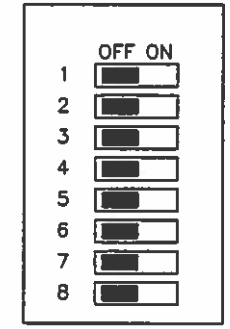

ROW C

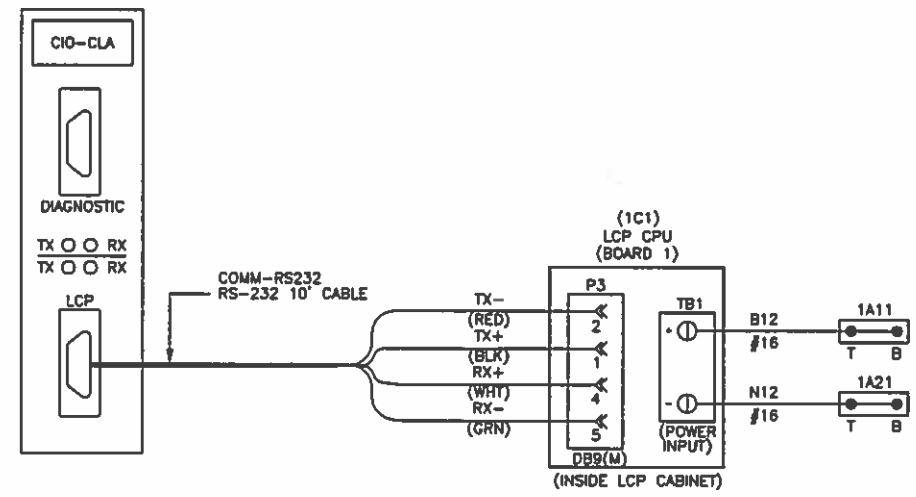



REV	DATE	DESCRIPTION
1	03/06/15	AS DESIGNED




Designed By:	BPC
Drawn By:	BPC
Checked By:	BDW
Approved By:	AEB

TTCI
TTT HOUSE T-6
LOCAL CONTROL PANEL

Scale:	NTS
CADD File Name:	T6013.DWG
Submitted Date:	03/06/15
Sheet No.	013

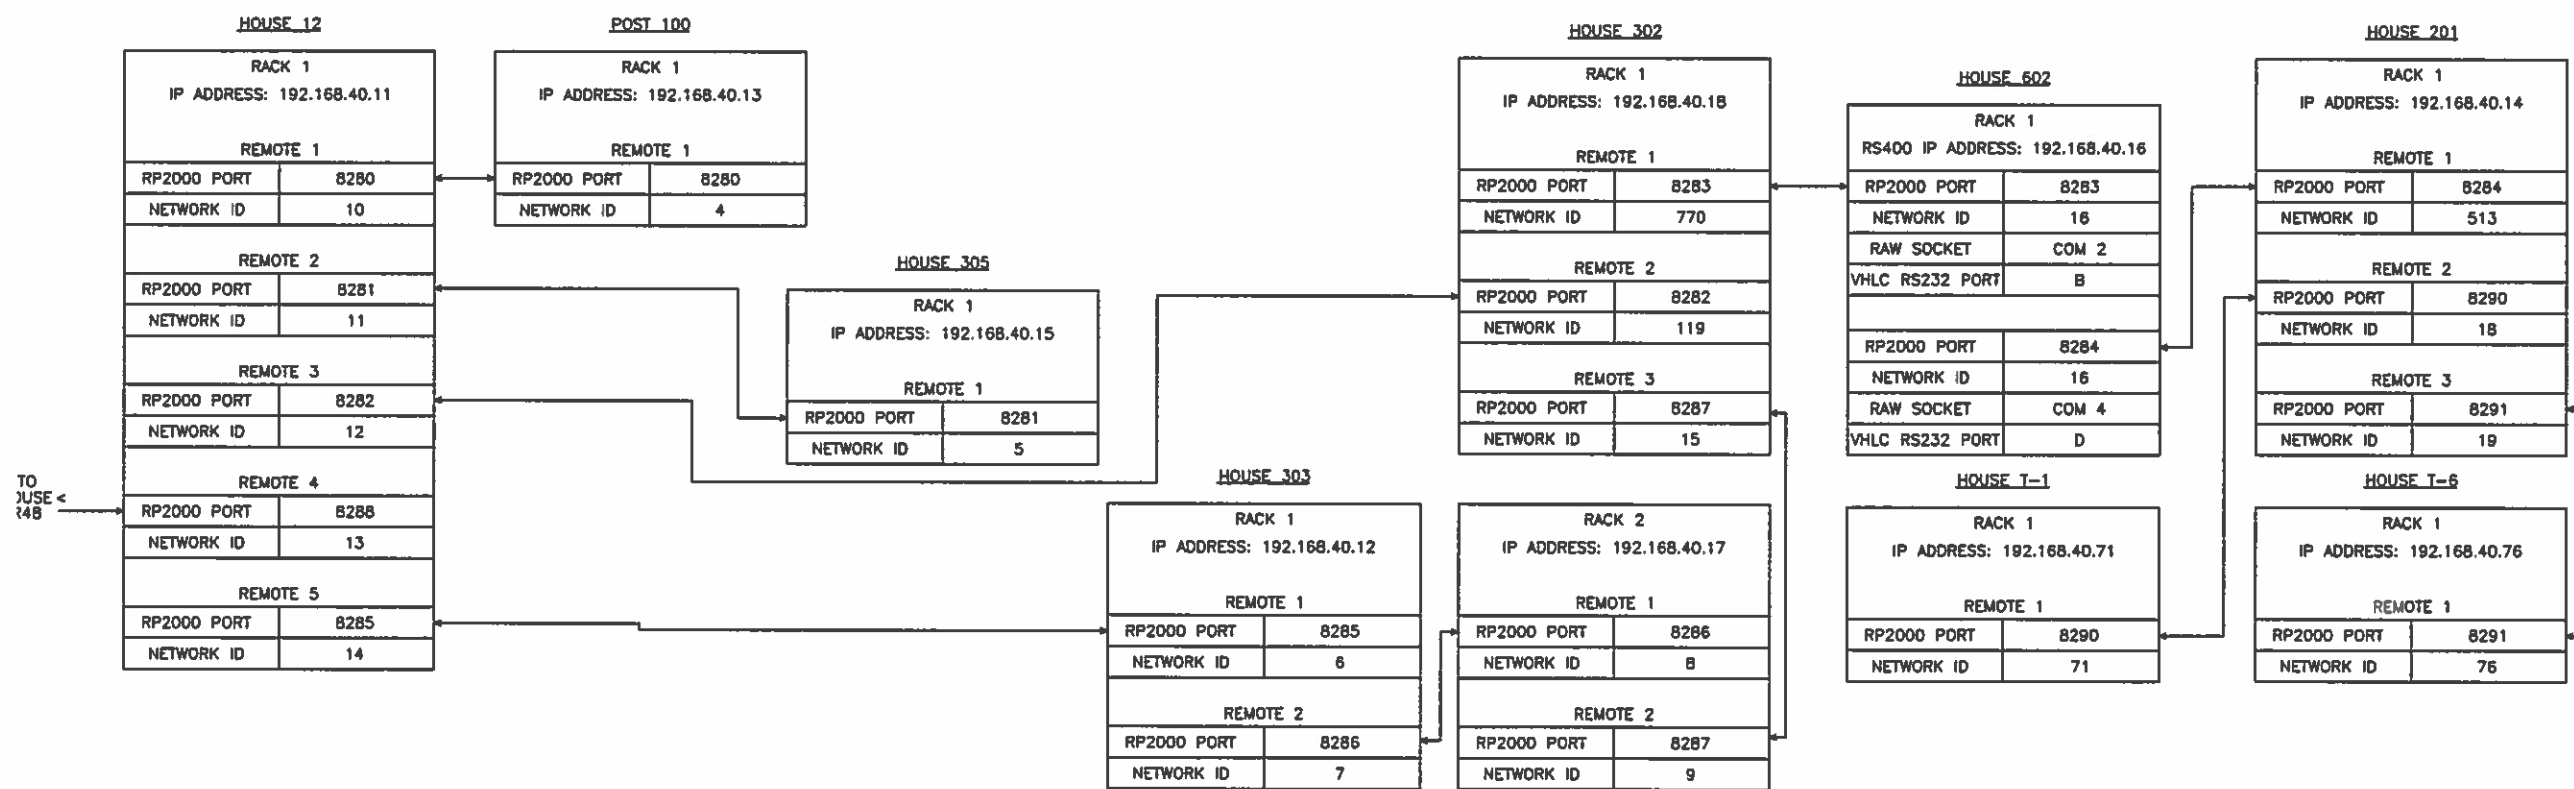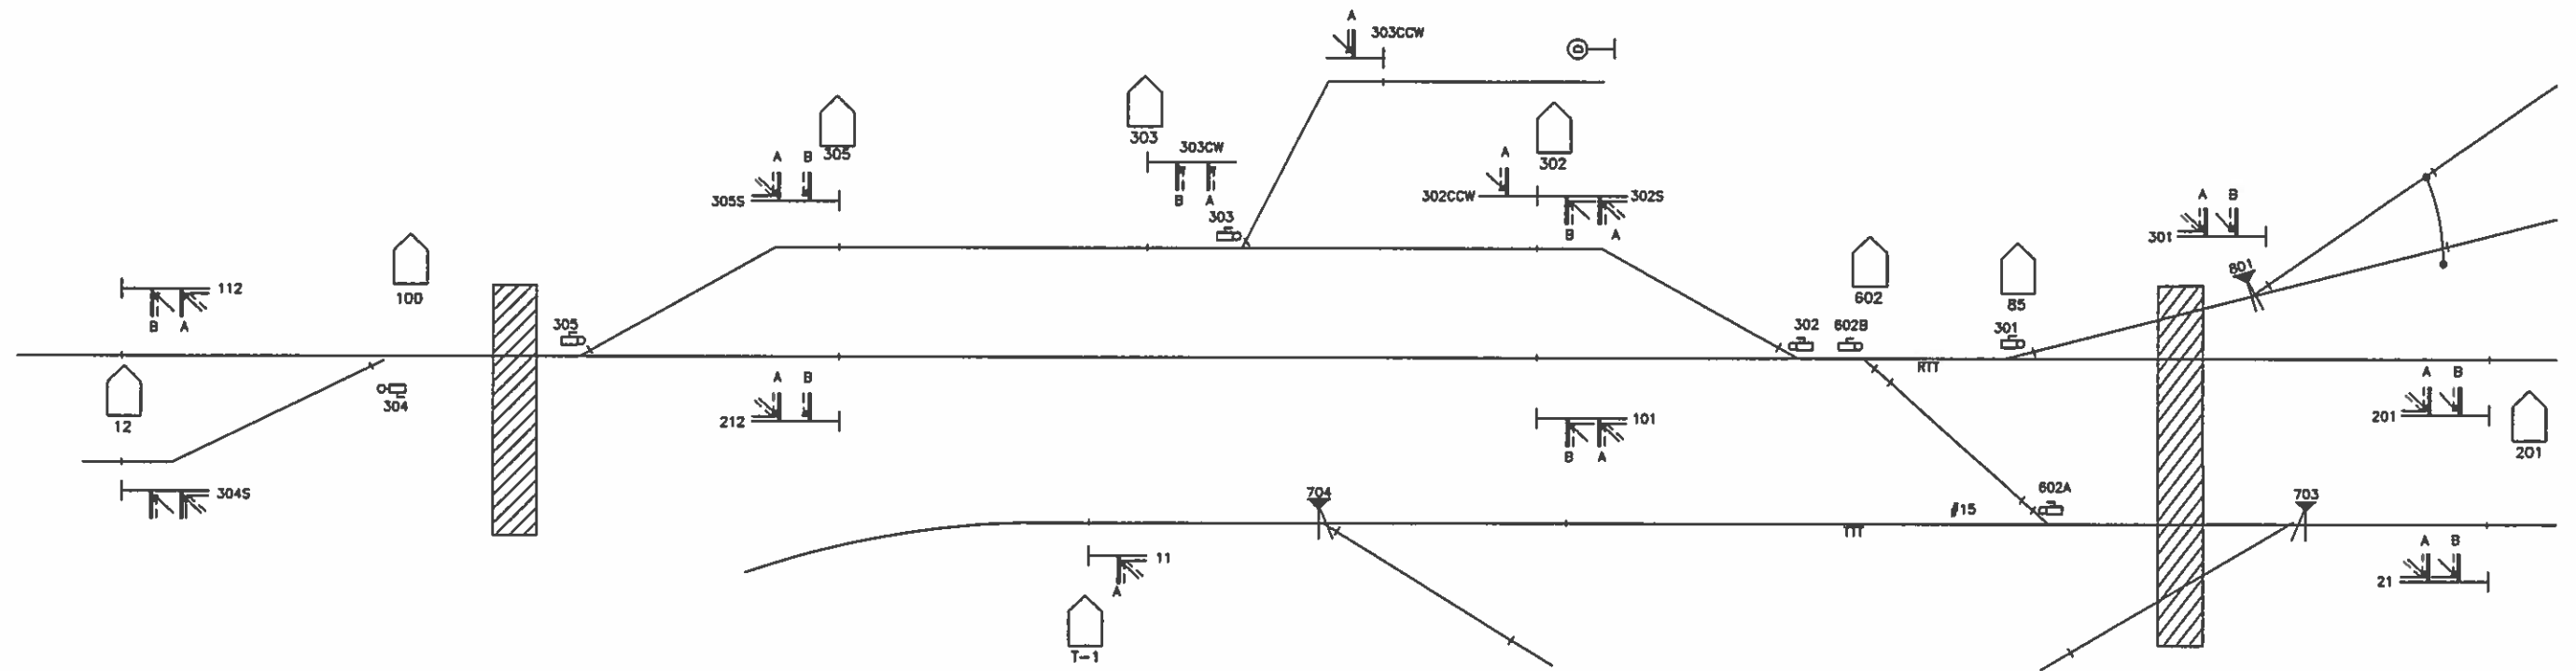

REV	DATE	DESCRIPTION		Designed By: BPC Drawn By: BPC Checked By: DBW Approved By: AEB	TTCT TTT HOUSE T-6 RTT/TTT VITAL REMOTE NETWORKS	Solder: NTS CAD File Name: T6014.DWG Submitted Date: 03/06/15 Sheet No. 014
1	03/06/15	AS DESIGNED				

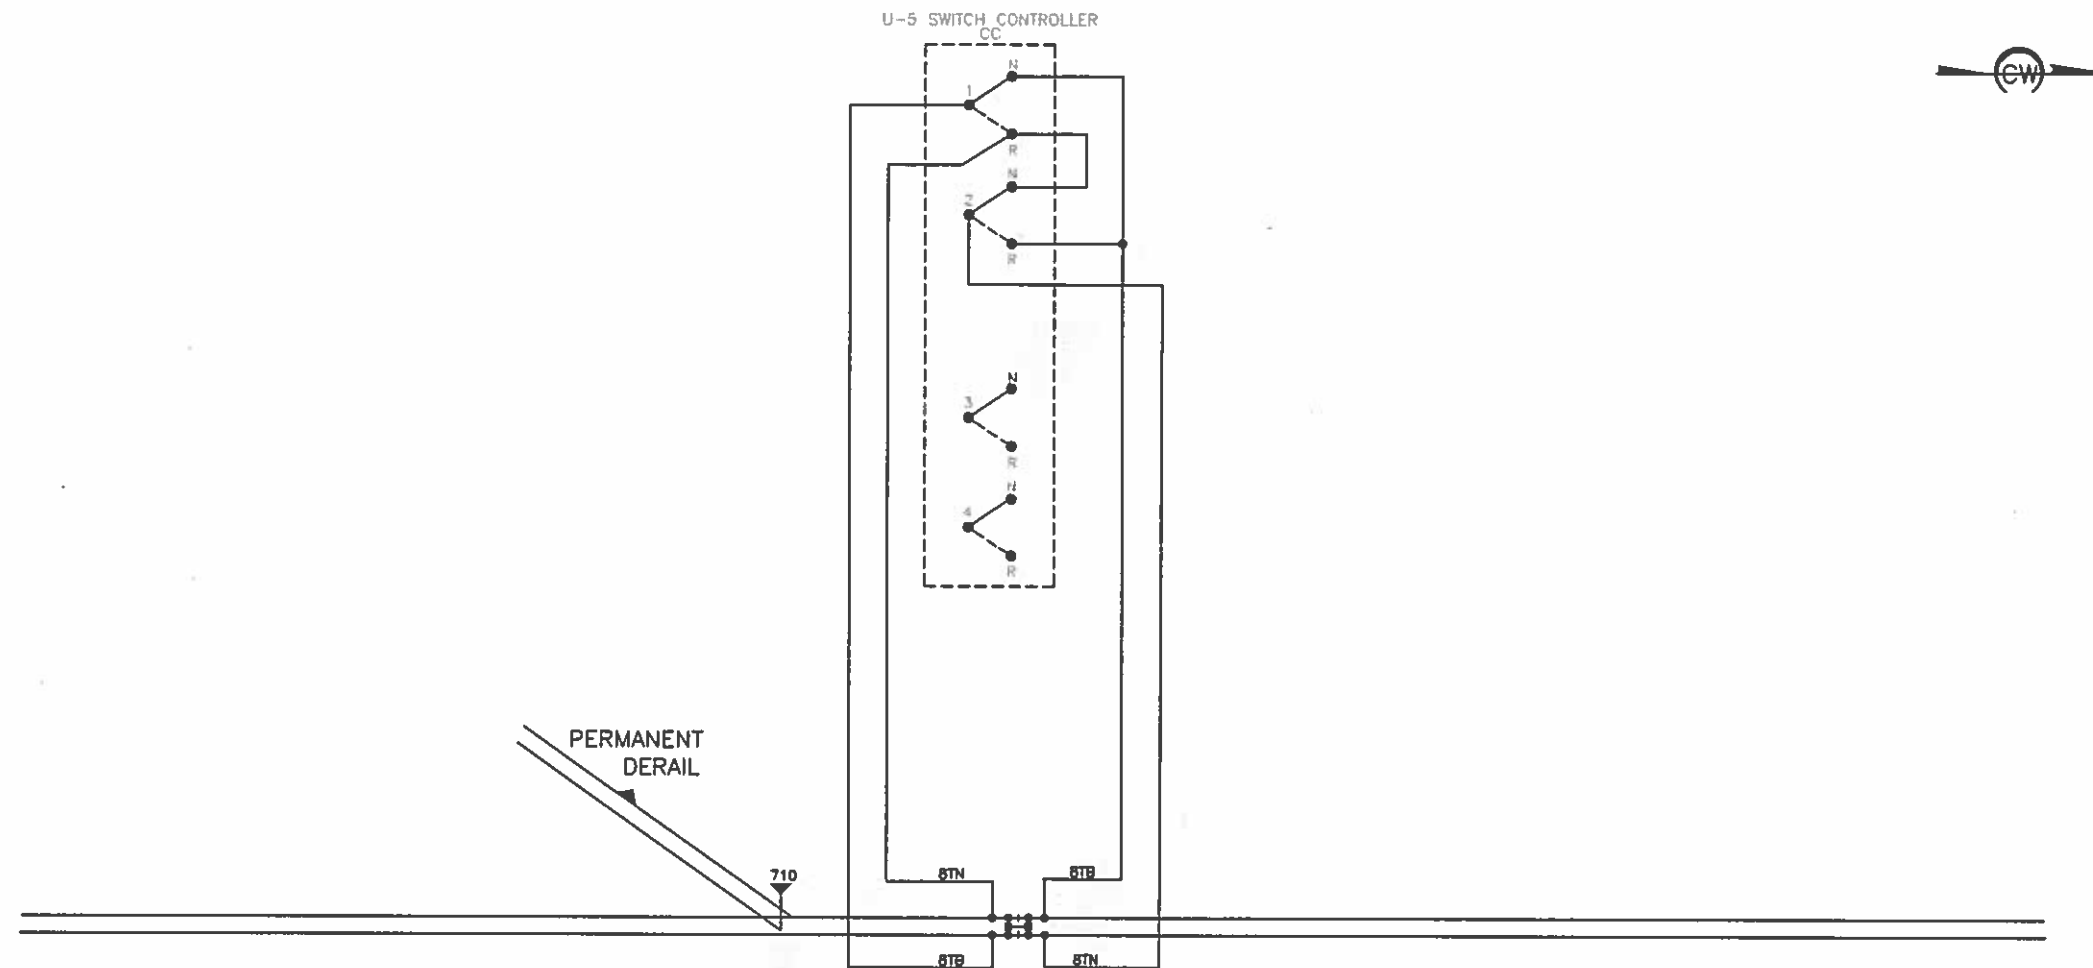

NOTES:

1. WHEN THE HANDTHROW SWITCH IS IN THE NORMAL POSITION THE CIRCUIT CONTROLLER WILL BYPASS THE INSULATED JOINTS COMPLETING THE TRACK CIRCUIT.
2. WHEN THE HANDTHROW SWITCH IS NOT NORMAL THE CIRCUIT CONTROLLER WILL SHUNT THE TRACK ON BOTH SIDES OF THE INSULATED JOINT.
3. A PERMANENT DERAIL MUST BE INSTALLED AT THE FOULING POINT.
4. ALL WIRING ON THIS SHEET TO BE #6 AWG.
5. IMPEDANCE BOND AND INSULATED JOINTS SHOWN SHOULD BE ADDED IN CLOSE PROXIMITY TO THE SWITCH TO MINIMIZE CABLE LENGTH.

				Designed By:	BPC	TTCI TTT HANDTHROW SWITCH 710	Scale:	NTS
				Drawn By:	BPC		CADD File Name:	TSW710.DWG
				Checked By:	BDW		Submitted Date:	03/10/15
				Approved By:	AEB			
1	03/11/15	AS DESIGNED						
REV	DATE	DESCRIPTION						Sheet No. 000


HOUSE T-7

					Designed By:	BPC	TTCI TTT HOUSE T-7 COVER SHEET	Scale:	NTS
					Drawn By:	BPC		CADD File Name:	T7000.DWG
					Checked By:	BDW		Submitted Date:	03/11/15
					Approved By:	AEB			Sheet No.
1	03/11/15	AS DESIGNED							000
REV	DATE	DESCRIPTION							

INDEX OF DRAWINGS			
SHT. NO.	DWG. NO.	REV.	DESCRIPTION
000	T7000.DWG	1	COVER SHEET
001	T7001.DWG	1	INDEX
002	T7002.DWG	1	TRACK & SIGNAL PLAN
003	T7003.DWG	1	CODE & ASPECT CHART
004	T7004.DWG	1	TRACK CIRCUITS
005	T7005.DWG	1	POWER DISTRIBUTION CIRCUITS
006	T7006.DWG	1	ELECTROLOGIXS 4-SLOT MODULE CONNECTOR USAGE
007	T7007.DWG	1	ELECTROLOGIXS 4-SLOT HARDWARE CONFIGURATION
008	T7008.DWG	1	ELECTROLOGIXS 4-SLOT CONFIGURATION SETTINGS
009	T7009.DWG	1	RACK 1 LAYOUT
010	T7010.DWG	1	WAGO & RELAY LAYOUT RACK 1, ROW A & B

					Designed By:	BPC	TTCI	Scale:	NTS
					Drawn By:	BPC		CADD File Name:	T7001.DWG
					Checked By:	BDW	TTT HOUSE T-7	Submitted Date:	03/11/15
					Approved By:	AEB	INDEX		
1	03/11/15	AS DESIGNED							Sheet No.
REV	DATE	DESCRIPTION							001



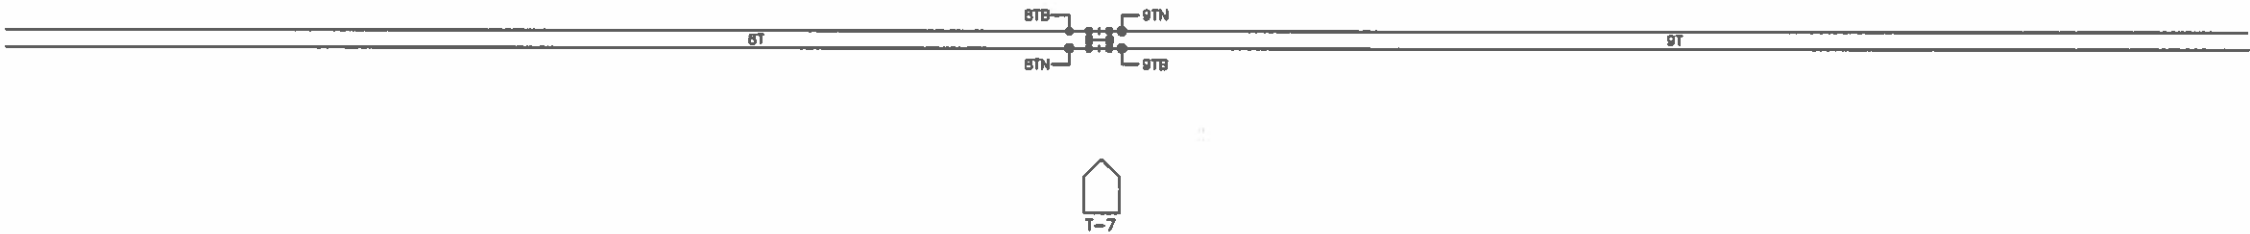

				Designed By:	BPC	TTCI TTT HOUSE T-7 TRACK & SIGNAL PLAN	Scale: NTS	
				Drawn By:	BPC		CADD File Name: T7002.DWG	
				Checked By:	BDW		Submitted Date: 03/11/15	
				Approved By:	AEB			
1	03/11/15	AS DESIGNED						Sheet No. 002
REV	DATE	DESCRIPTION						

<u>CAB RATE</u>	<u>CODE</u>	<u>CODE</u>
← 180	7	← 7
← 180	7	← 4
← 270	4	← 8
← 75	8	← 2
← NO CAB	2	← CW STICK
← 75	8	

<u>CODE</u>	<u>CODE</u>	<u>CAB RATE</u>
7 →	7	180 →
4 →	7	180 →
8 →	4	270 →
2 →	8	75 →
CW STICK →	2	NO CAB →
	8	75 →

TTT CAB RATE TABLE		
NAME	DESIGNATOR	RATE
CLEAR	C	180
CAB SPEED	CS	270
APPROACH LIMITED	AL?	120
APPROACH	A	75
RESTRICTING	R	NO CAB



1	03/11/15	AS DESIGNED
REV	DATE	DESCRIPTION



Designed By:	BPC
Drawn By:	BPC
Checked By:	BDW
Approved By:	AEB

TTCI
TTT HOUSE T-7
CODE & ASPECT CHART

Scale:	NTS
CADD File Name:	T7003.DWG
Submitted Date:	03/11/15
Sheet No.	003

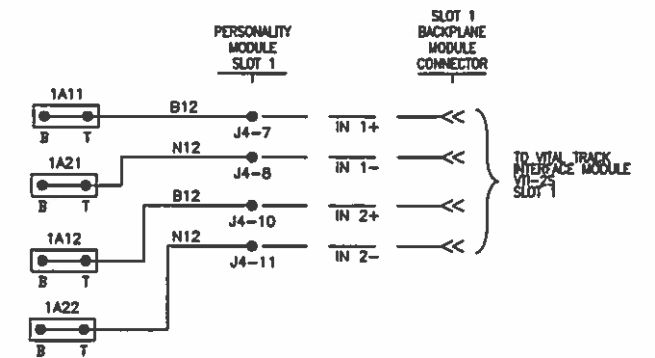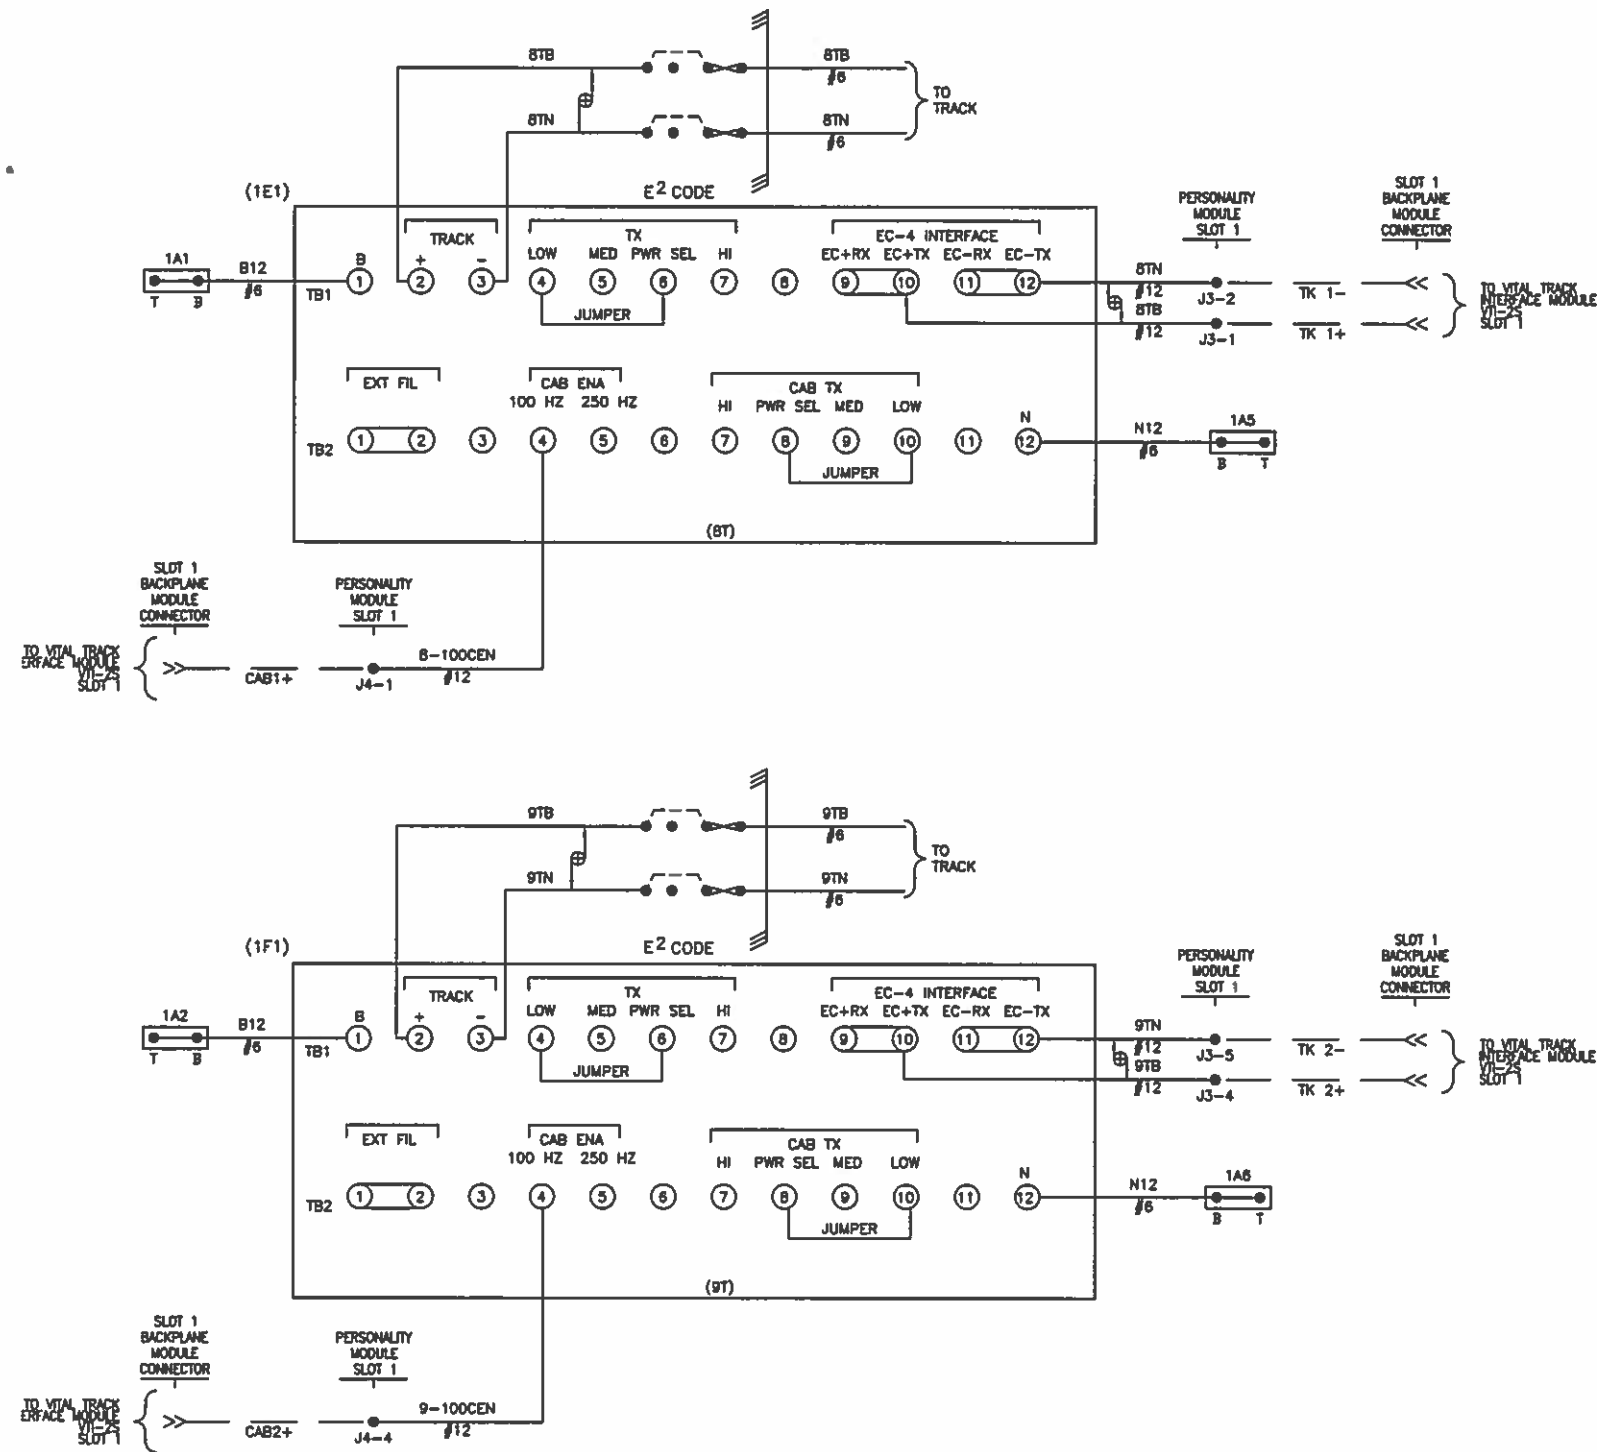

- NOTES:**
- 1) ALL WIRING ON THIS SHEET TO BE #10 AWG UNLESS OTHERWISE NOTED.
 - 2) = TWISTED PAIR 2 TURNS PER FOOT.
 - 3) = INTERNAL CONNECTION



REV	DATE	DESCRIPTION
1	03/11/15	AS DESIGNED



Designed By:	BPC
Drawn By:	BPC
Checked By:	BDW
Approved By:	AEB

TTCI
TTT HOUSE T-7
TRACK CIRCUITS

Scale:	NTS
CADD File Name:	T7004.DWG
Submitted Date:	03/11/15
Sheet No.	004

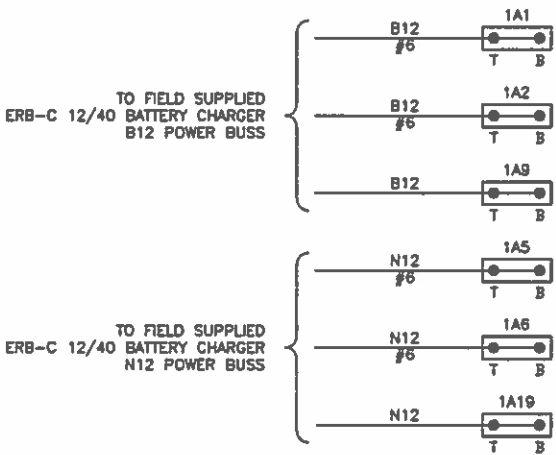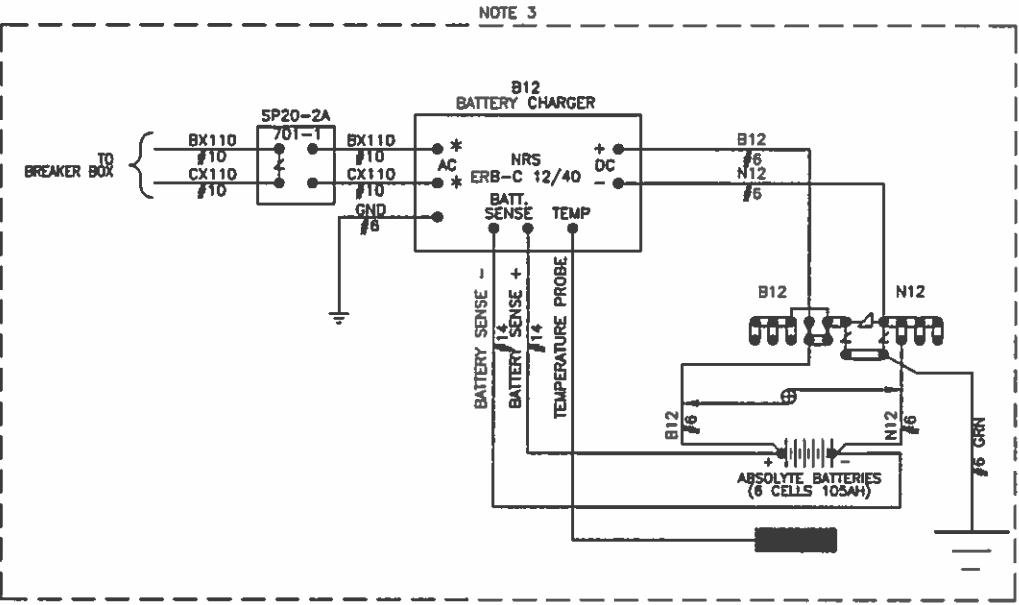

- NOTES:
- 1) ALL SIGNAL WIRING ON THIS SHEET TO BE #10 AWG UNLESS OTHERWISE NOTED.
 - 2) = TWISTED PAIR 2 TURNS PER FOOT.
 - 3) FIELD SUPPLIED

					Designed By:	BPC	TTCI	Scale:	NTS
					Drawn By:	BPC		CADD File Name:	T7005.DWG
					Checked By:	BDW	TTT HOUSE T-7	Submitted Date:	03/11/15
					Approved By:	AEB	POWER DISTRIBUTION CIRCUITS		Sheet No.
									005
1	03/11/15	AS DESIGNED							
REV	DATE		DESCRIPTION						




VII-2S
PERSONALITY
MODULE
(SLOT 1)

TK 1+	8TB	X	1
TK 1-	8TN	X	2
			3
TK 2+	9TB	X	4
TK 2-	9TN	X	5
			6
			7


J3

CAB1+	8-100CEN	X	1
CAB1-			2
			3
CAB2+	9-100CEN	X	4
CAB2-			5
			6
IN 1+	B12	X	7
IN 1-	N12	X	8
			9
IN 2+	B12	X	10
IN 2-	N12	X	11

J4

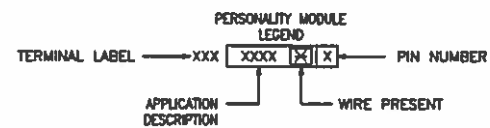

					Designed By:	BPC	TTCI	Scale:	NTS
					Drawn By:	BPC		CADD File Name:	T7006.DWG
					Checked By:	BDW	TTT HOUSE T-7	Submitted Date:	03/11/15
					Approved By:	AEB	ELECTROLOGIXS 4-SLOT MODULE CONNECTOR USAGE		Sheet No.
1	03/06/15	AS DESIGNED							006
REV	DATE	DESCRIPTION							


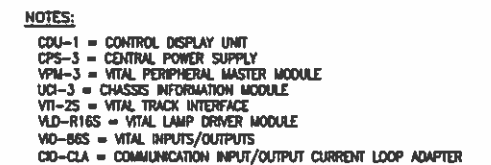


Sector:		NTS	
CADD File Name:		T7007.DWG	
Submitted Date:		03/11/15	
		Sheet No.	007


SYSTEM CONFIGURATION				
DATE/TIME	SETTING MADE WHEN USING PTC CONFIGURATION			
DIAGNOSTIC PORT				
ETHERNET CONFIG.				
OFFICE CONFIG	NA			
LCP CONFIG	ENABLED	TRUE		
VITAL REMOTE CONFIG	LOCAL PORT	REMOTE PORT	REMOTE PORT CONFIG	
	ETHERNET PORT 1 192.168.40.77	NA	NA	NA
	ETHERNET PORT 2 192.168.1.12	NA	NA	NA
	SERIAL PORT 2	NA		
	SERIAL PORT 3	NA		
TRACK CONFIG	SLOT	TRACK	CONFIGURATION	
	SLOT 1: 8T_T11	1	TRANSMITTER	4V
			RECEIVER	0.5A
			CODE 5 TYPE	ALT 5
	SLOT 1: 9T_T11	2	TRANSMITTER	4V
			RECEIVER	0.5A
			CODE 5 TYPE	ALT 5

NOTES:
1. FINAL VITAL CONFIGURATION SETTINGS ARE SUBJECT TO CHANGE IN ACCORDANCE WITH SOFTWARE UPGRADES. FINAL VITAL CONFIGURATION SETTINGS TO BE UPDATED ON AS-IN-SERVICE.

				Designed By:	BPC	TTCI TTT HOUSE T-7 ELECTROLOGIXS 4-SLOT CONFIGURATION SETTINGS	Scale:	NTS
				Drawn By:	BPC		CADD File Name:	T7008.DWG
				Checked By:	BDW		Submitted Date:	03/11/15
				Approved By:	AEB			
								Sheet No. 008
1	03/11/15	AS DESIGNED						
REV	DATE	DESCRIPTION						

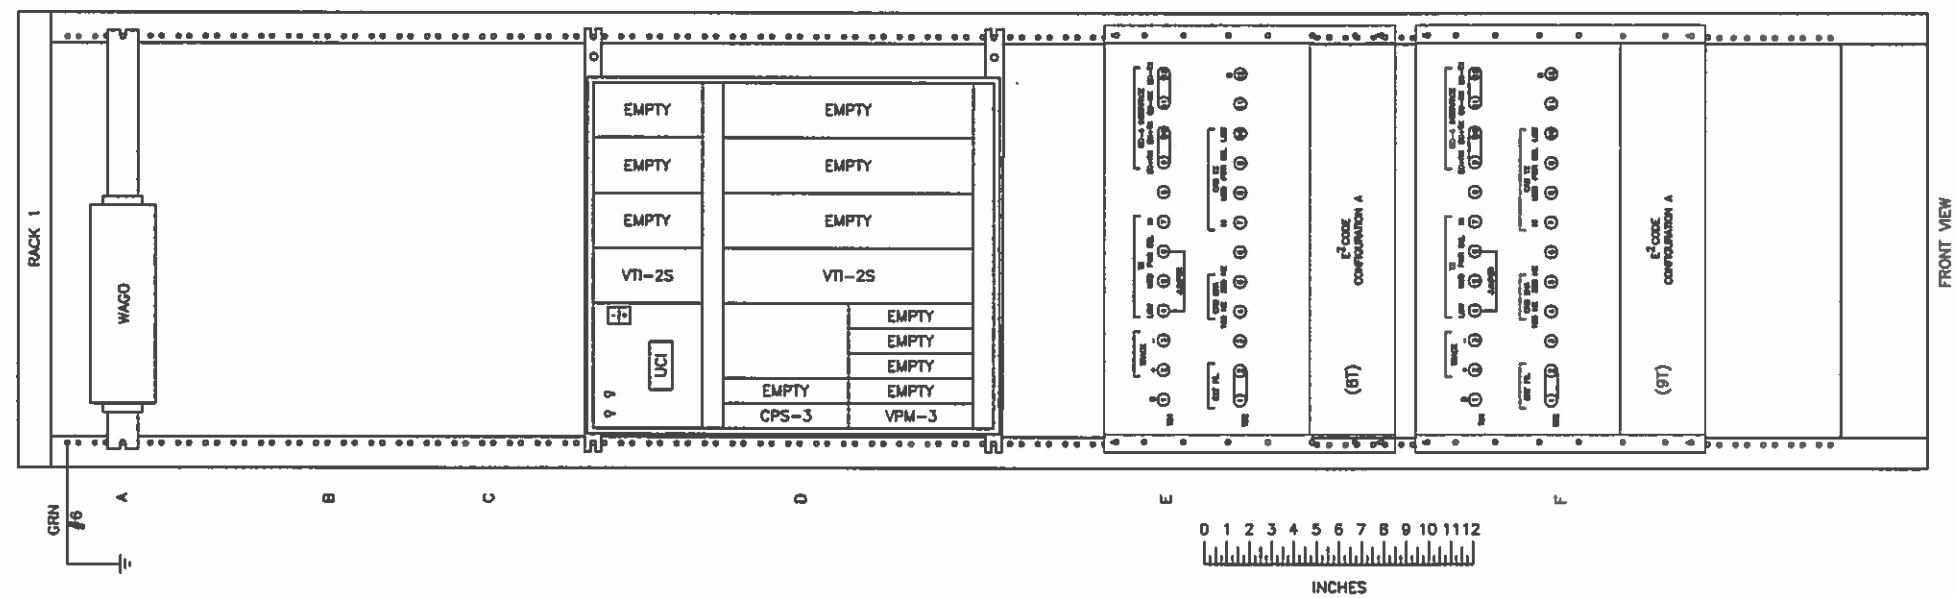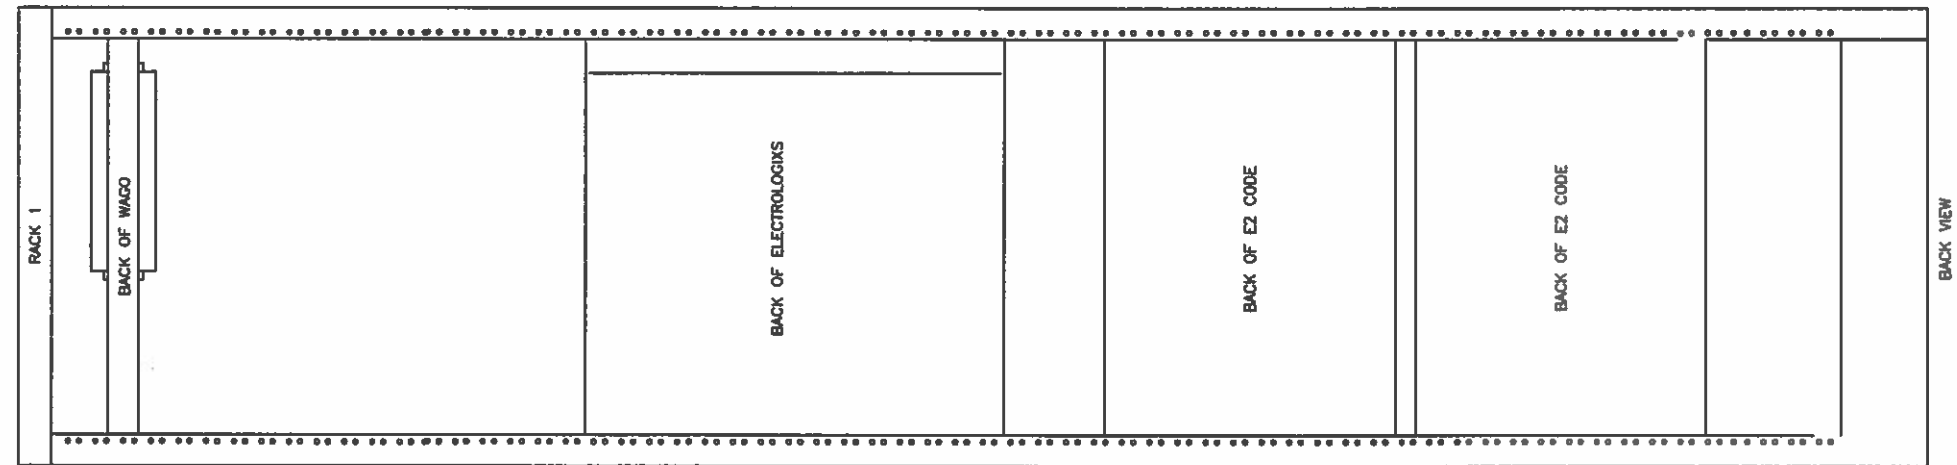

				Designed By:	BPC	TTCI TTT HOUSE T-7 RACK 1 LAYOUT	Scale:	NTS
				Drawn By:	BPC		CAD File Name:	T7009.DWG
				Checked By:	BDW		Submitted Date:	03/11/15
				Approved By:	AEB			
1	03/11/15	AS DESIGNED						
REV	DATE	DESCRIPTION						

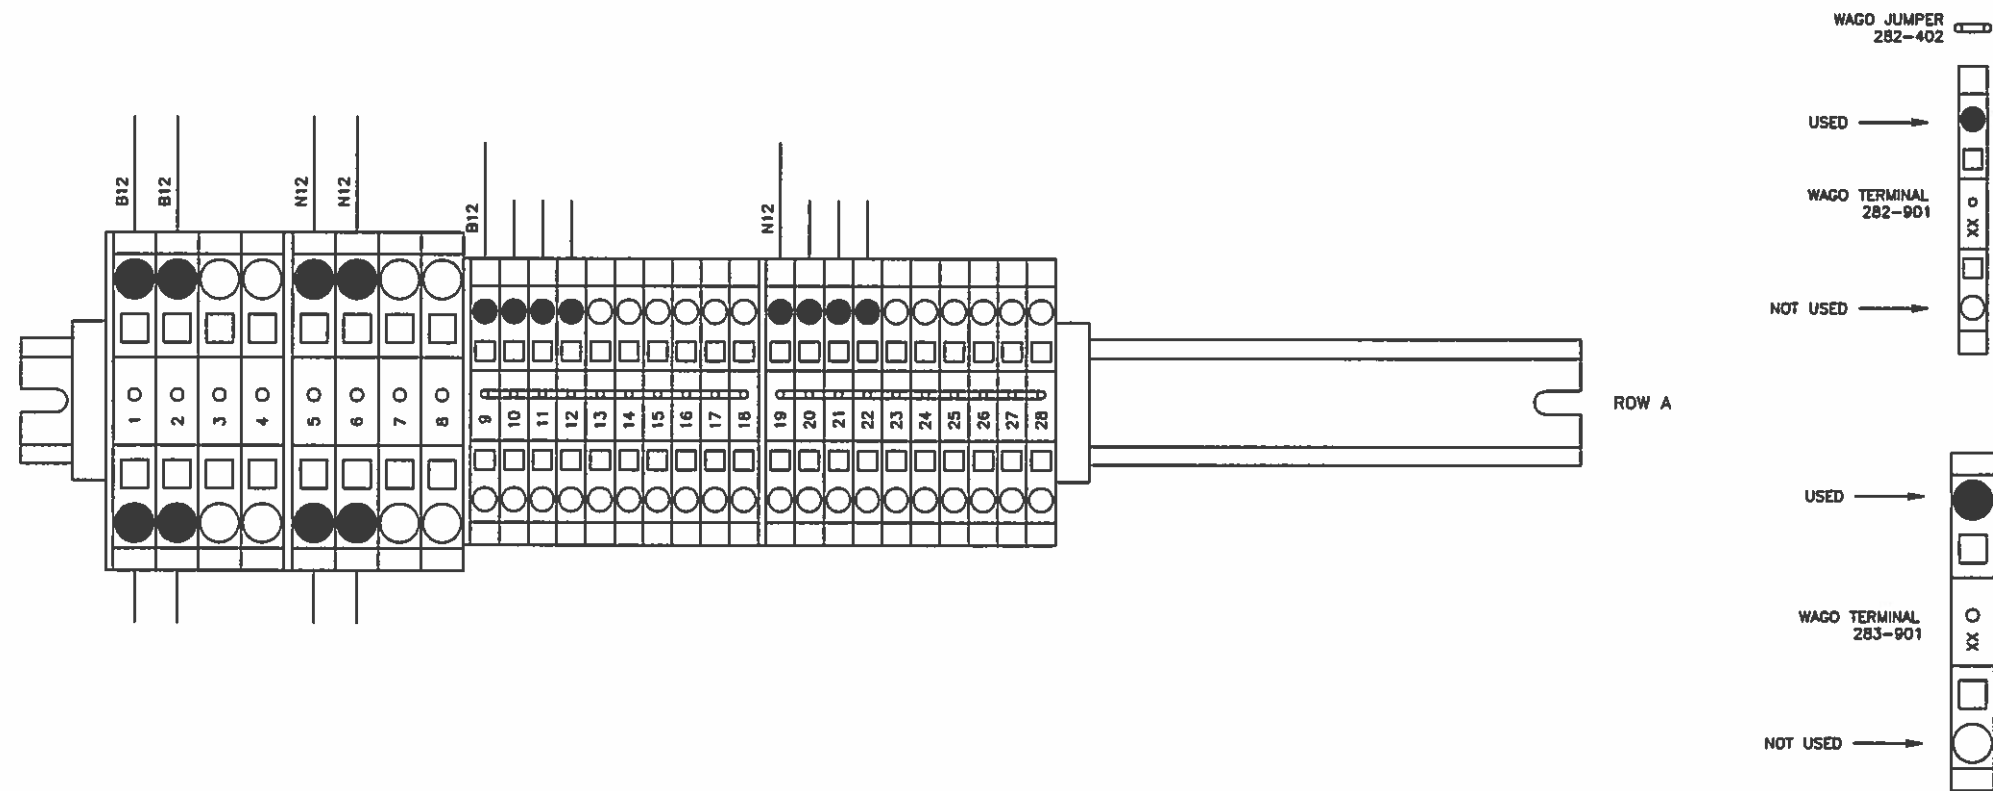

REV	DATE	DESCRIPTION
1	03/11/15	AS DESIGNED




Designed By:	BPC
Drawn By:	BPC
Checked By:	BDW
Approved By:	AEB

TTCI
TTT HOUSE T-7
WAGO & RELAY LAYOUT
RACK 1, ROW A & B


Scale:	NTS
CADD File Name:	T7010.DWG
Submitted Date:	03/11/15
Sheet No.	010

HOUSE T-8

					Designed By:	BPC	TTCI	Scale:	NTS
					Drawn By:	BPC		CADD File Name:	T8000.DWG
					Checked By:	BDW	TTT HOUSE T-8	Submitted Date:	03/11/15
					Approved By:	AEB	COVER SHEET		Sheet No.
1	03/11/15	AS DESIGNED							000
REV	DATE	DESCRIPTION							

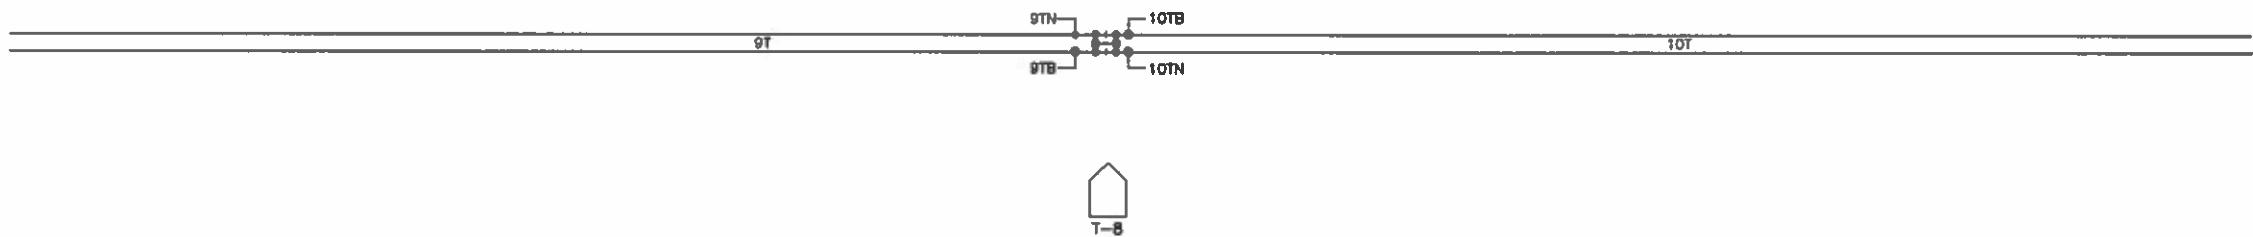

				Designed By: BPC Drawn By: BPC Checked By: BDW Approved By: AEB	TTCI TTT HOUSE T-8 TRACK & SIGNAL PLAN	Scale: NTS	
						CADD File Name: T8002.DWG	
						Submitted Date: 03/11/15	
1	03/11/15	AS DESIGNED				Sheet No. 002	
REV	DATE	DESCRIPTION					

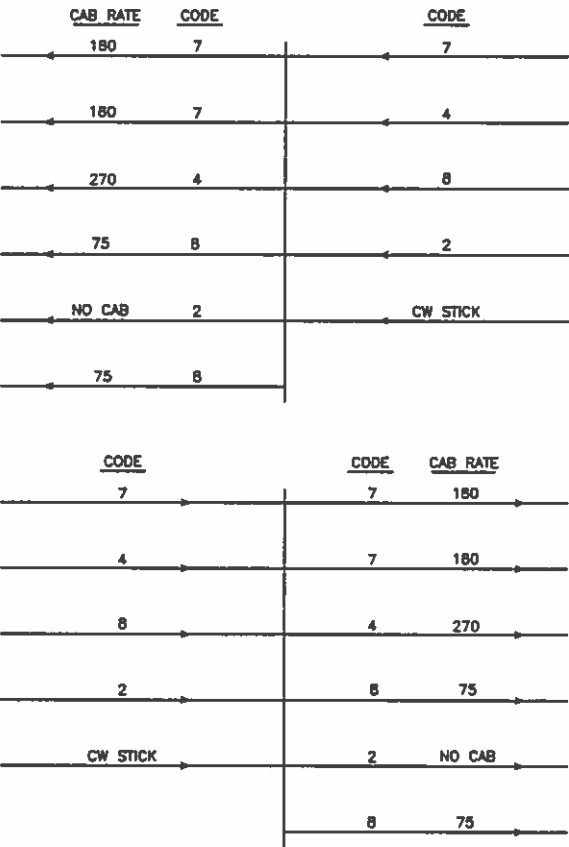

CODE

7

CODE

4

CODE

8

CODE

2

CW STICK

CODECAB RATE

7180

CODECAB RATE

7180

CODECAB RATE

4270

CODECAB RATE

875

CODECAB RATE



2NO CAB

CODECAB RATE

875

TTT CAB RATE TABLE		
NAME	DESIGNATOR	RATE
CLEAR	C	180
CAB SPEED	CS	270
APPROACH LIMITED	AL?	120
APPROACH	A	75
RESTRICTING	R	NO CAB

					Designed By: BPC	TTCI TTT HOUSE T-8 CODE & ASPECT CHART	Scale: NTS
					Drawn By: BPC		CADD File Name: T8003.DWG
					Checked By: BDW		Submitted Date: 03/11/15
					Approved By: AEB		Sheet No. 003
1	03/11/15	AS DESIGNED					
REV	DATE	DESCRIPTION					


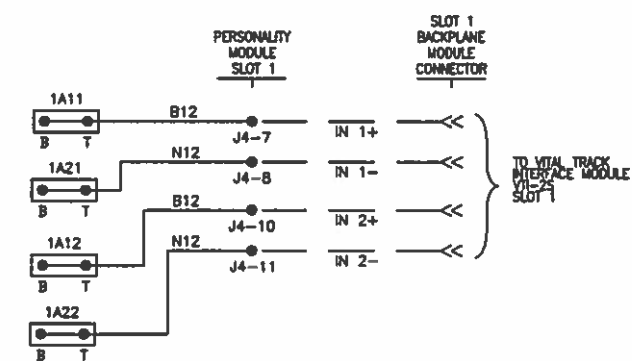
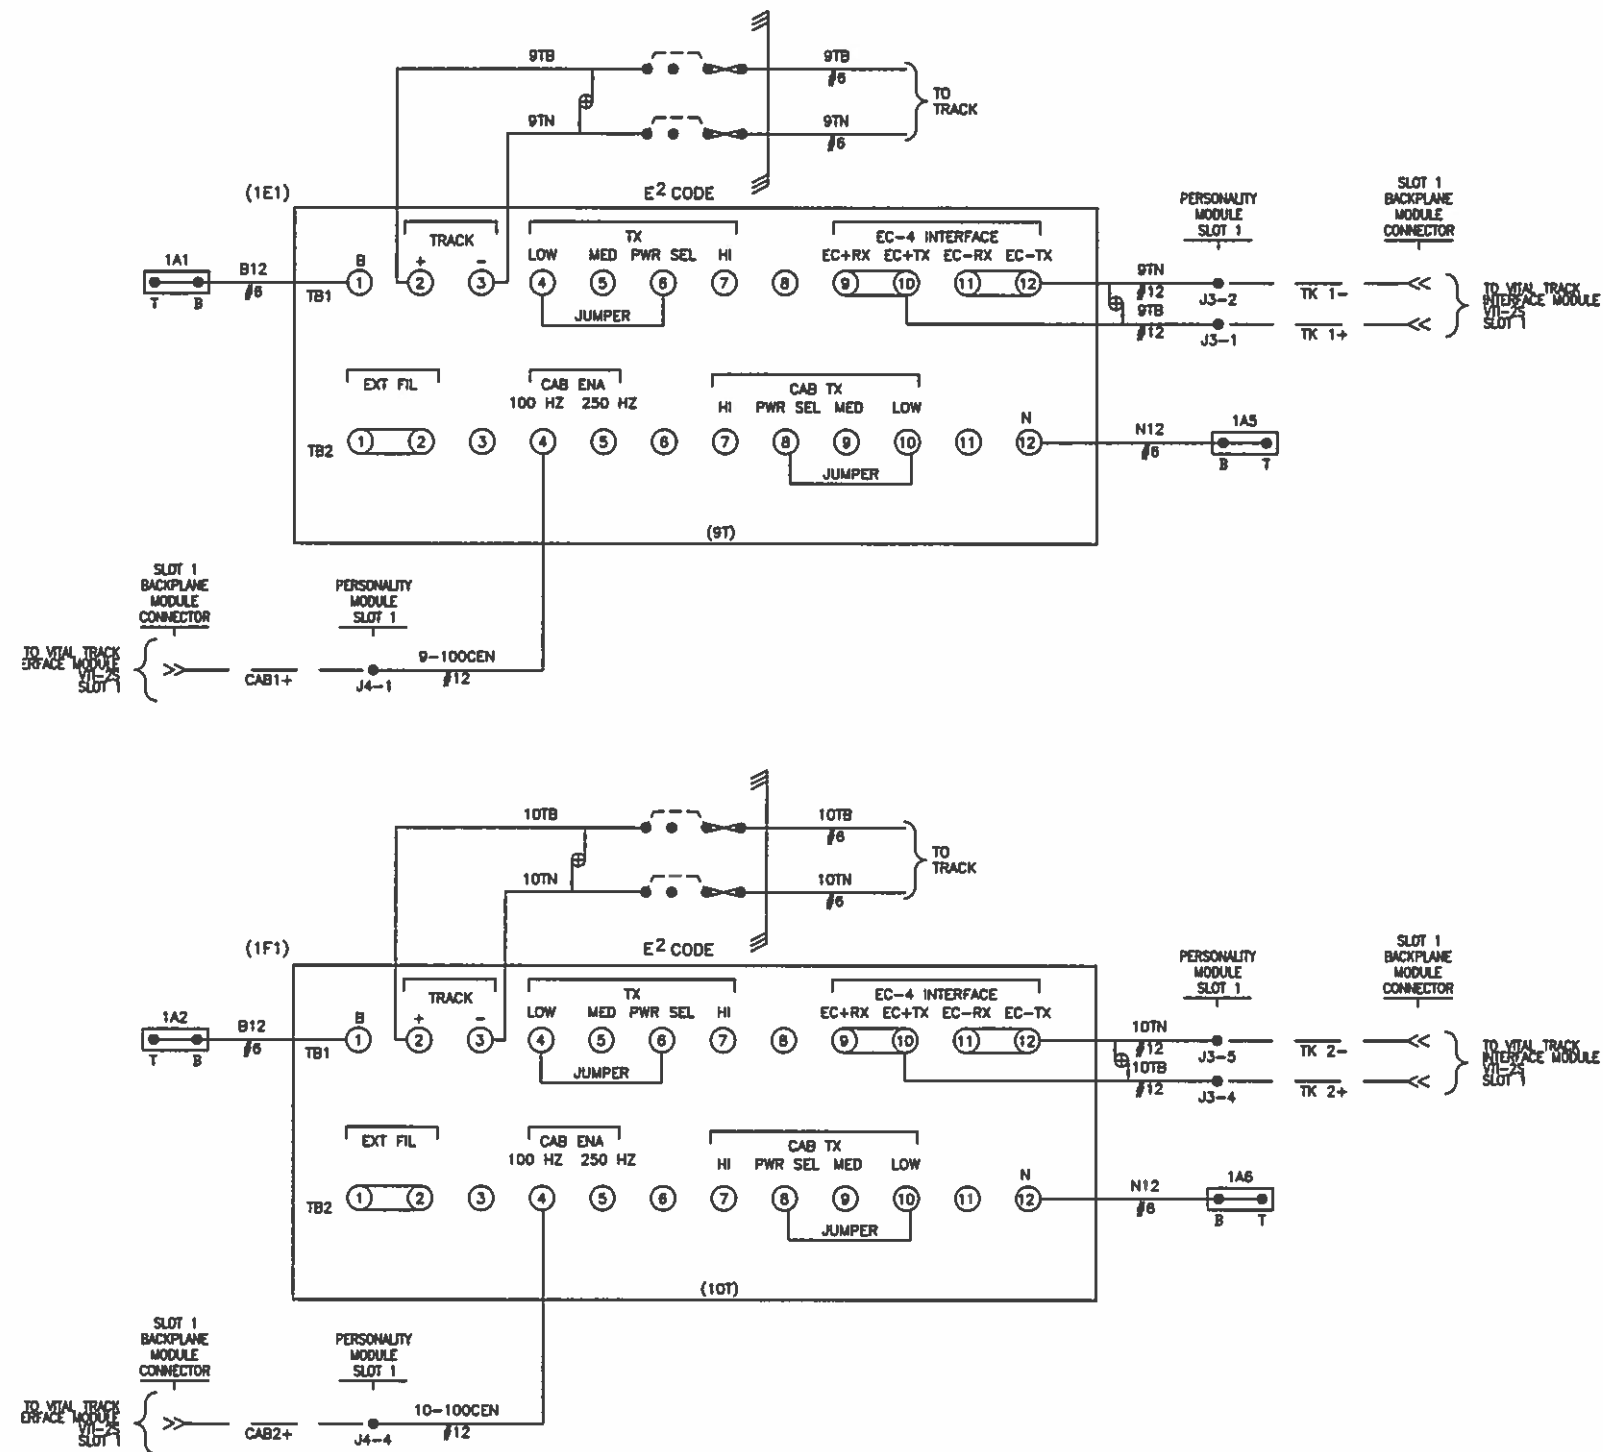


- NOTES:**
- 1) ALL WIRING ON THIS SHEET TO BE #10 AWG UNLESS OTHERWISE NOTED.
 - 2) TP = TWISTED PAIR 2 TURNS PER FOOT.
 - 3) ----- = INTERNAL CONNECTION

Designed By:	BPC	TTCI	Sheet No. NTS
Drawn By:	BPC	TTT HOUSE T-8	CADD File Name: TB004.DWG
Checked By:	BDW	TRACK CIRCUITS	Submitted Date: 03/11/15
Approved By:	AEB		Sheet No. 004

REV	DATE	DESCRIPTION
1	03/11/15	AS DESIGNED



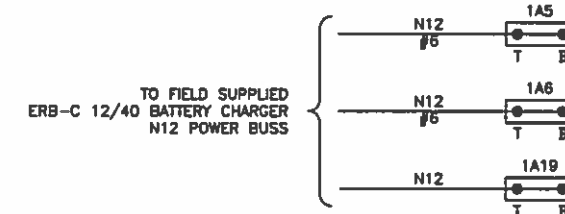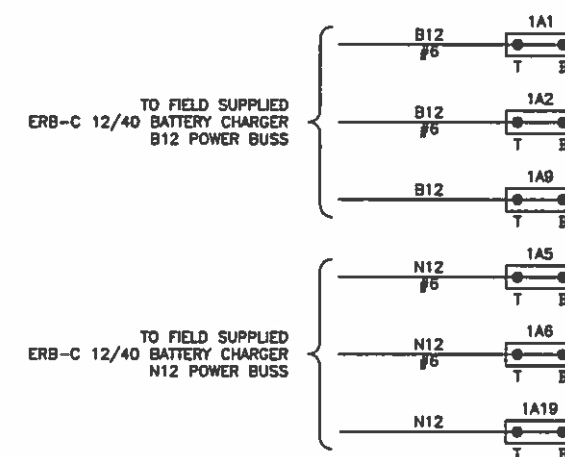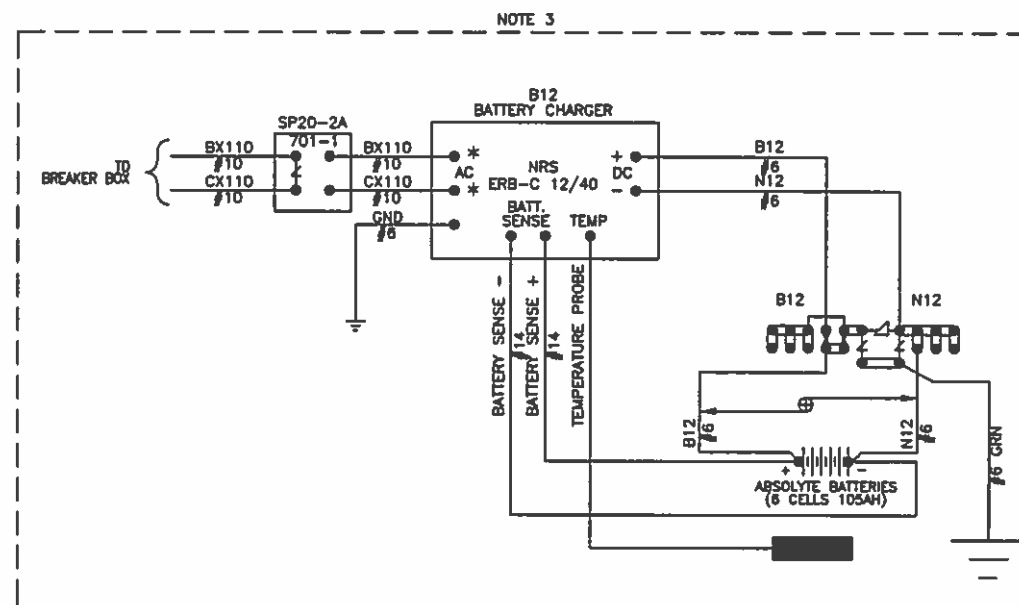

NOTES:

- 1) ALL SIGNAL WIRING ON THIS SHEET TO BE #10 AWG
UNLESS OTHERWISE NOTED.
2)  = TWISTED PAIR 2 TURNS PER FOOT.
3) FIELD SUPPLIED

1	03/11/15	AS DESIGNED
REV	DATE	DESCRIPTION

The logo features the GE monogram in a circle, followed by "GETS" in large bold letters and "Global Signaling" in a script font below it.

Designed By:	BPC
Drawn By:	BPC
Checked By:	BDW
Approved By:	AEB

TTCI

TTT HOUSE T-8

POWER DISTRIBUTION CIRCUITS

Suite:	NTS
CADD File Name:	T8005.DWG
Submitted Date:	03/11/15
Sheet No.	005


VTI-2S
PERSONALITY
MODULE
(SLOT 1)

TK 1+	9TB	X	1
TK 1-	9TN	X	2
			3
TK 2+	10TB	X	4
TK 2-	10TN	X	5
			6
			7





J3

CAB1+	9-100CEN	X	1
CAB1-			2
			3
CAB2+	10-100CEN	X	4
CAB2-			5
			6
IN 1+	B12	X	7
IN 1-	N12	X	8
			9
IN 2+	B12	X	10
IN 2-	N12	X	11


J4

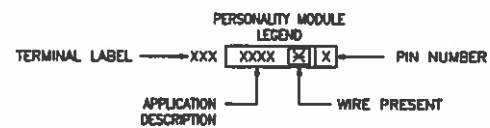

					Designed By: BPC	TTCI TTT HOUSE T-8 ELECTROLOGIXS 4-SLOT MODULE CONNECTOR USAGE	Scale: NTS
					Drawn By: BPC		CADD File Name: T8006.DWG
					Checked By: BDW		Submitted Date: 03/11/15
					Approved By: AEB		Sheet No. 006
1	03/06/15	AS DESIGNED					
REV	DATE	DESCRIPTION					

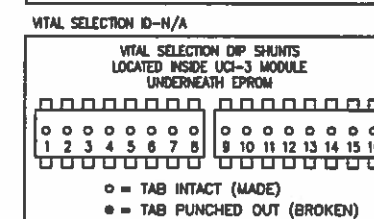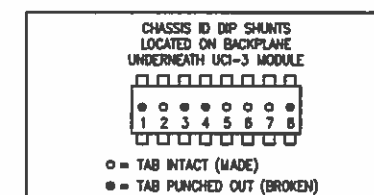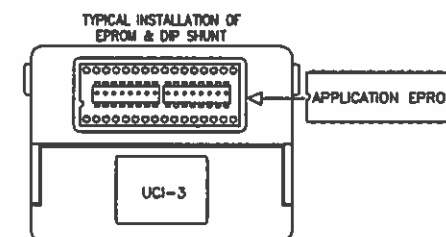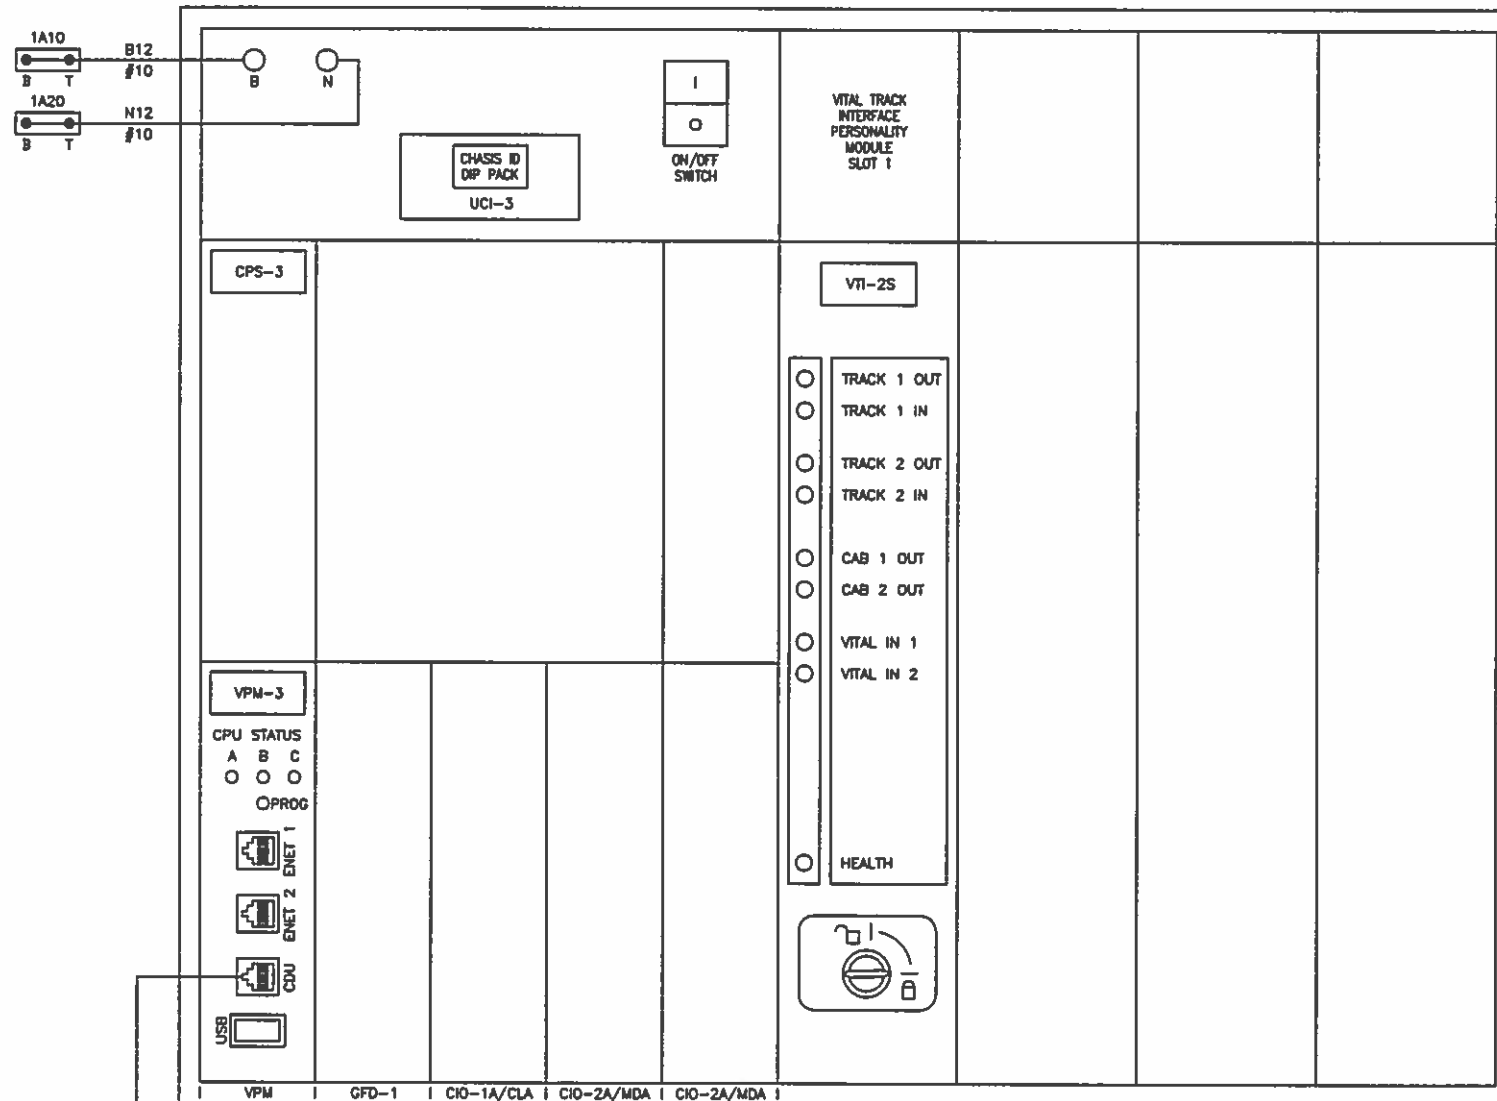

- NOTES:
- CDU-1 = CONTROL DISPLAY UNIT
 - CPS-3 = CENTRAL POWER SUPPLY
 - VPM-3 = VITAL PERIPHERAL MASTER MODULE
 - UCI-3 = CHASSIS INFORMATION MODULE
 - VTI-2S = VITAL TRACK INTERFACE
 - VLD-R16S = VITAL LAMP DRIVER MODULE
 - VO-86S = VITAL INPUTS/OUTPUTS
 - CIO-CLA = COMMUNICATION INPUT/OUTPUT CURRENT LOOP ADAPTER

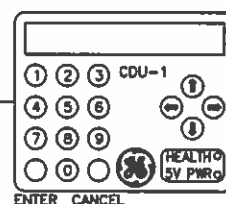

APPLICATION SOFTWARE INFORMATION	
NAME	
REV.	
CHECKSUM	
CRC	

Designed By:	BPC	TTCI	Scale:	NTS
Drawn By:	BPC		CADD File Name:	TB007.DWG
Checked By:	BDW		Submitted Date:	03/11/15
Approved By:	AEB		Sheet No.	007
		TTT HOUSE T-8		
		ELECTROLOGIXS 4-SLOT HARDWARE CONFIGURATION		


REV	DATE	DESCRIPTION
1	03/11/15	AS DESIGNED




SYSTEM CONFIGURATION				
DATE/TIME	SETTING MADE WHEN USING PTC CONFIGURATION			
DIAGNOSTIC PORT				
ETHERNET CONFIG.				
OFFICE CONFIG	NA			
LCP CONFIG	ENABLED	TRUE		
VITAL REMOTE CONFIG	LOCAL PORT	REMOTE PORT	REMOTE PORT CONFIG	
	ETHERNET PORT 1 192.168.40.78	NA	NA	NA
	ETHERNET PORT 2 192.168.1.12	NA	NA	NA
	SERIAL PORT 2	NA		
	SERIAL PORT 3	NA		
TRACK CONFIG	SLOT	TRACK	CONFIGURATION	
	SLOT 1: 9T_T11	1	TRANSMITTER	4V
			RECEIVER	0.5A
			CODE 5 TYPE	ALT 5
	SLOT 1: 10T_T11	2	TRANSMITTER	4V
			RECEIVER	0.5A
			CODE 5 TYPE	ALT 5

NOTES:
1. FINAL VITAL CONFIGURATION SETTINGS ARE SUBJECT TO CHANGE IN ACCORDANCE WITH SOFTWARE UPGRADES. FINAL VITAL CONFIGURATION SETTINGS TO BE UPDATED ON AS-IN-SERVICE.

					Designed By: BPC	TTCI TTT HOUSE T-8 ELECTROLOGIXS 4-SLOT CONFIGURATION SETTINGS	Scale: NTS
					Drawn By: BPC		CADD File Name: T8008.DWG
					Checked By: BDW		Submitted Date: 03/11/15
					Approved By: AEB		
1	03/11/15	AS DESIGNED					Sheet No. 008
REV	DATE	DESCRIPTION					

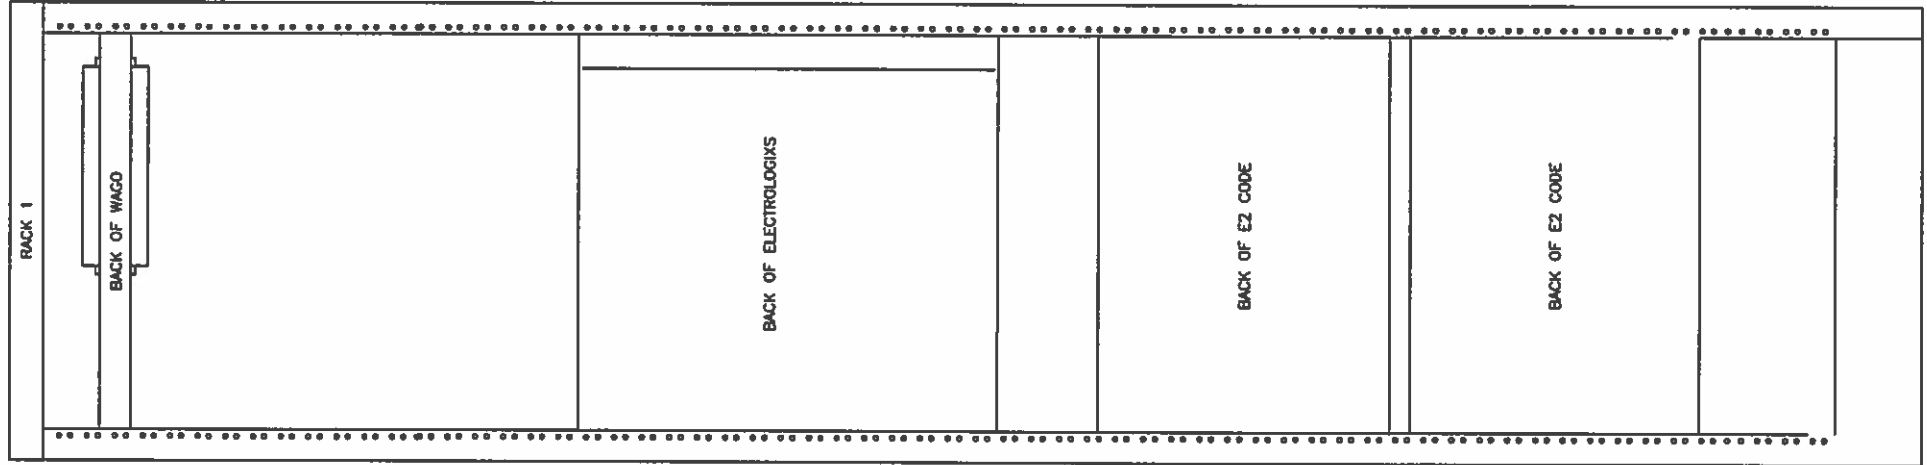


DD

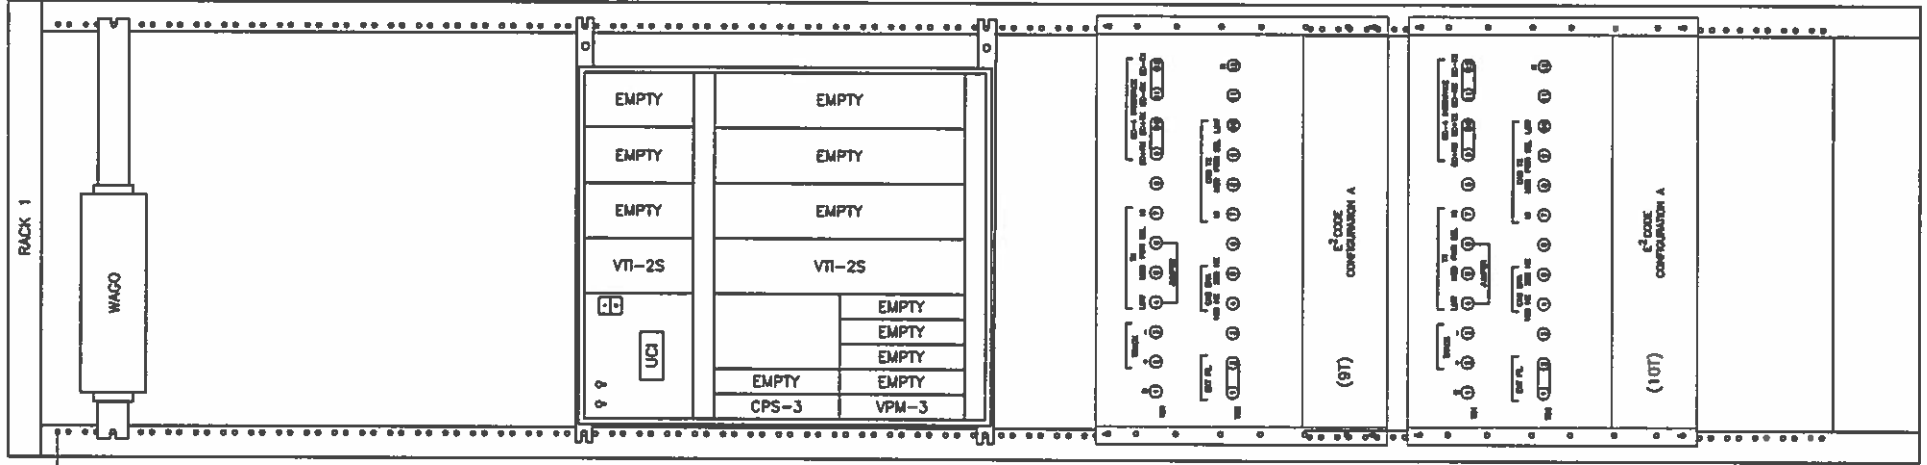

GRN 1/8



				Designed By:	BPC	TTCI	Scale:	NTS
				Drawn By:	BPC		CADD File Name:	T8009.DWG
				Checked By:	BDW		Submitted Date:	03/11/15
				Approved By:	AEB			
1	03/11/15	AS DESIGNED					TTT HOUSE T-8	
REV	DATE	DESCRIPTION			RACK 1 LAYOUT		Sheet No.	009

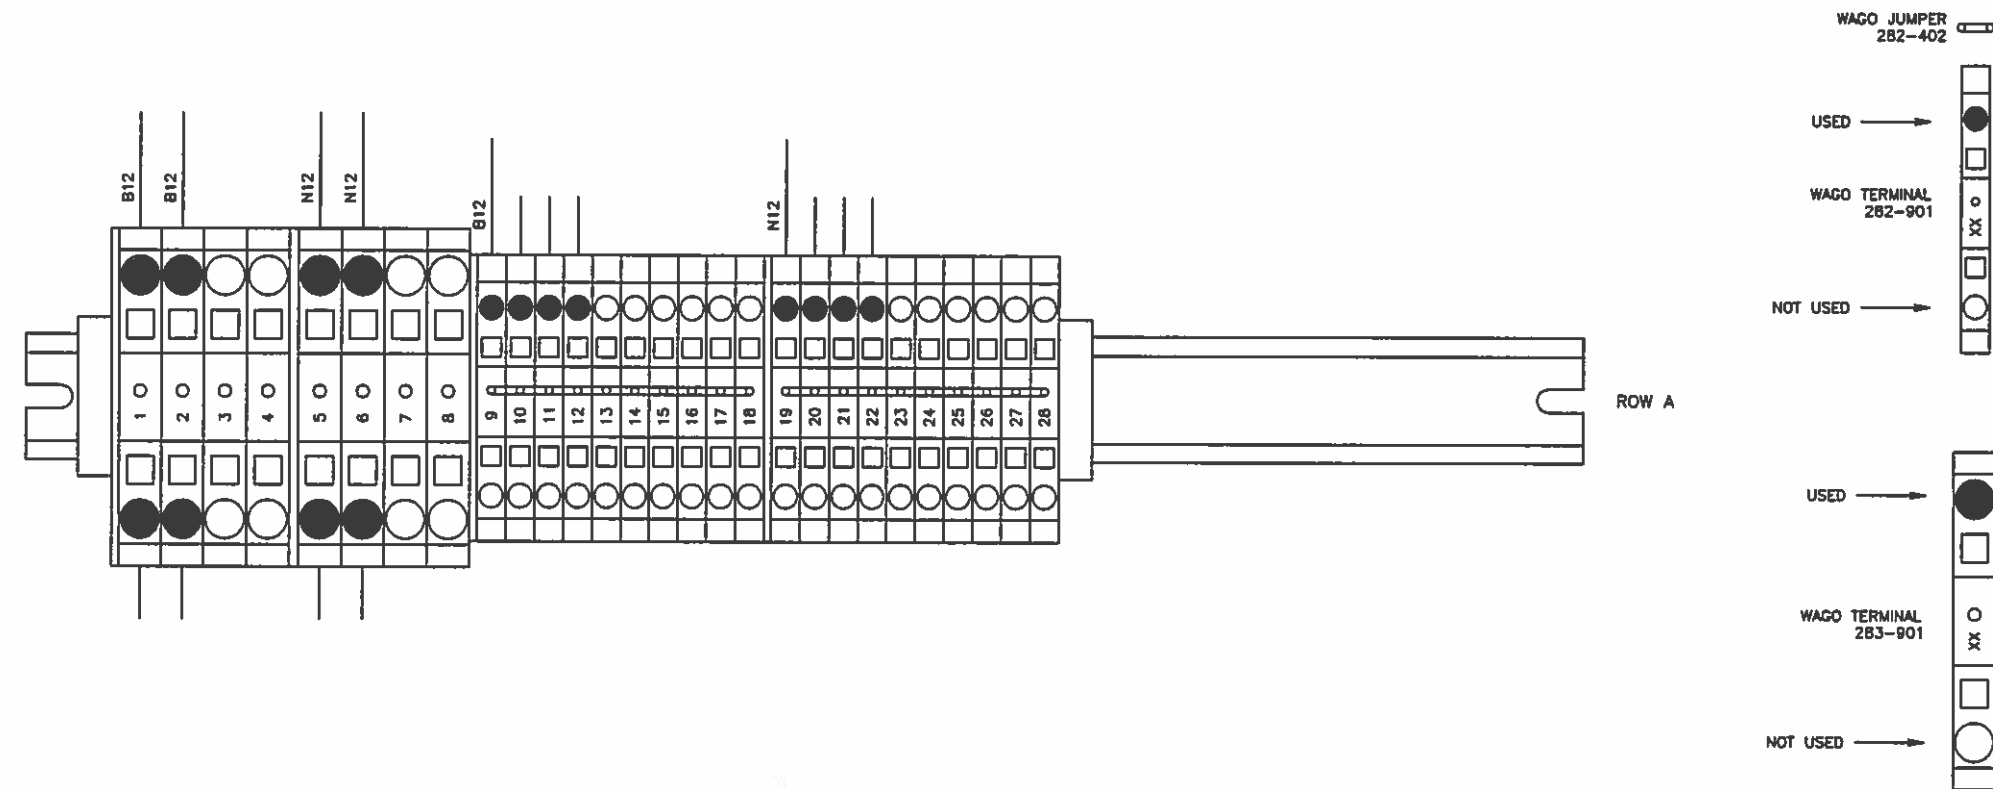

				Designed By:	BPC	TTCI TTT HOUSE T-8 WAGO & RELAY LAYOUT RACK 1, ROW A & B	Scale:	NTS
				Drawn By:	BPC		CADD File Name:	T8010.DWG
				Checked By:	BDW		Submitted Date:	03/11/15
				Approved By:	AEB			
1	03/11/15	AS DESIGNED						
REV	DATE	DESCRIPTION						Sheet No. 010